



Samblyktáttir  
 01 OCT 2012  
 Byggingafræðingur  
 F.h. Sigurður Steinarsson

Níðri Indriðsson  
 Kt. 181144-3949  
 NI

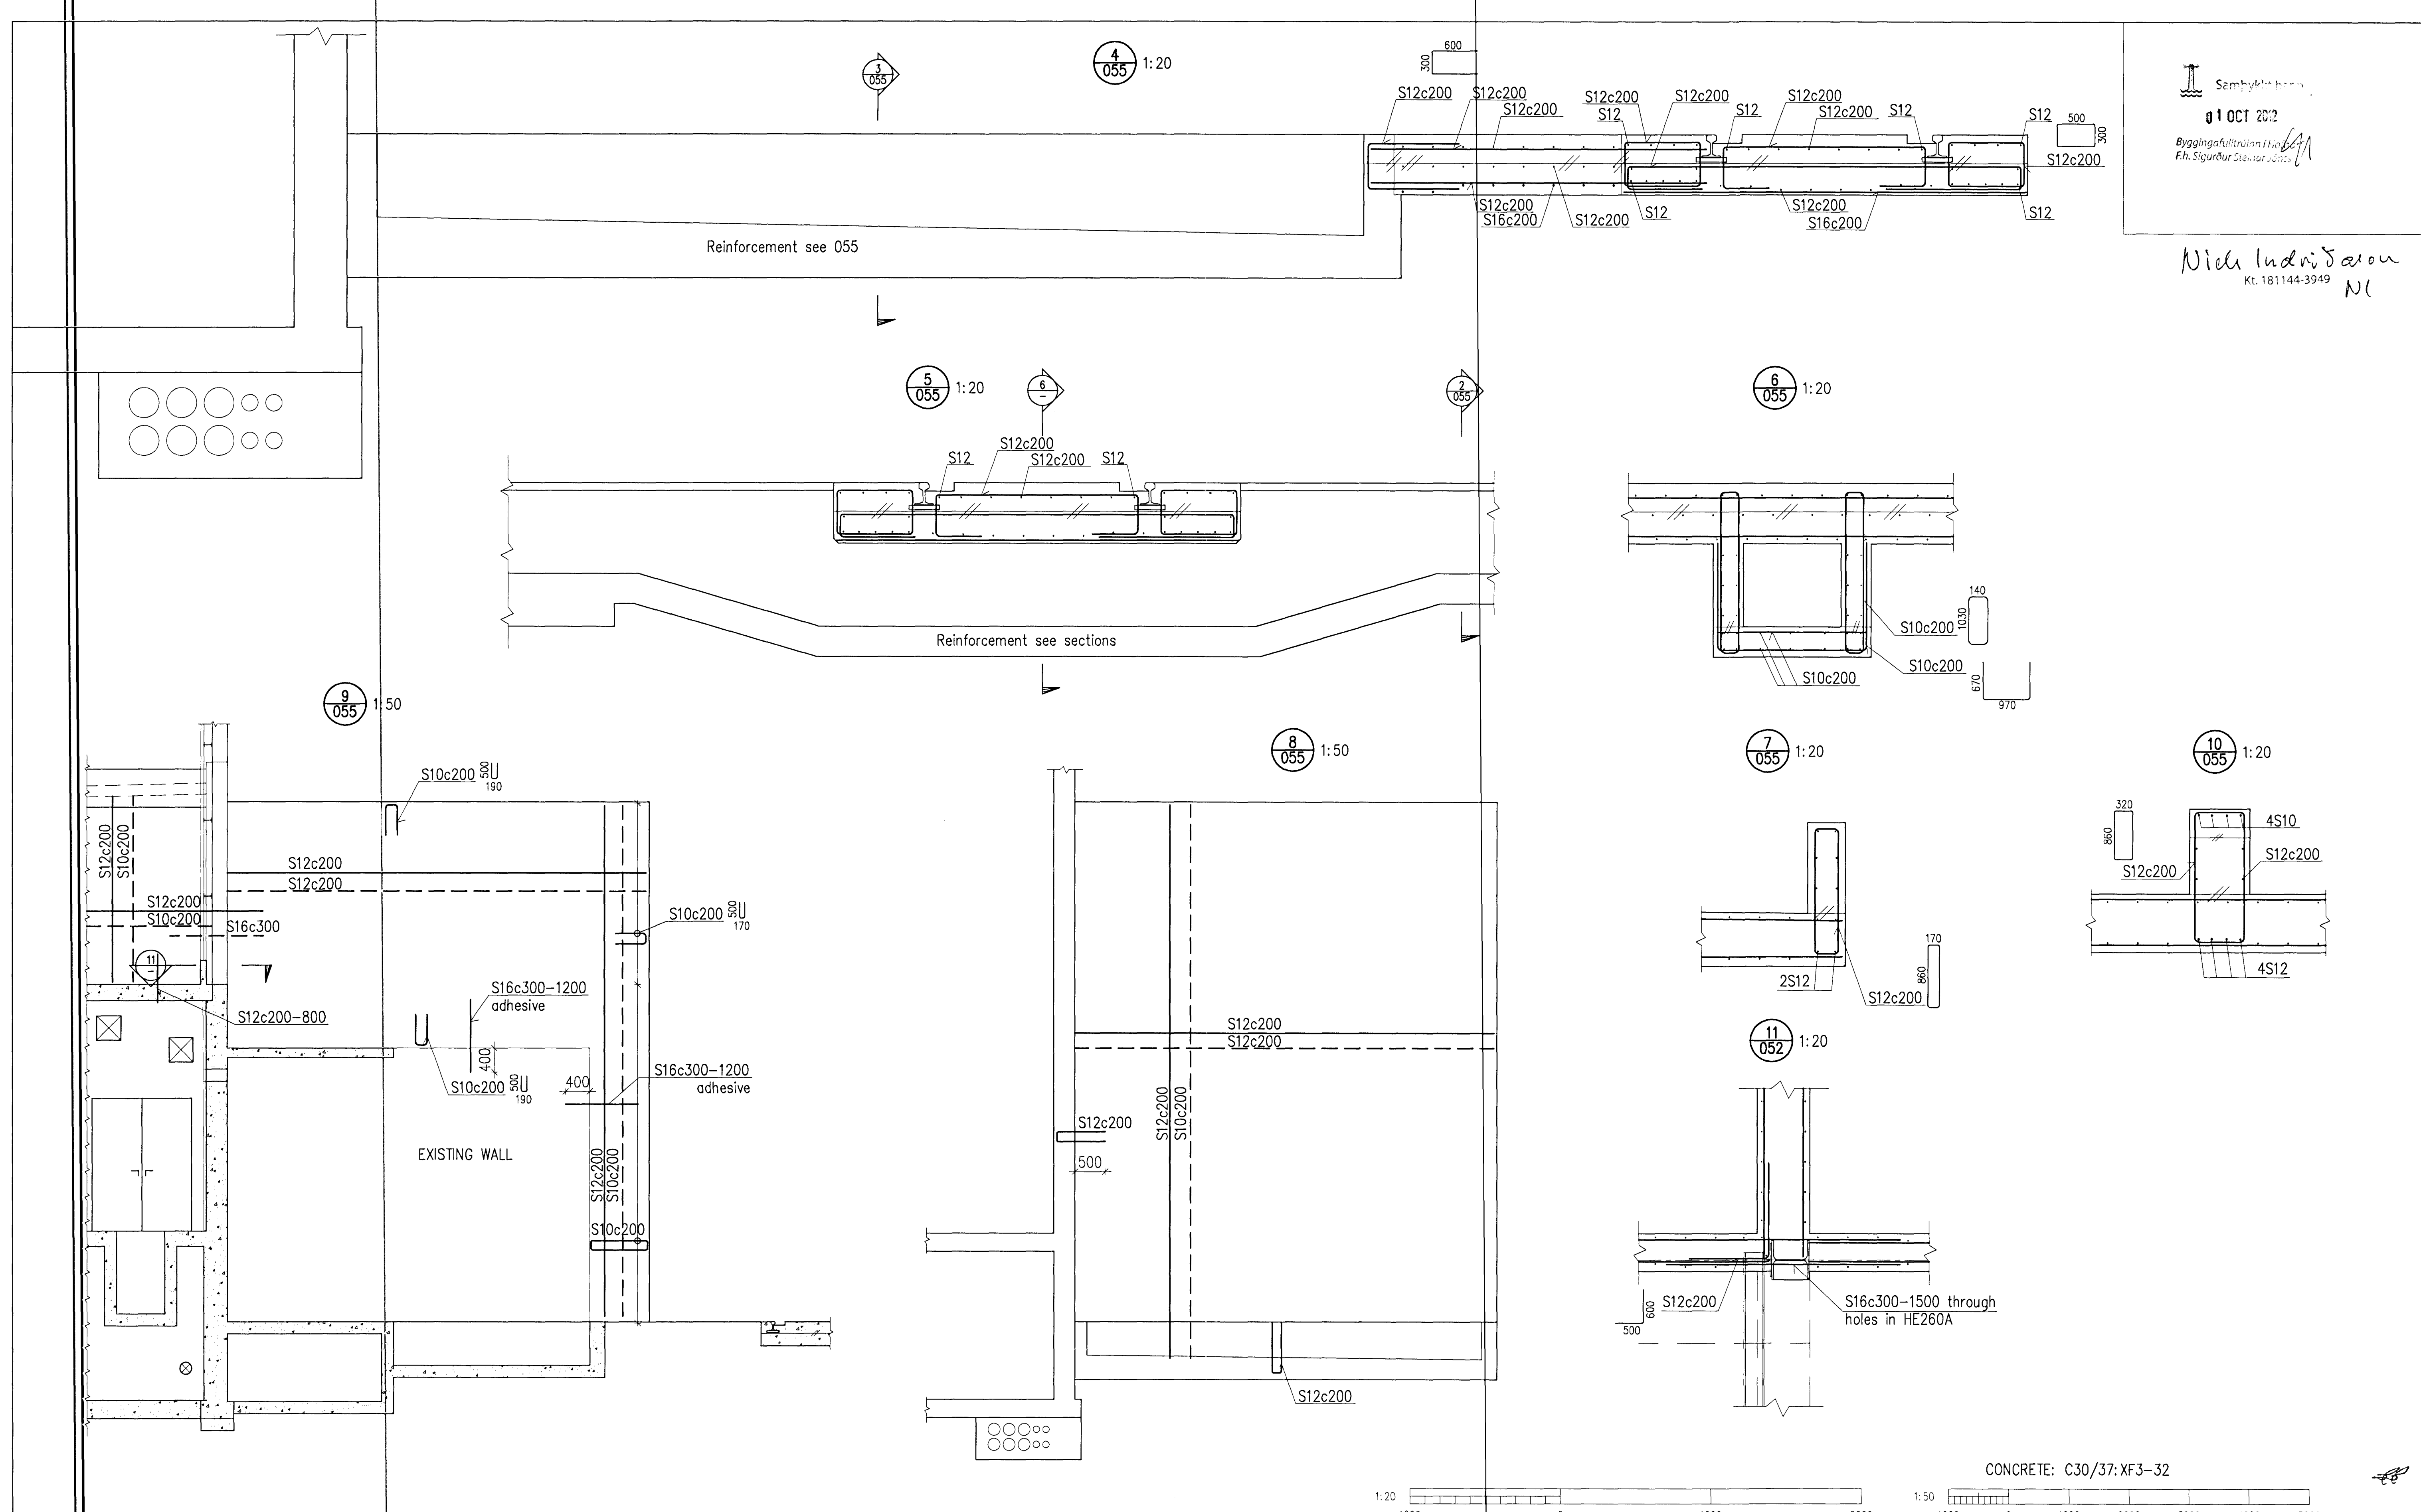

CONCRETE: C30/37:XF3-32

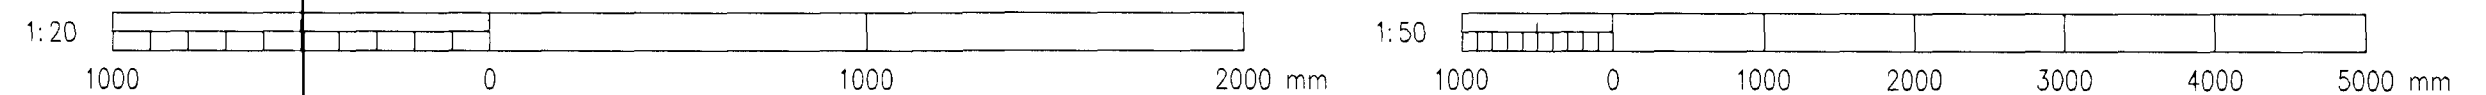

Skýringar Legend:	This drawing is the property of Rio Tinto Alcan Iceland Ltd. and handed out for personal use only. It may neither be copied nor made available to others without permission of Rio Tinto Alcan Iceland Ltd. The receiver is liable for any misuse.							Dagsetning / Date: 2008.10.01 Hönnuð / Designed: HS Teikn / Drawn: LDB Verktaki / Supplier: HRV		Flakur nr.: Blað nr.: 4011 01188		
	18 Record Drawing 2012.06.11 HS NI EAG rev. 2							Tekn.nr./verktaki / Supplier drwg.no: IDP-410-CA-015-056 Samþykkt / Approved: NI Yfirf. / Chkd: NI		IPU 410 - SUBSTATION 220 kV SWITCHYARD BLD. TRANSFORMER BAYS 2/2 REINFORCEMENT RioTintoAlcan ISAL Alcan Iceland Ltd Stæmsvík IS-222 Hafnarfordur Ísland		ISAL Tekn.nr. ISAL / Drwg.no of ISAL 251232 Breyt./Rev. A