



Samþykkt þann
 01 OCT 2012
 Byggingafráttir / Hafnarfróð
 F.h. Sigurður Steinar Jónsson

Níels Indriðason
 Kt. 181144-3949
 NI

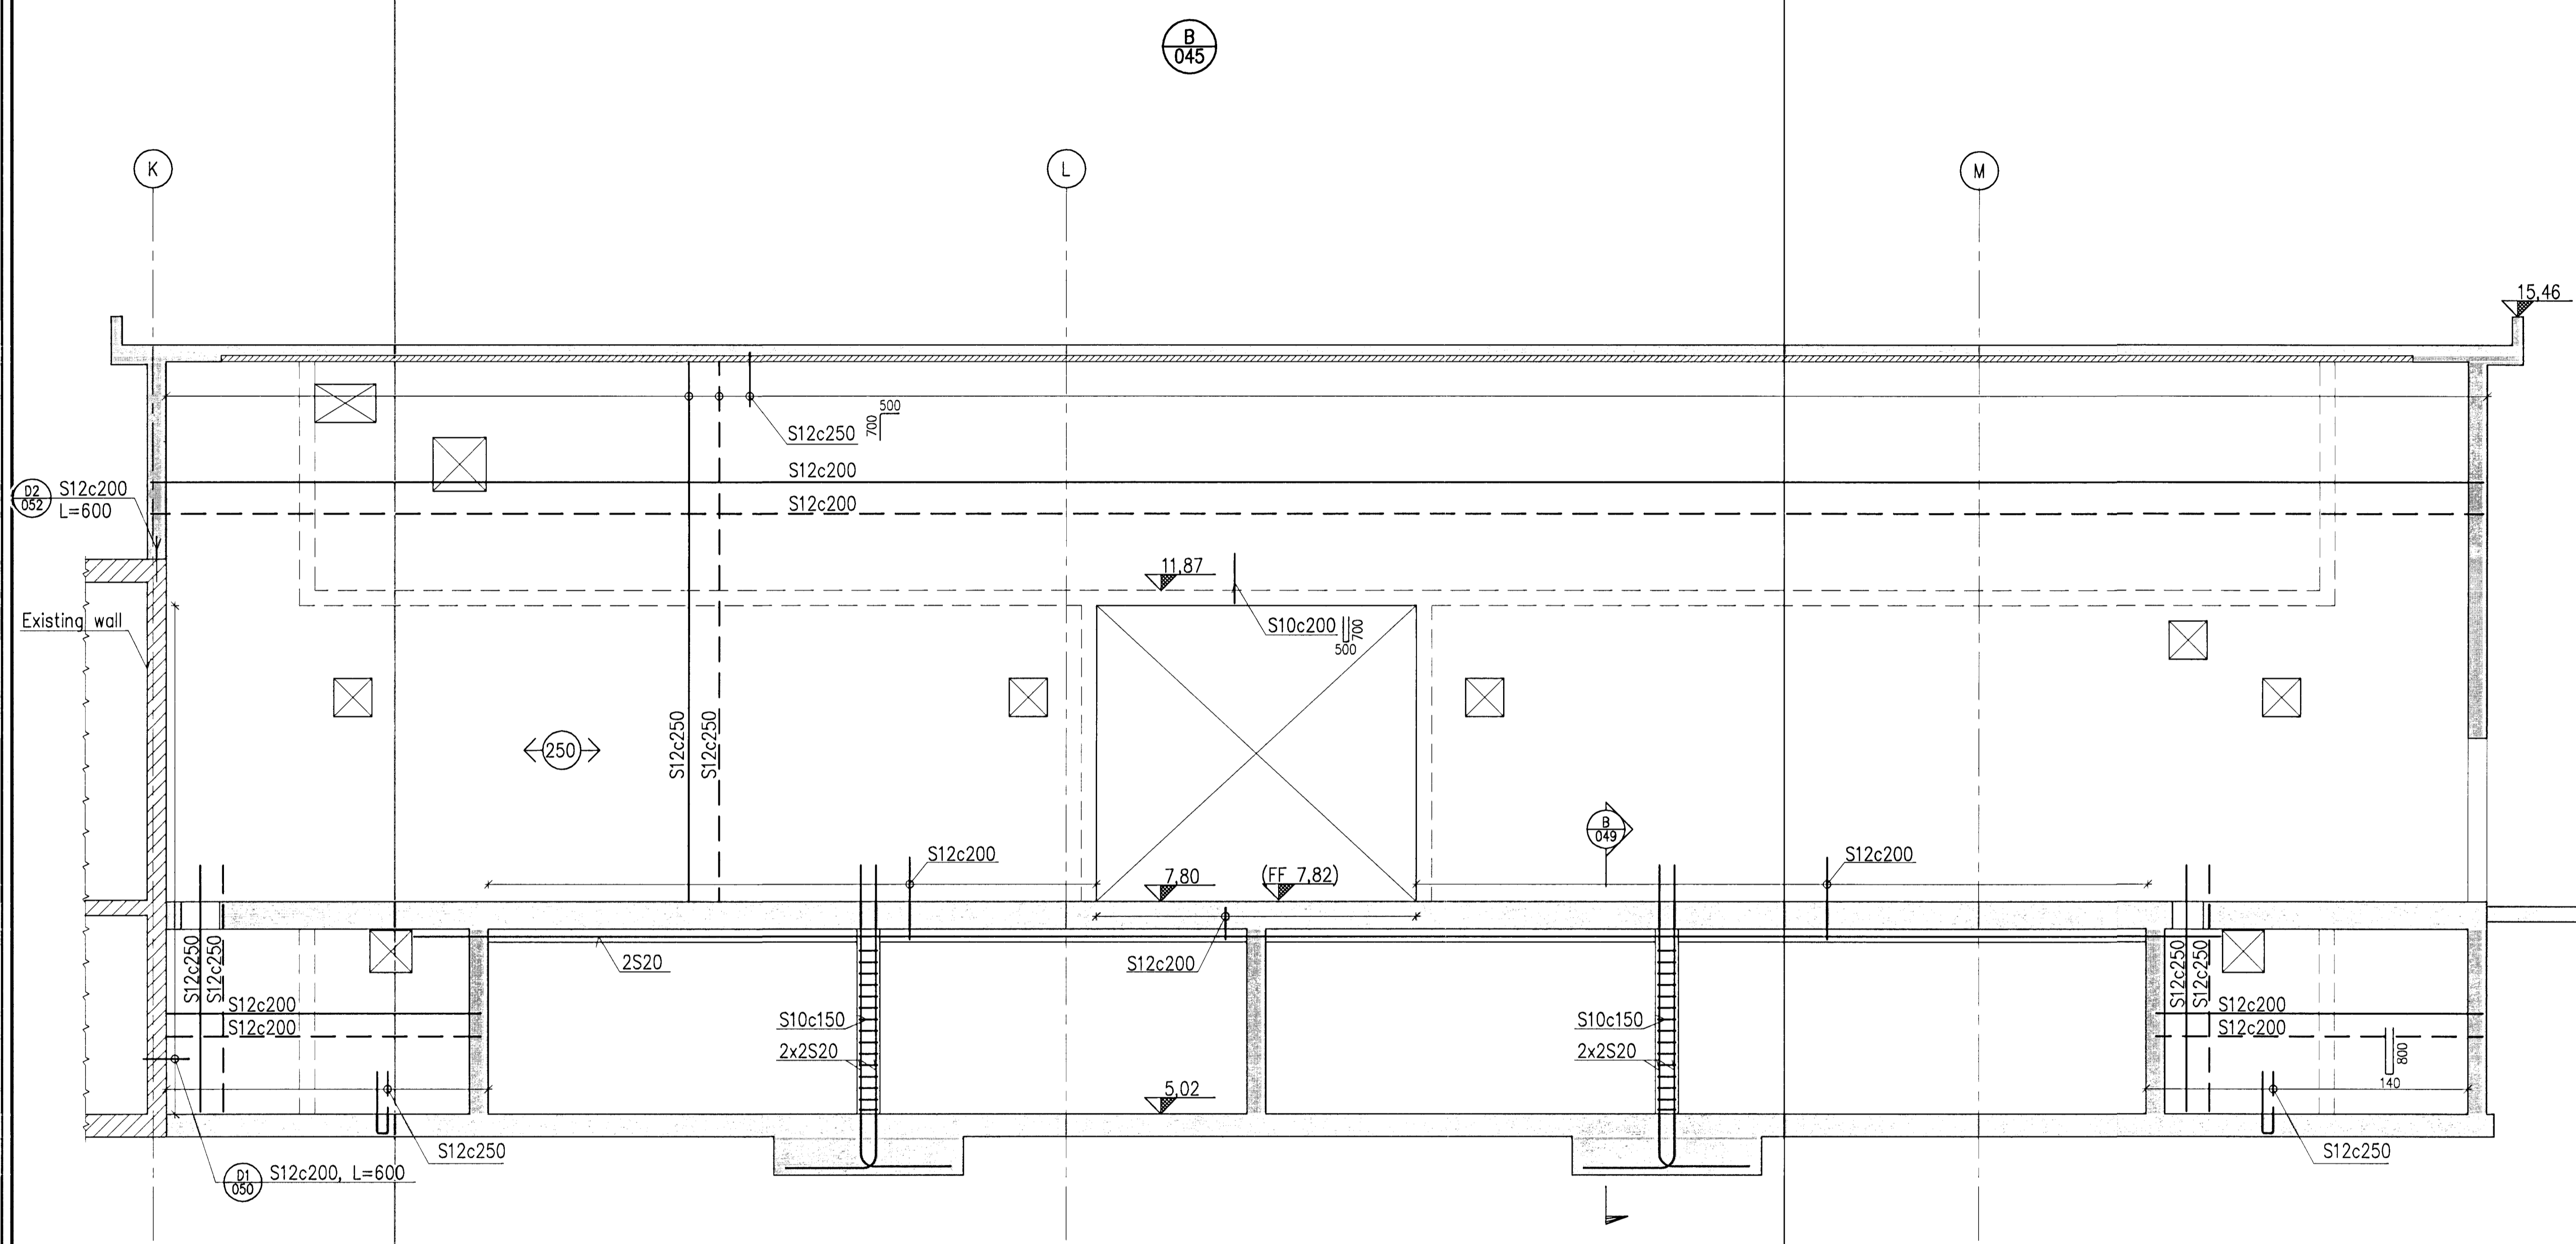

CONCRETE: C30/37:XF3-32

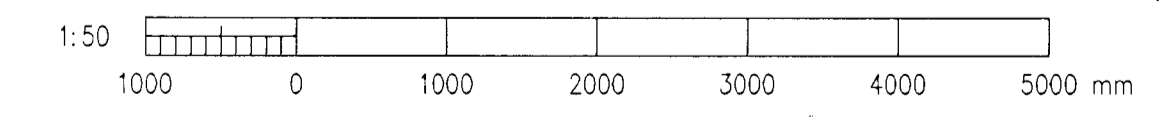

Skýringar
 Legend

C:\DP\01\DP\400 - Reduction\410 Substation\Drawings\Civil\DP-410-CA-015-051.dwg

Útg nr / Rev no	Lýsing / Description	Dagsetning / Date	Hug/Út / Des/Dw	Yfirt / Chkd	Notk heim / Suppl Rel	Notk heim / ISAL Rel
15	Record Drawing	2012.06.11	HS	NI	AFV	AFV

This drawing is the property of Rio Tinto Alcan Iceland Ltd. and handed out for personal use only. It may neither be copied nor made available to others without permission of Rio Tinto Alcan Iceland Ltd. The receiver is liable for any misuse.

Format: A1
 Mkv.: Scale: 1:50
 Dimensions without tolerances according to ISO 2768-1 medium.



Dagsetning / Date	2008.10.01
Hannað / Designed	HS
Teikn / Drawn	AFV
Verktaki / Supplier	HRV
Teikn.nr.verktaka / Supplier drw.no.	IDP-410-CA-015-051
Samh.átt / Approved	NI
Yfirt / Chkd	NI
Skiluti af / Part of:	

IPU 410 - SUBSTATION
 60 kV SWITCHGEAR BLD.
 WALLS SIDE VIEW 2/4
 Teg. teikningar / Dwg. type: REINFORCEMENT

Flökkur nr.:	Blöð nr.:	Næsta bl. nr.:
Kostn. nr. - Cono. / Bón. nr. - Eq. no	4011 / 01188	
AKS	UB01	
Teikn. nr. ISAL / Drw. no. of ISAL	251228	
Breyt./Rev.	A	

Rio Tinto Alcan
 ISAL
 Akranesvegur 18-222
 101 Reykjavík
 Ísland

ISAL Yfirbú og skráð, dags / ISAL Checkd, date
 ISAL Samþykkt, dags / ISAL Approved, date