


Samþykkt þann  
 01 OCT 2012  
 Byggingafulltrúinn í Hafnarhöfði  
 E.h. Sigurður Steinar Jónsson

Níels Indriðason NI 1:20  
 Kt. 181144-3949

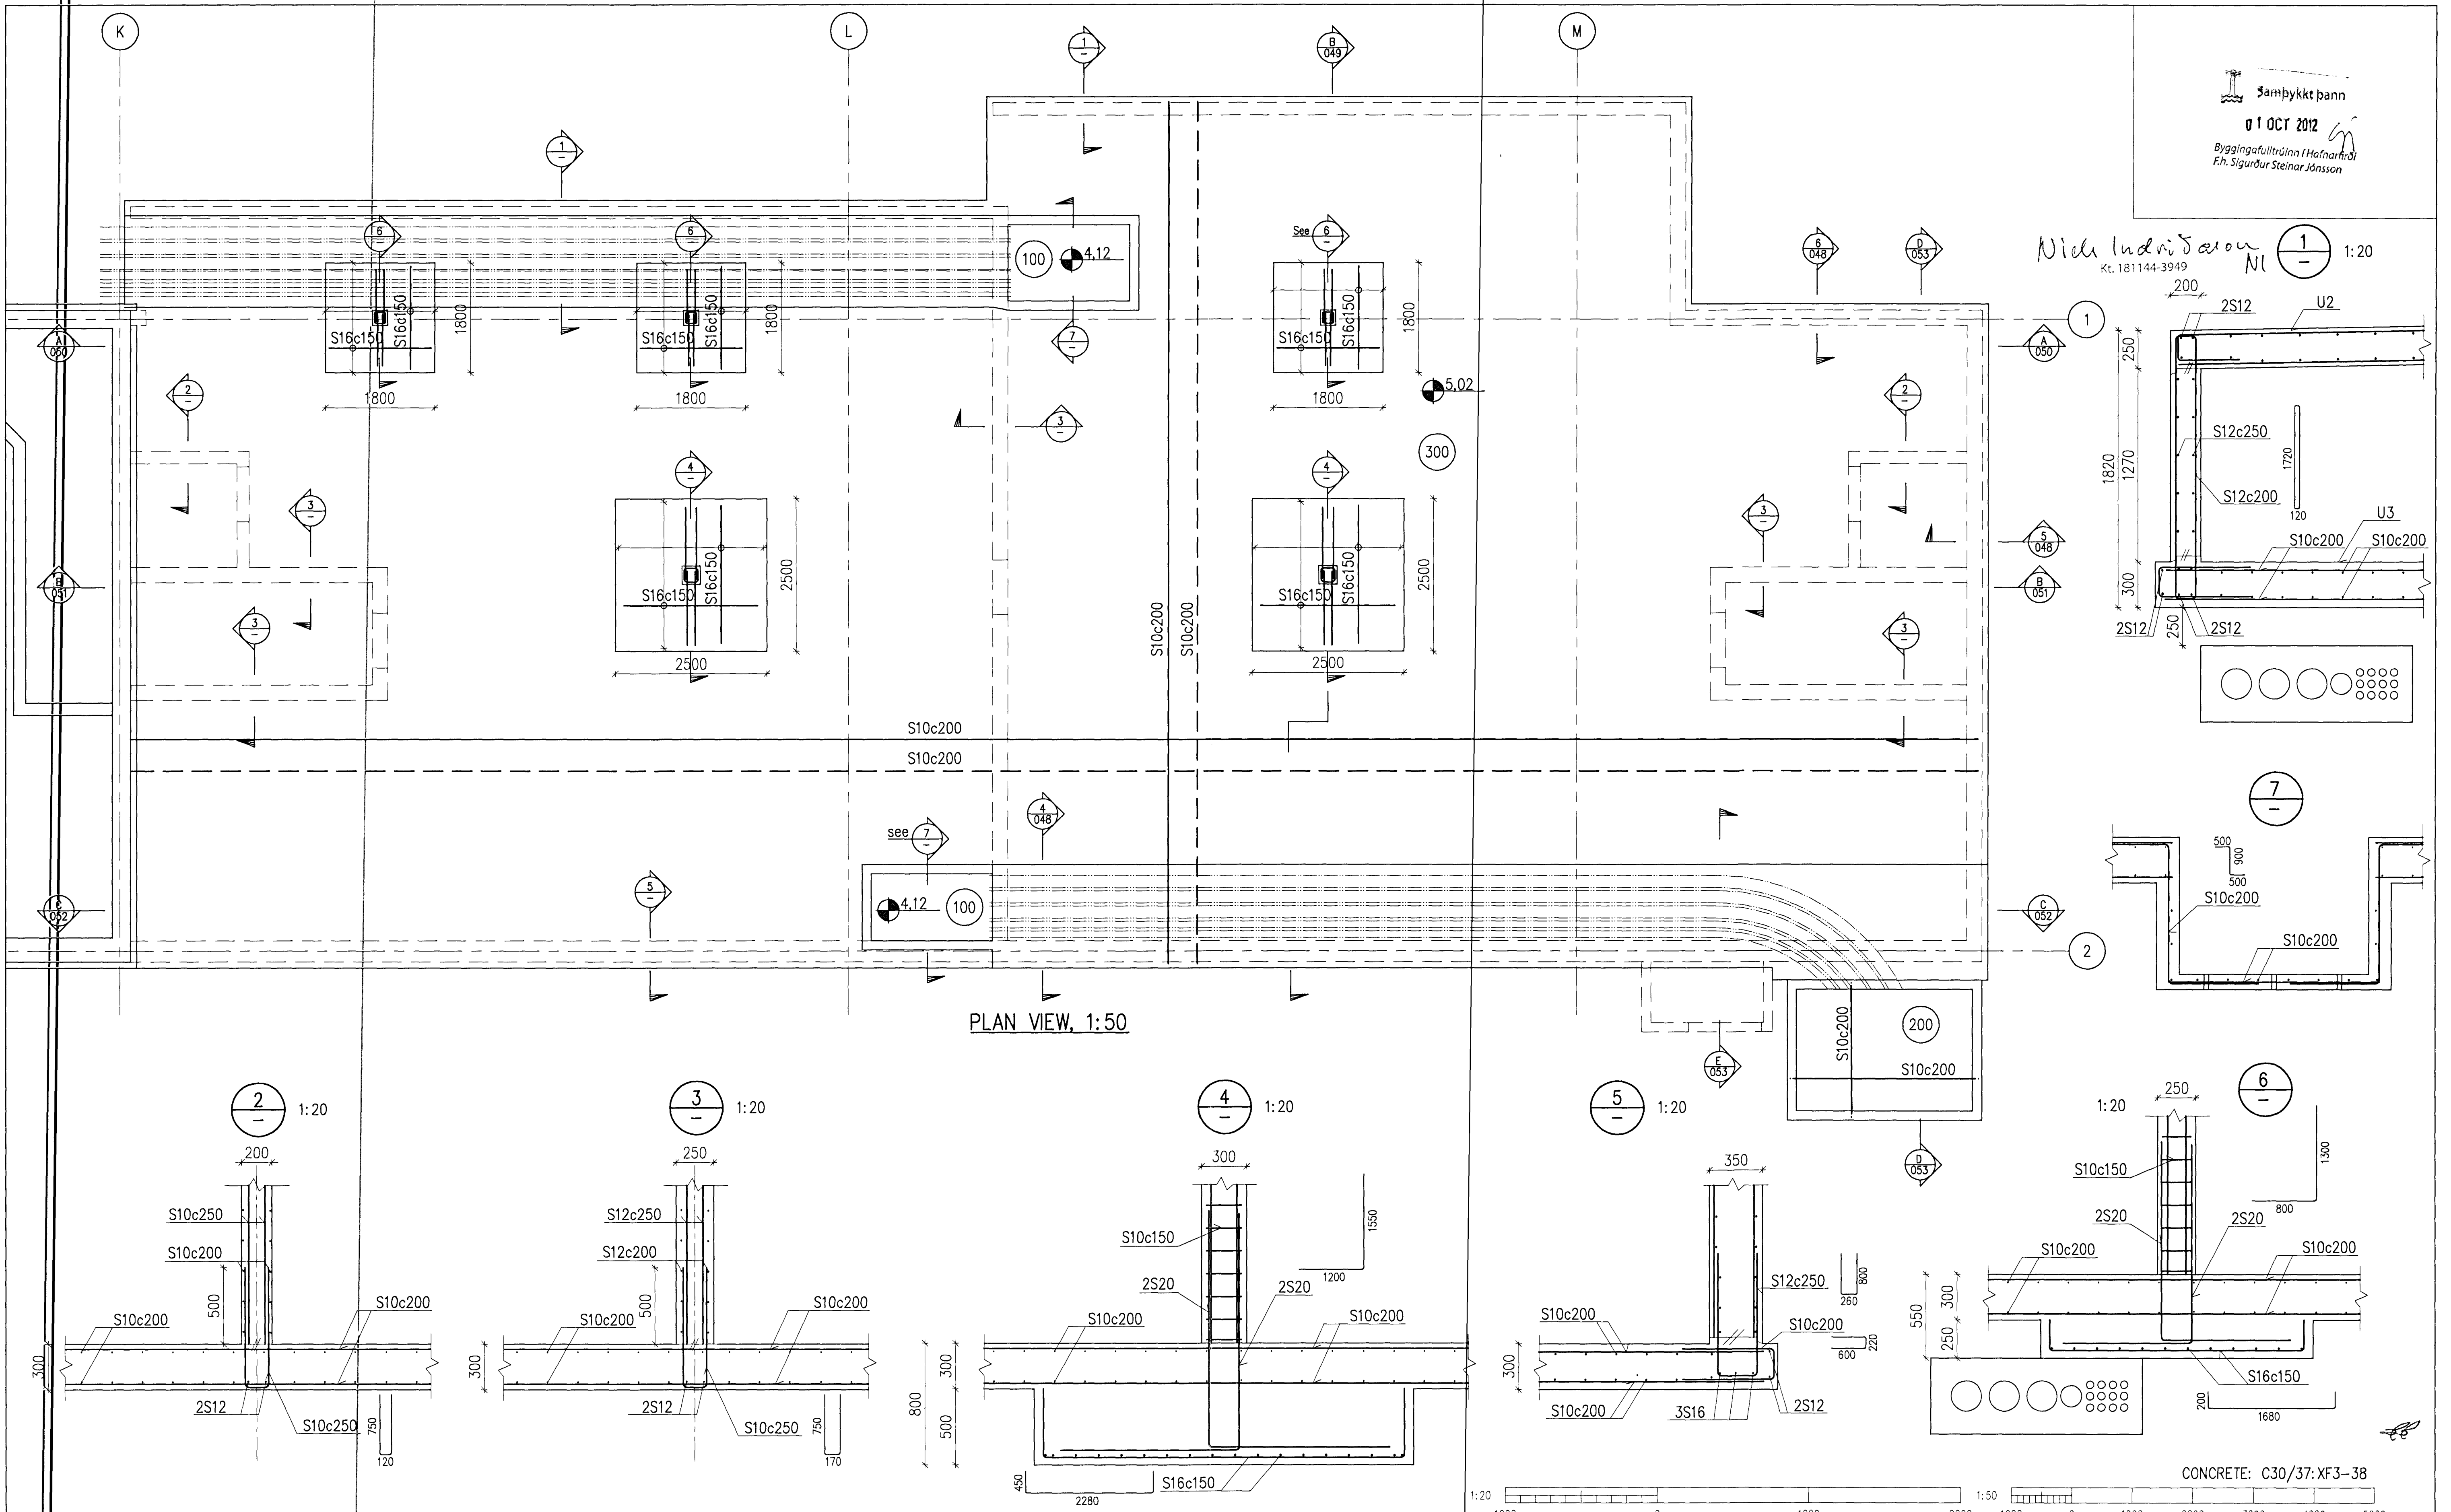

Skýringar:  
 Legend:

16	Record Drawing	2012.06.11	HS	NI	AKJ	NSB
Slg nr	Rev no	Dagsetning	Has/Has Des/Des	Yfir Clk	Notk heim Suppl Rel	Notk heim ISAL Rel

This drawing is the property of Rio Tinto Alcan Iceland Ltd. and handed out for personal use only. It may neither be copied nor made available to others without permission of Rio Tinto Alcan Iceland Ltd. The receiver is liable for any misuse.	
Format: A1	Scale: 1:20, 1:50
Dimensions without tolerances according to ISO 2768-1 medium.	

Dagsetning / Date: 2008.10.01	Teikn / Drawn: AFV
HRV & HATCH	Verkfrá / Supplier: HRV
Teiknur/verkfrá / Supplier drw.no: IDP-410-CA-015-045	Yfirfr / Chkd: NI
Samþykkt / Approved: NI	Hluti af / Part of:

IPU 410 - SUBSTATION 60 kV SWITCHGEAR BLD. BASEMENT SLAB REINFORCEMENT	Flokkur nr.: 4011	Bláð nr.: 01188
Kostn.nr.-Göng. / Bgn.nr.-Egno: 4011	AKS UB01	ISAL Tekn.nr. ISAL / Drw.no. of ISAL: 251222
<b>RioTinto Alcan</b>	ISAL Akranes Ltd	ISAL Reykjavík
ISAL Yfirfrá og skráð, dags. / ISAL Checked, date	ISAL Samþykkt, dags. / ISAL Approved, date	