


Samþykkt þann
 01 OCT 2012
 Byggingafræðingur / Draufmaður
 F.h. Sigurður Steinar Jónsson

Nicholas Indriatono
 Kt. 181144-3949

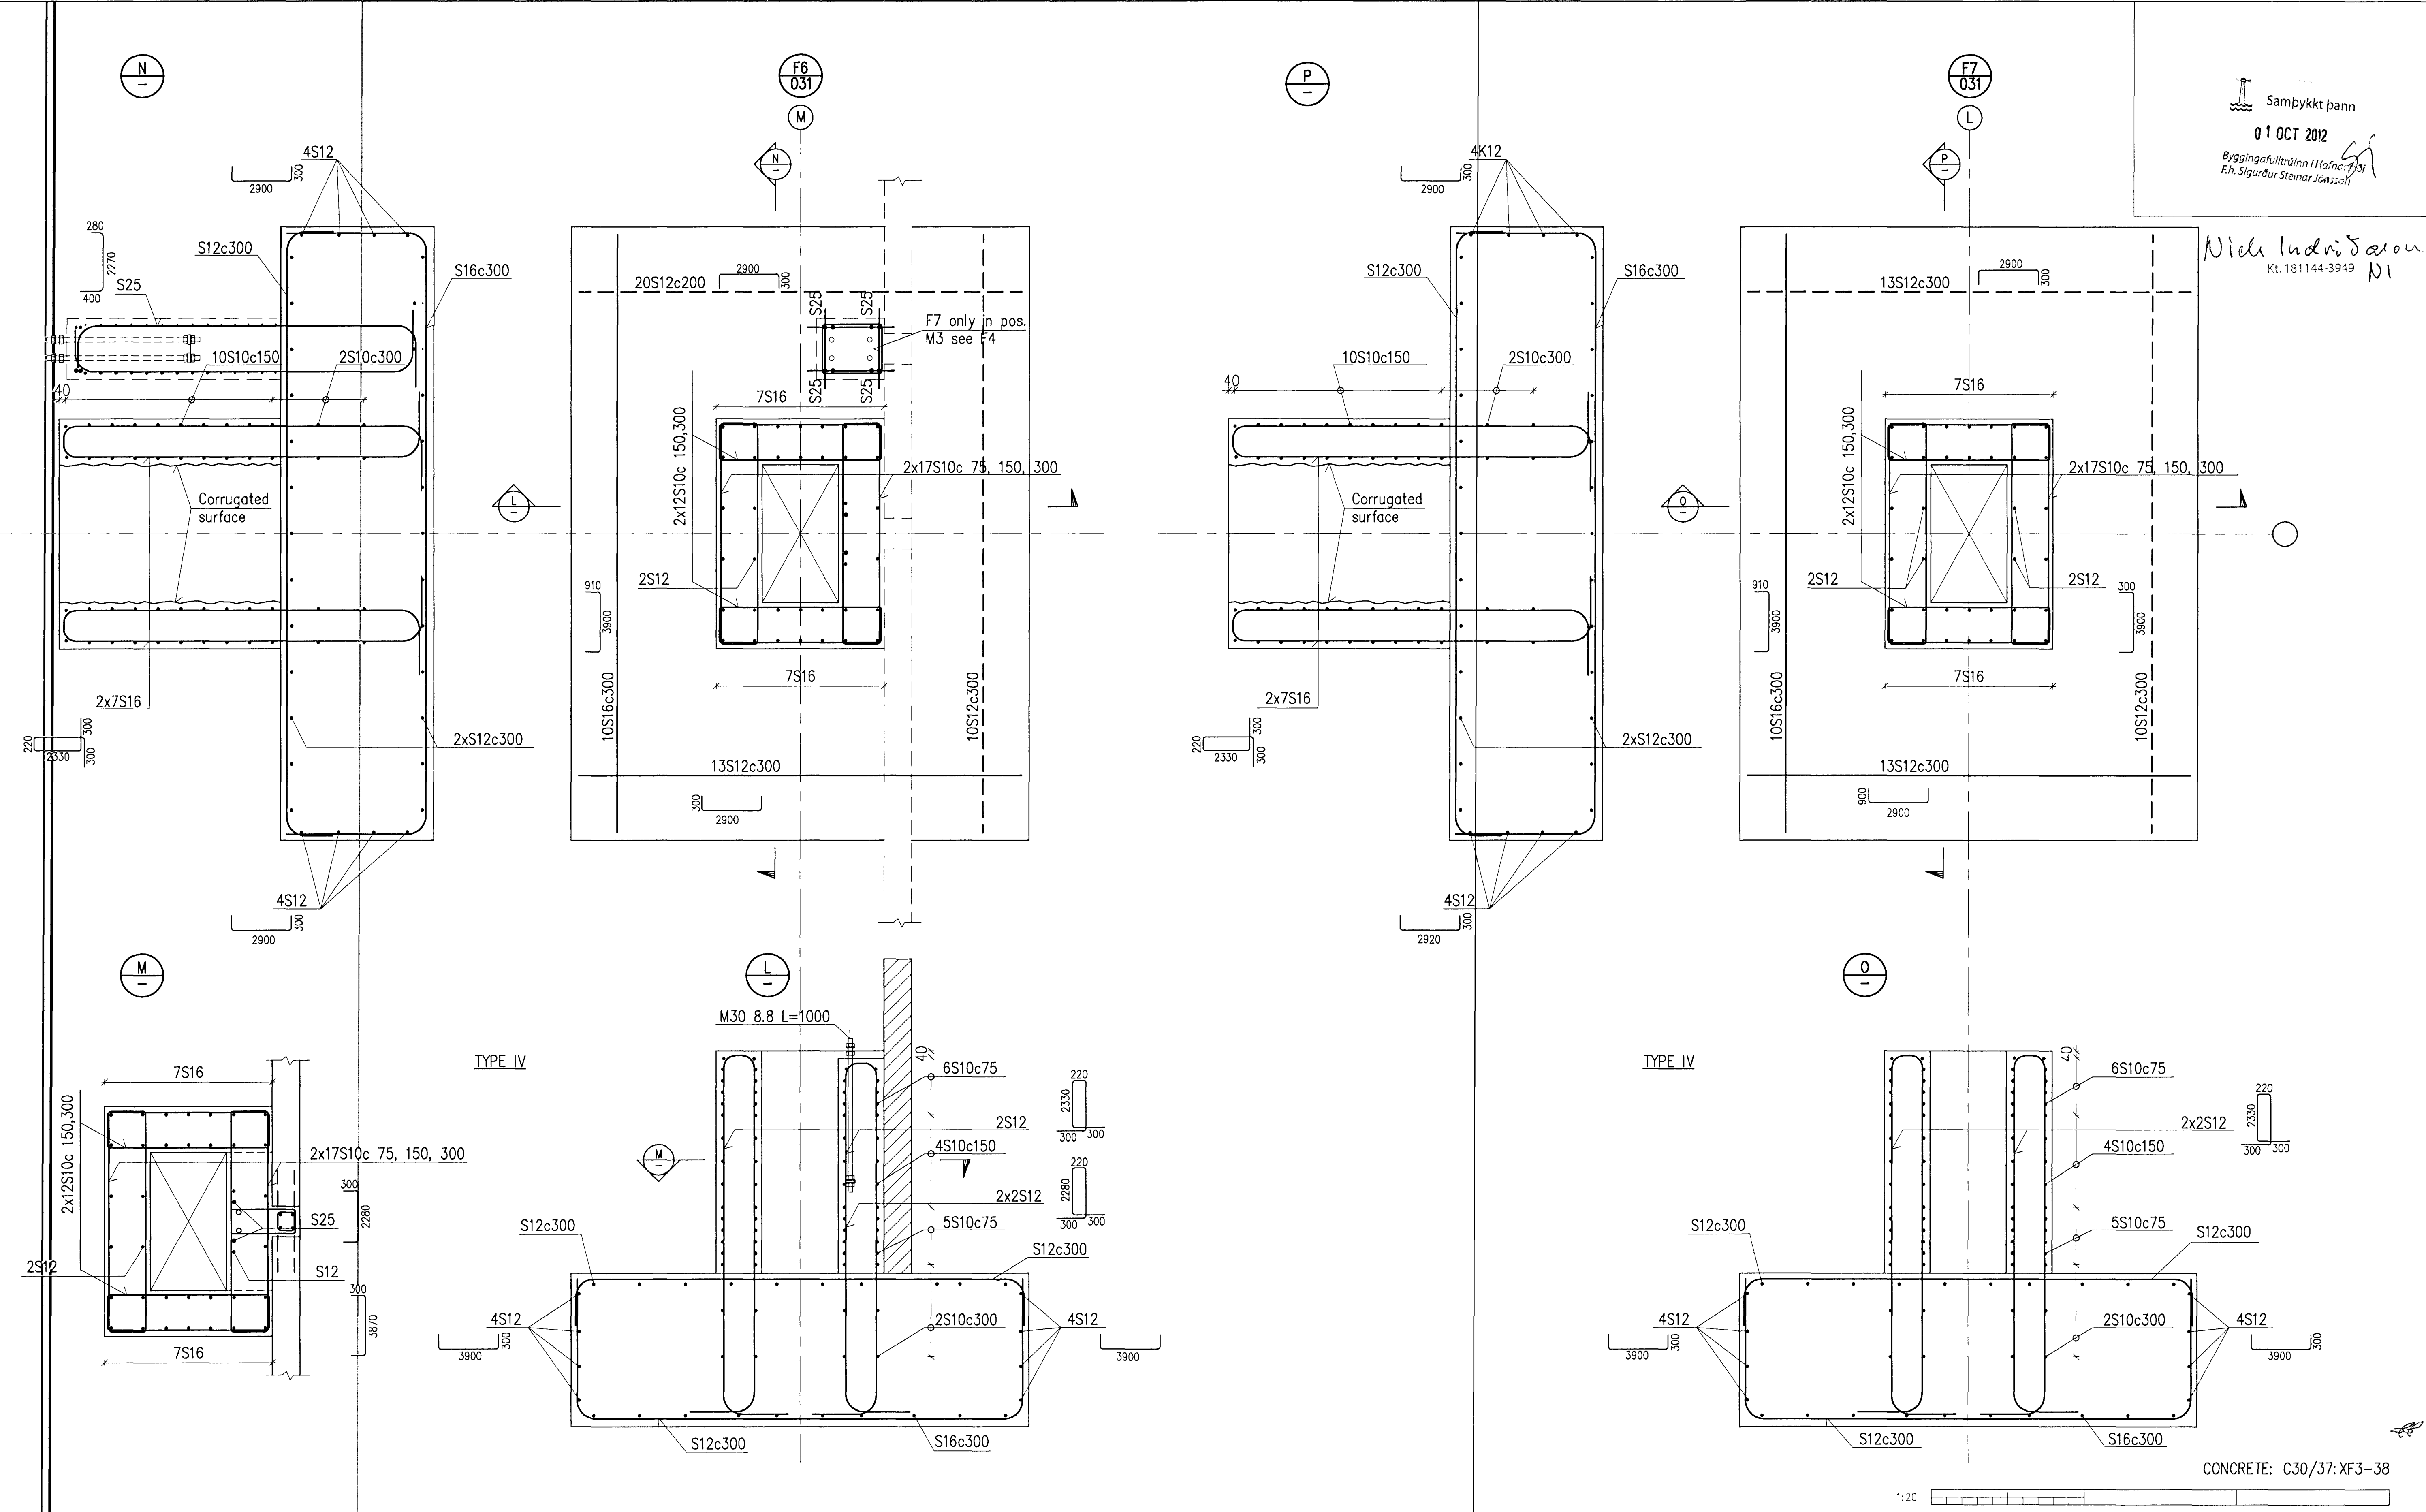

Skýringar:
 Legend

C:\DIP\01\DP\400 - Reduction\410 Substation\Drawings\Civil\DP-410-CA-015-043.dwg

Útg. nr	Rev. no	Lýsing	Þegning	Date	HS	Yfirl	Notk. heim	Notk. heim	Notk. heim
Útg. nr	Rev. no	Description	Approval	Date	HS	Yfirl	Notk. heim	Notk. heim	Notk. heim
12		Record Drawing		2012.08.11	HS				

This drawing is the property of Rio Tinto Alcan Iceland Ltd and handed out for personal use only. It may neither be copied nor made available to others without permission of Rio Tinto Alcan Iceland Ltd. The receiver is liable for any misuse.

Scale: 1:20
 Dimensions without tolerances according to ISO 2768-M medium.



Dagsetning / Date 2008.10.01		Flakur nr. / Blað nr. / Nasta blnr. 4011 / 01188	
Hannað / Designed HS		Kostn.nr. - Ccno. / Búnr. - Ea.no 4011 / 01188	
Verktaki / Supplier HRV		Teg. teikningar / Dwg. type REINFORCEMENT	
Tehn.nr. verktaka / Supplier drw.no. IDP-410-CA-015-043		Tehn.nr. ISAL / Drw.no. of ISAL 251220	
Samþykkt / Approved NI		Breyt. / Rev. A	
ISAL Yfirráð og skráð, dags / ISAL Checked, date ISAL Samþykkt, dags / ISAL Approved, date			

1:20
 1000 0 1000 2000 mm