



Samþykkt þann
 01 OCT 2012
 Byggingafulltrúinn / Hofmann
 F.H. Sigurður Steinar Jónsson

Níels Indriðason
 Kt. 181144-3949
 NI

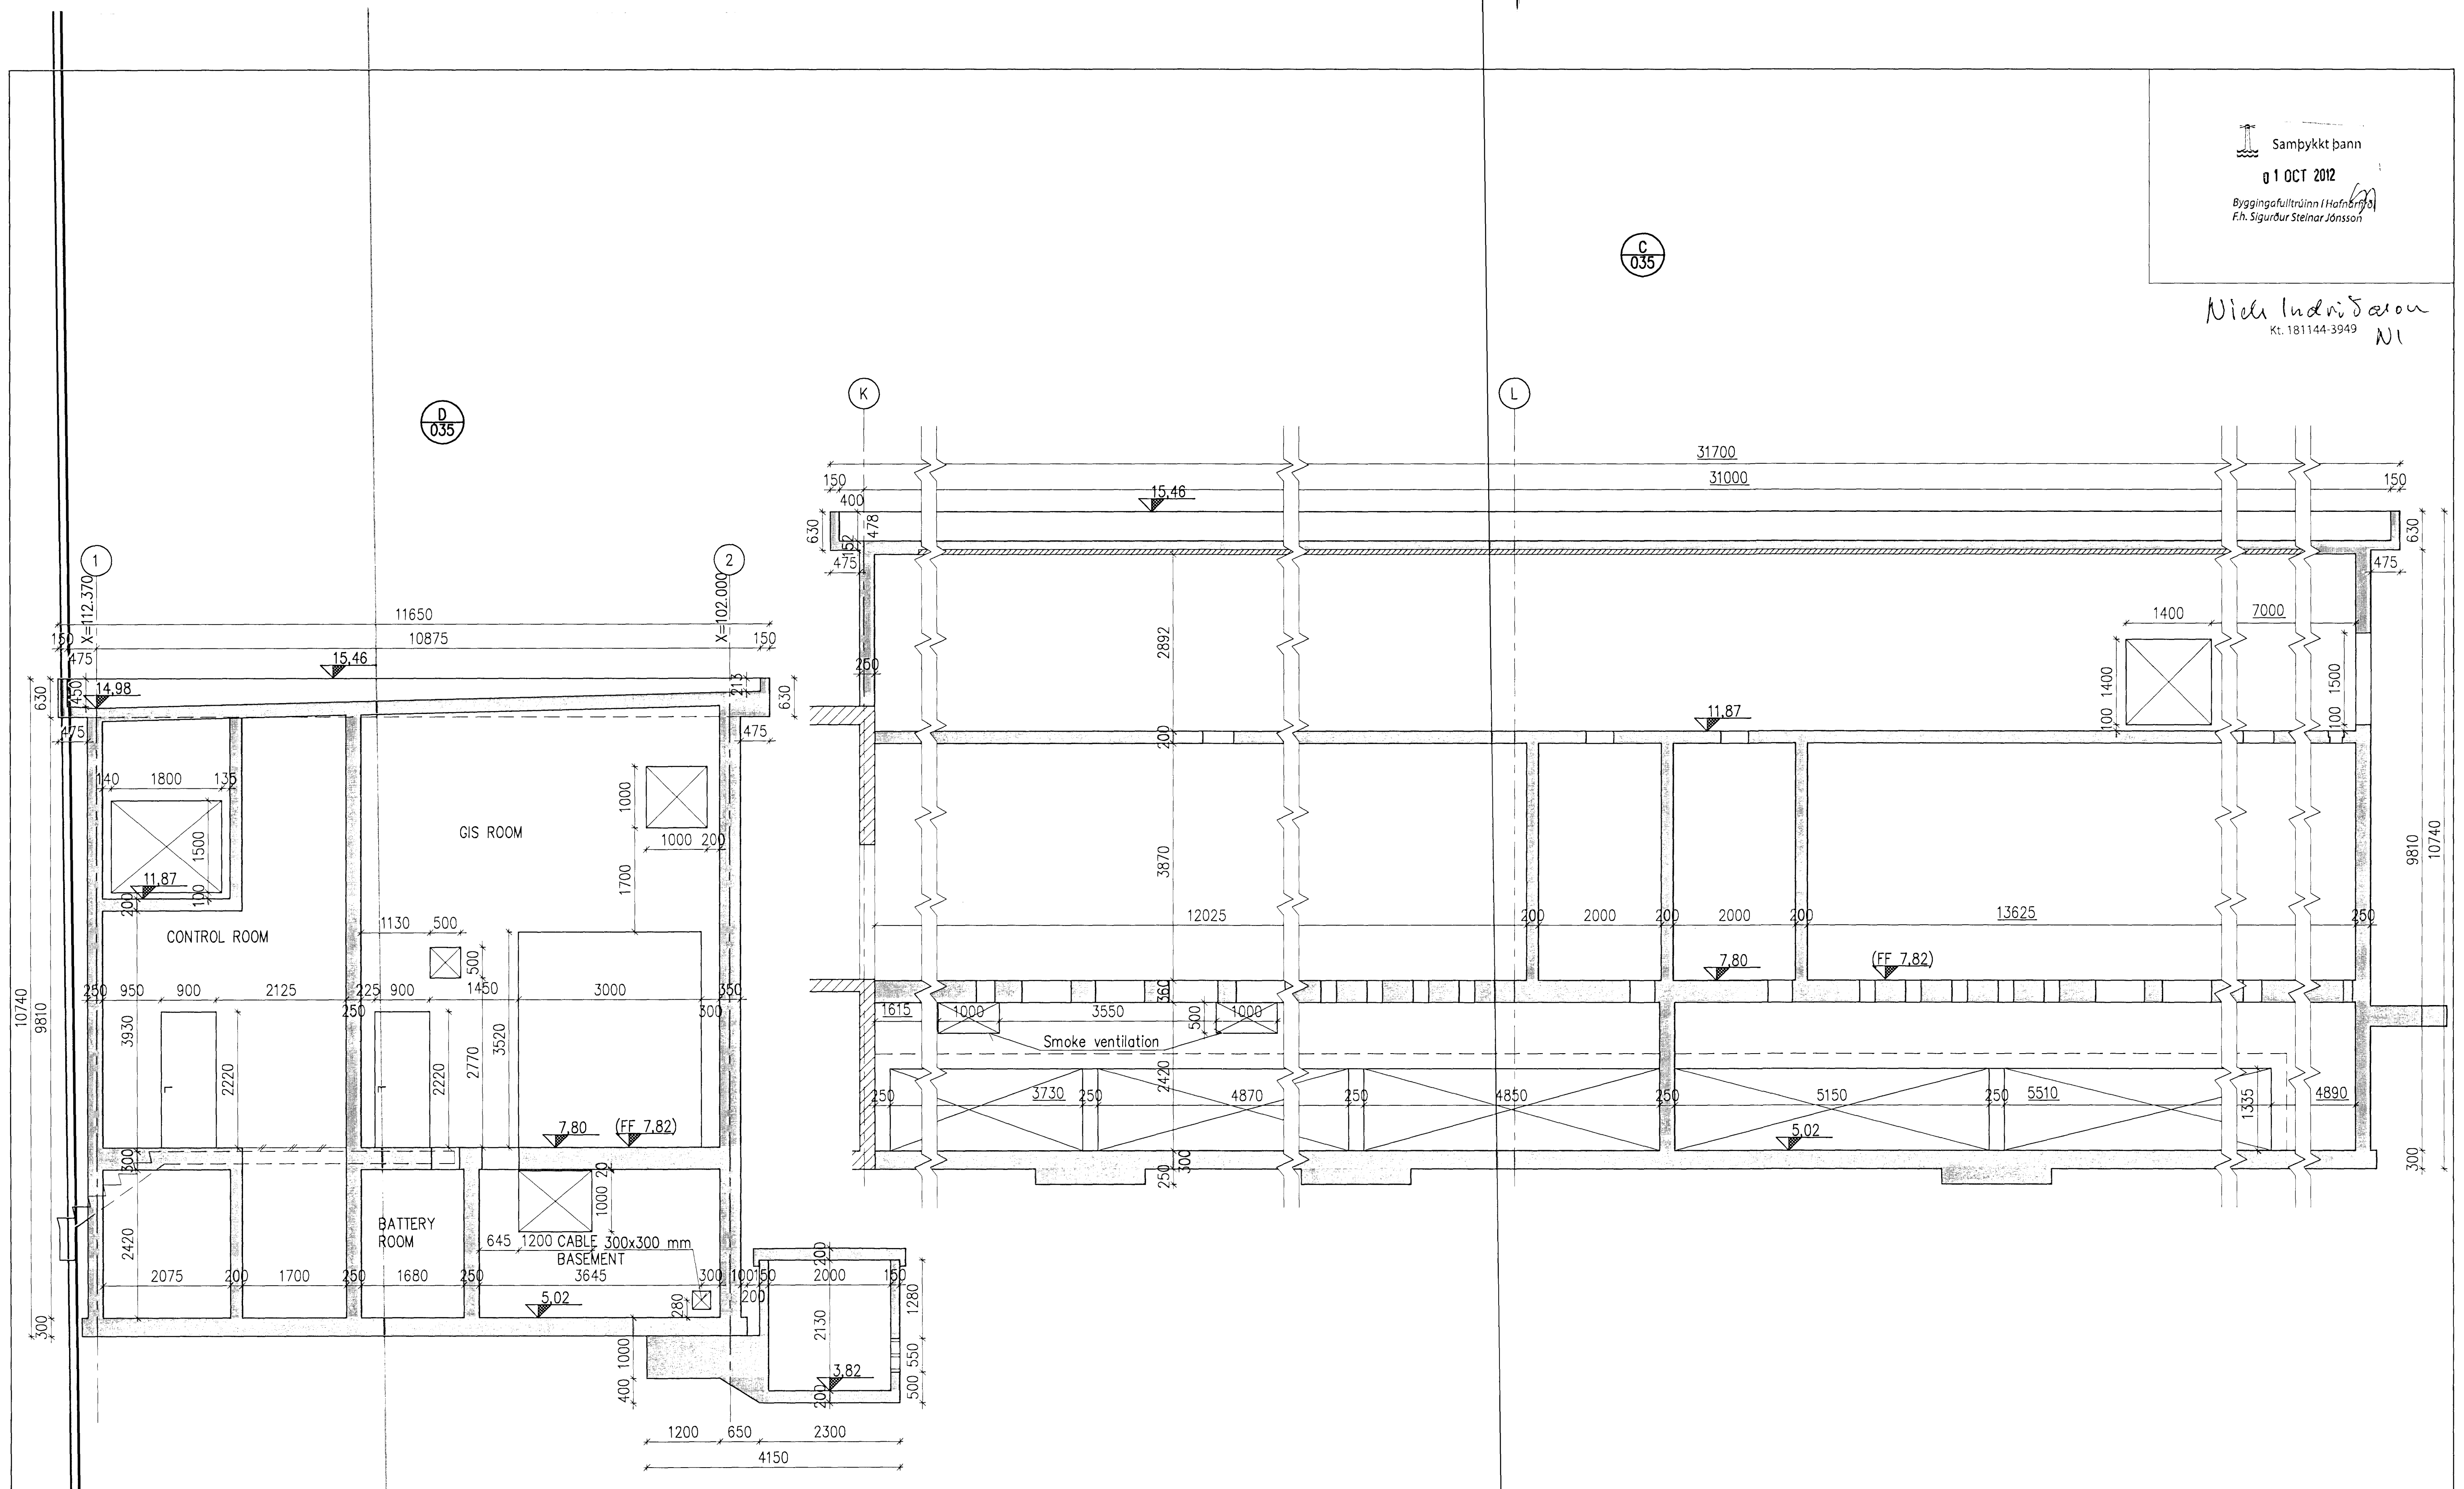

CONCRETE: C30/37:XF3-32

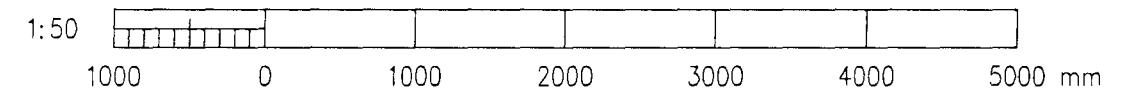

Skýringar
 Legend:

17	Record Drawing	2012.06.11	HS	NI	AK	re	re
Dwg nr	Description	Dagsetning Date	Höf./Tkn Des/Drw	Yfir Ckd	Nota heim Suppl Rer	Meik heim Suppl Rer	ISAL Rer

This drawing is the property of Rio Tinto Alcan Iceland Ltd. and handed out for personal use only. It may neither be copied nor made available to others without permission of Rio Tinto Alcan Iceland Ltd. The receiver is liable for any misuse.
 Scale: 1:50
 Dimensions without tolerances according to ISO 2788-1 medium.



Dagsetning / Date	2008.12.01
Hannað / Designed	LDB
Tekn / Drawn	
Verktaki / Supplier	HRV
Tekn.nr.verktaka / Supplier draw.no.	IDP-410-CA-015-040
Samþykkt / Approved	NI
Yfir / Chkd	NI
Hluti af: / Part of:	

IPU 410 - SUBSTATION
 60 kV SWITCHGEAR BLD.
 WALLS SIDE VIEW 3/3
 CONCRETE WORK

RioTintoAlcan

Flokkur nr.:	Bláð nr.:	Nasta bl. nr.:
Kostn.nr.-Cano. / Bgn.nr.-Eqno		
4011	01188	
AKS	UB01	Breyt./Rev.
Tekn.nr. ISAL /Draw.no. of ISAL	251217	A
ISAL Yfirráð og skráð, dags / ISAL Checked, date	ISAL Samþykkt, dags / ISAL Approval, date	