



Samþykkt þann
 01 OCT 2012
 Byggingafulltrúinn / Hafið
 Fh. Sigurður Steinar Jónsson

Níli Indriðason
 Kt. 181144-3949
 NI


PLAN VIEW 7,80, 1:50

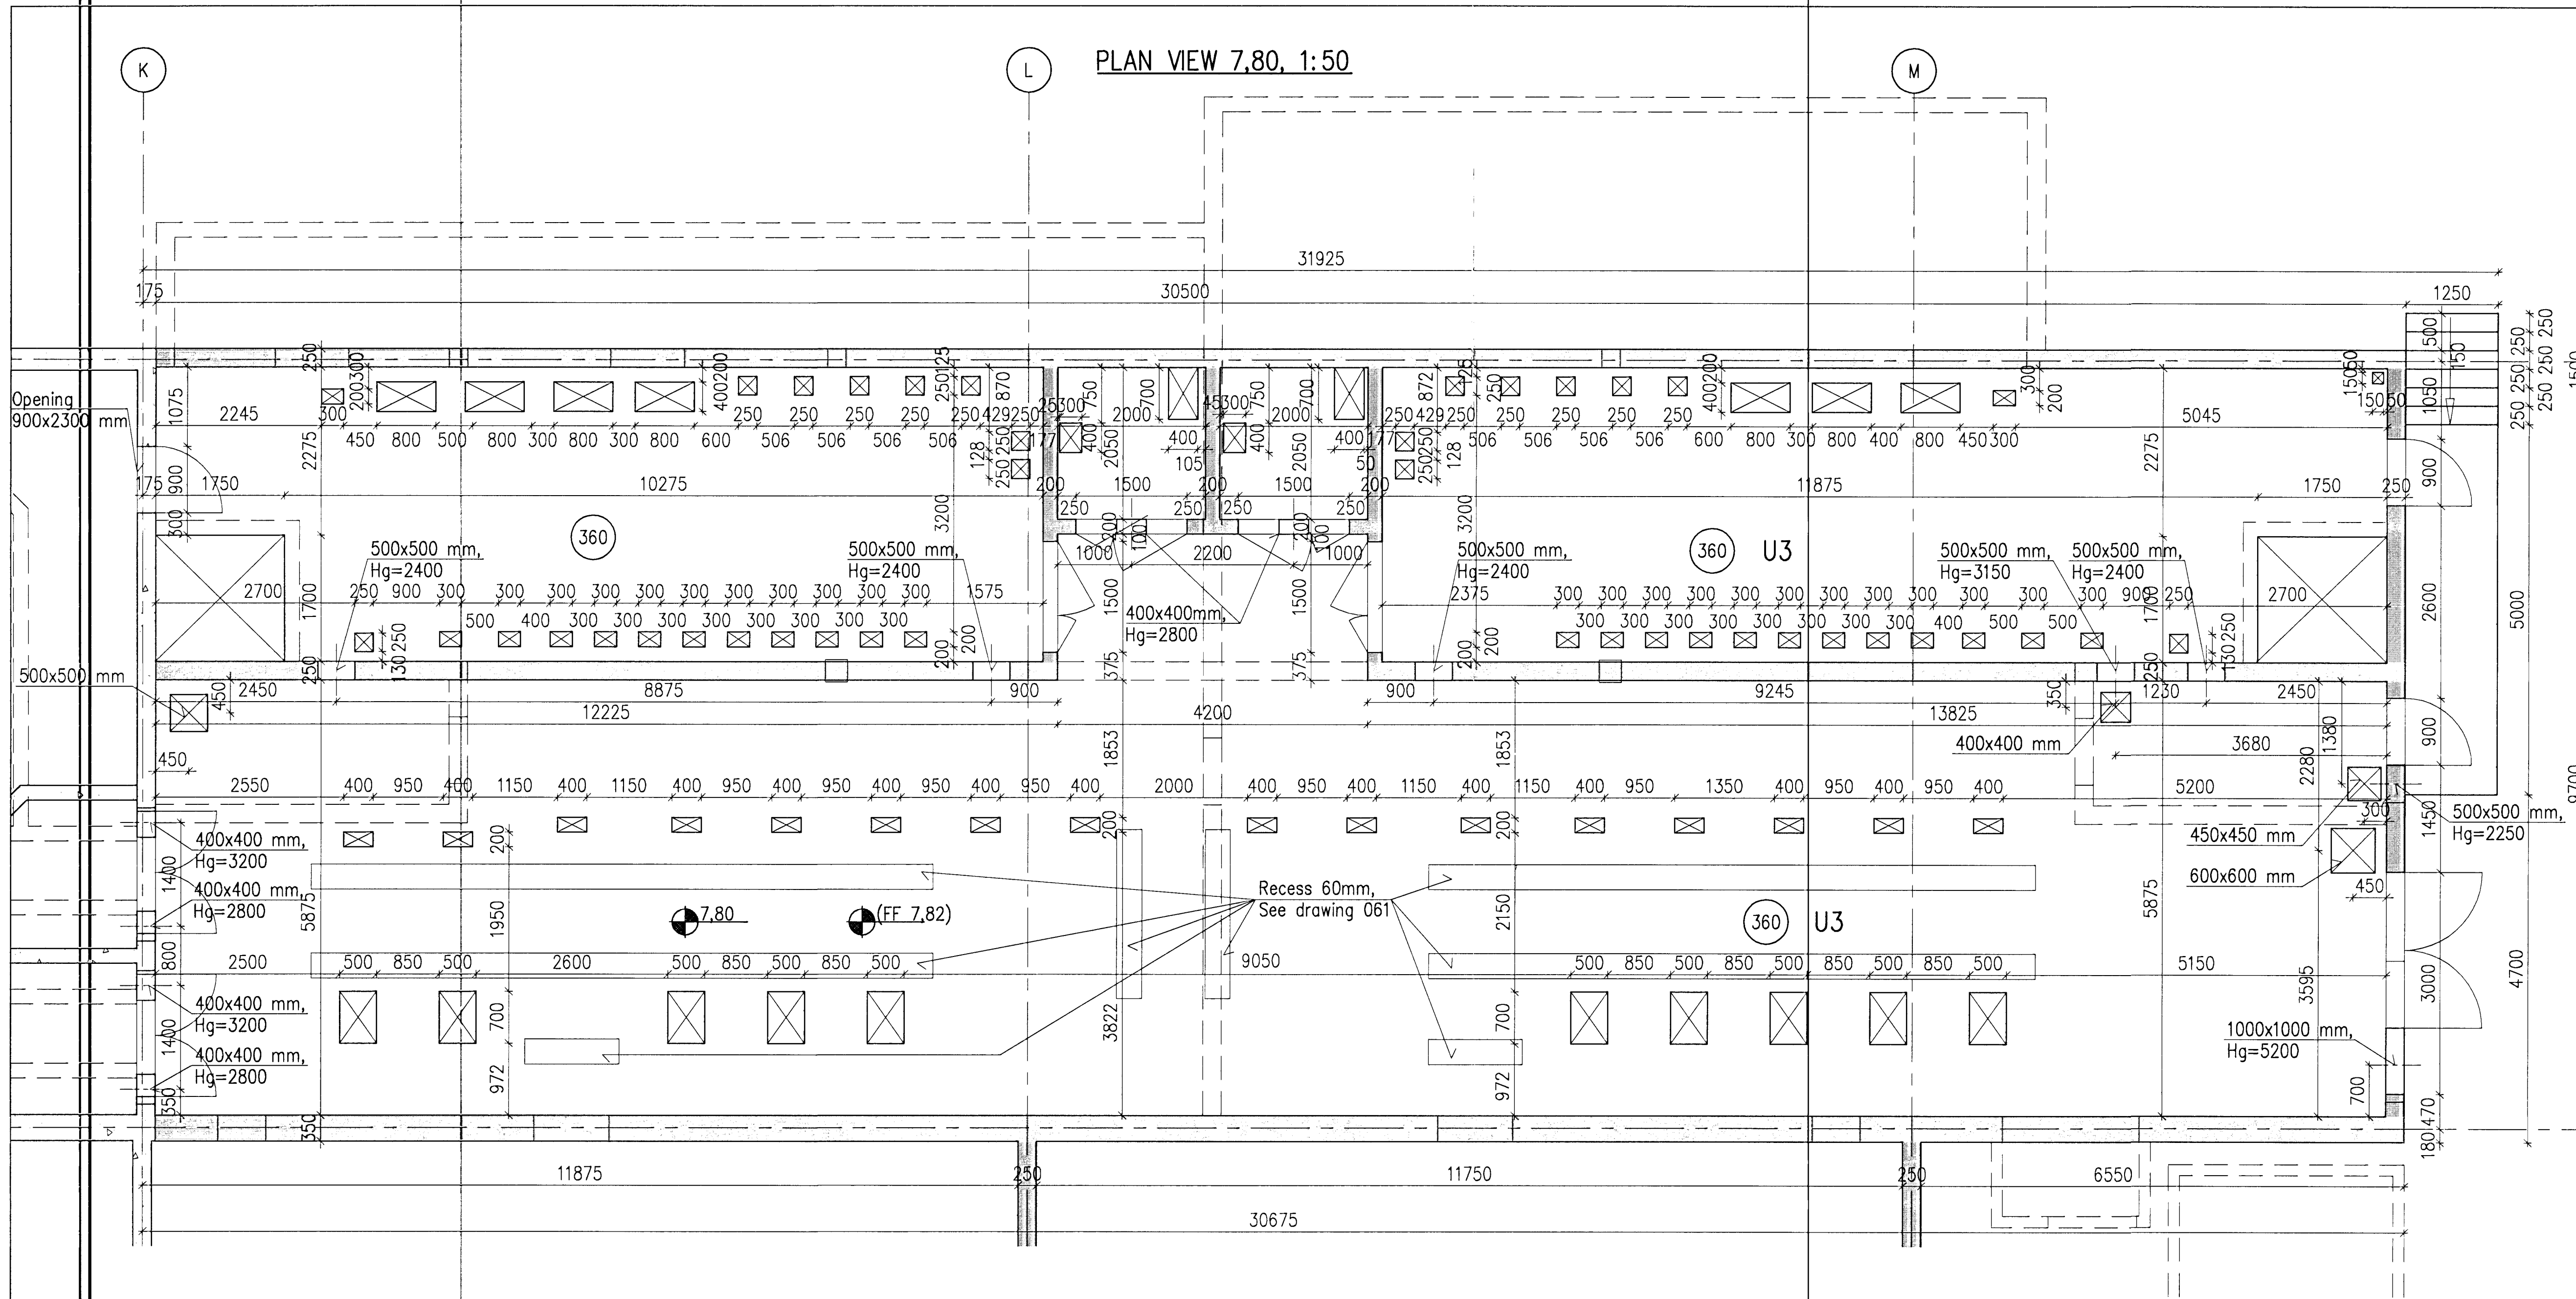

FLOOR, PLAN VIEW 11,87, 1:50

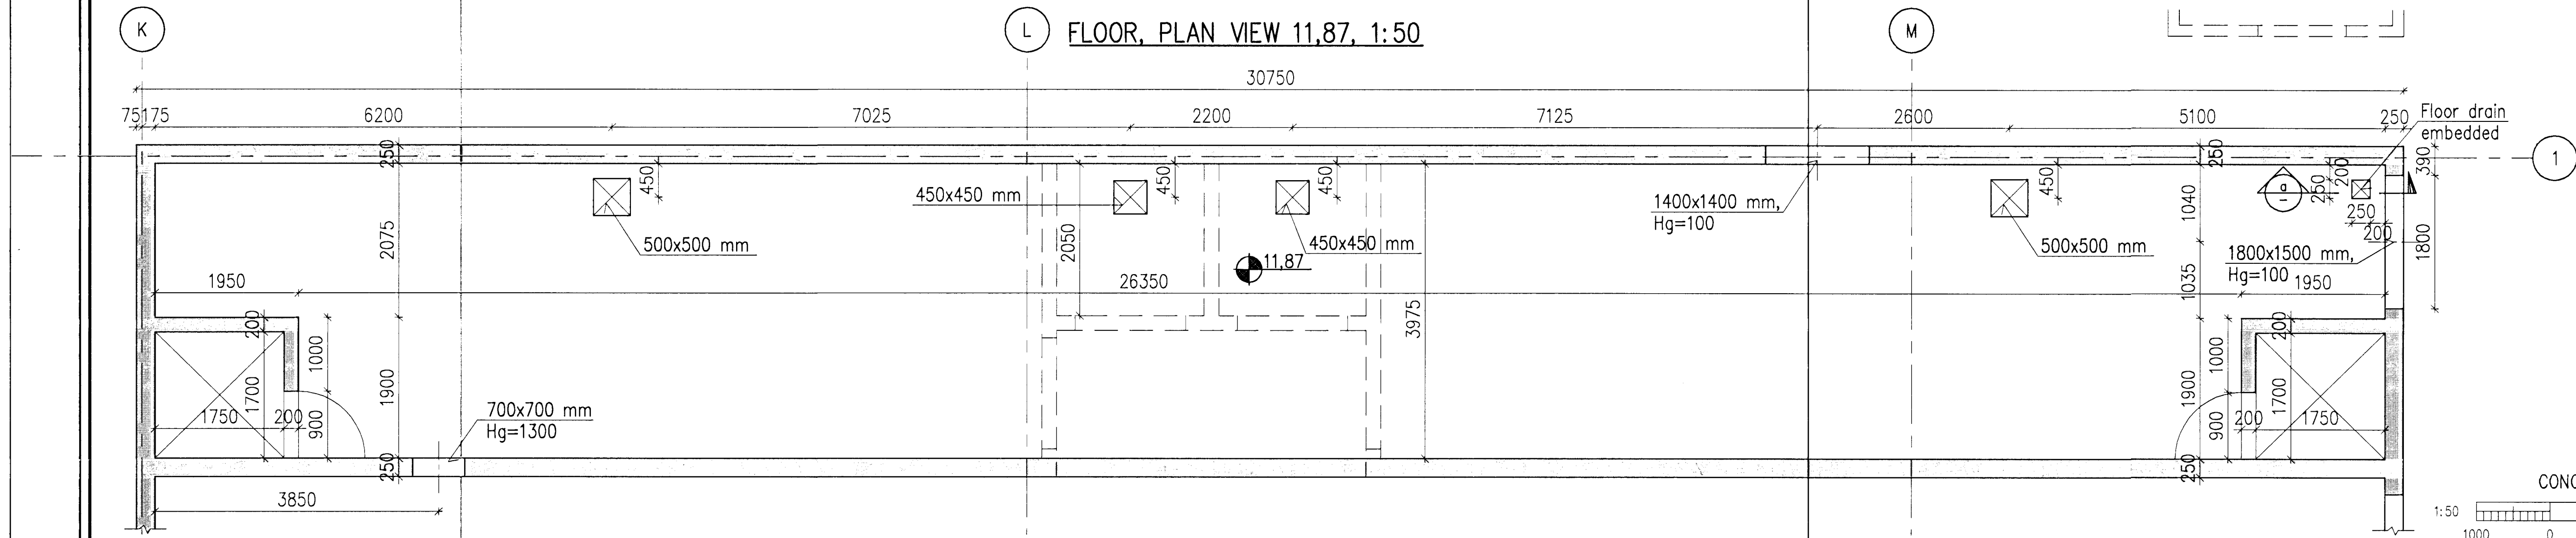

1:10

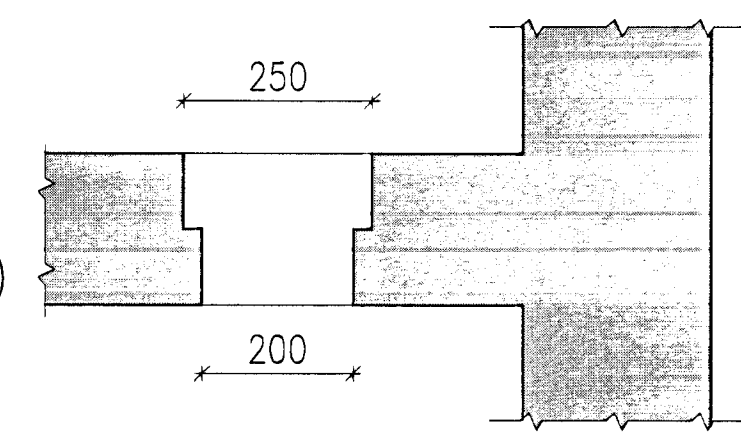

The center of transformers must match to the openings in wall in gridline 2. If measured from the wall in gridline K it must be secured that the wall is straight.

CONCRETE: C30/37:XF3-32

Skýringar:
 Legend:
 Elevations of openings for pipes are at center of openings.
 Elevation of ventilation openings refers to bottom of openings marked Hg.

19	Record Drawing	Lýsing	2012.06.11	HS	NI	BS	ret...
Útg nr	Rev no	Lýsing	Dagsetning	Har/Tun	Yfir	Notk heim	Notk heim
		Description	Date	Des/Dr*	Dtd	Suppl	ISAL

This drawing is the property of Rio Tinto Alcan Iceland Ltd and is handed out for personal use only. It may neither be copied nor made available to others without permission of Rio Tinto Alcan Iceland Ltd. The receiver is liable for any misuse.

Scale: 1:50
 Dimensions without tolerances according to ISO 2768-1 medium.

HRV HATCH
 ISAL PRODUCTION UPGRADE

Dagsetning / Date: 2008.12.01
 Hönnuð / Designed: HS
 Tekn. / Drawn: LDB
 Verktaki / Supplier: HRV
 Tekn.nr.verktaka / Supplier drw.no: IDP-410-CA-015-036
 Samþykkt / Approved: NI
 Hluti af: / Part of:

IPU 410 - SUBSTATION
 60 kV SWITCHGEAR BLD.
 FLOOR 7,74

Flakkur nr.: 4011
 Blað nr.: 01188
 Kostn.nr.-Ceno. / Búnr.-Eq.no: 251213
 AKS UB01
 ISAL Tekn.nr. ISAL / Drw.no. of ISAL: 251213
 Breyt./Rev: A

RioTintoAlcan
 ISAL Straumsvirk
 IS-222 Hafið/Fjarfjar
 Ísland

ISAL Yfirfar og skráð, dags / ISAL Checked, date
 ISAL Samþykkt, dags / ISAL Approval, date