



Samykktt þann  
 01 OCT 2012  
 Byggingafráttirinn / Hrafn /  
 Fh. Sigurður Steinar Jónsson

Nicki Indriðsson  
 Kt. 1811443949 NI

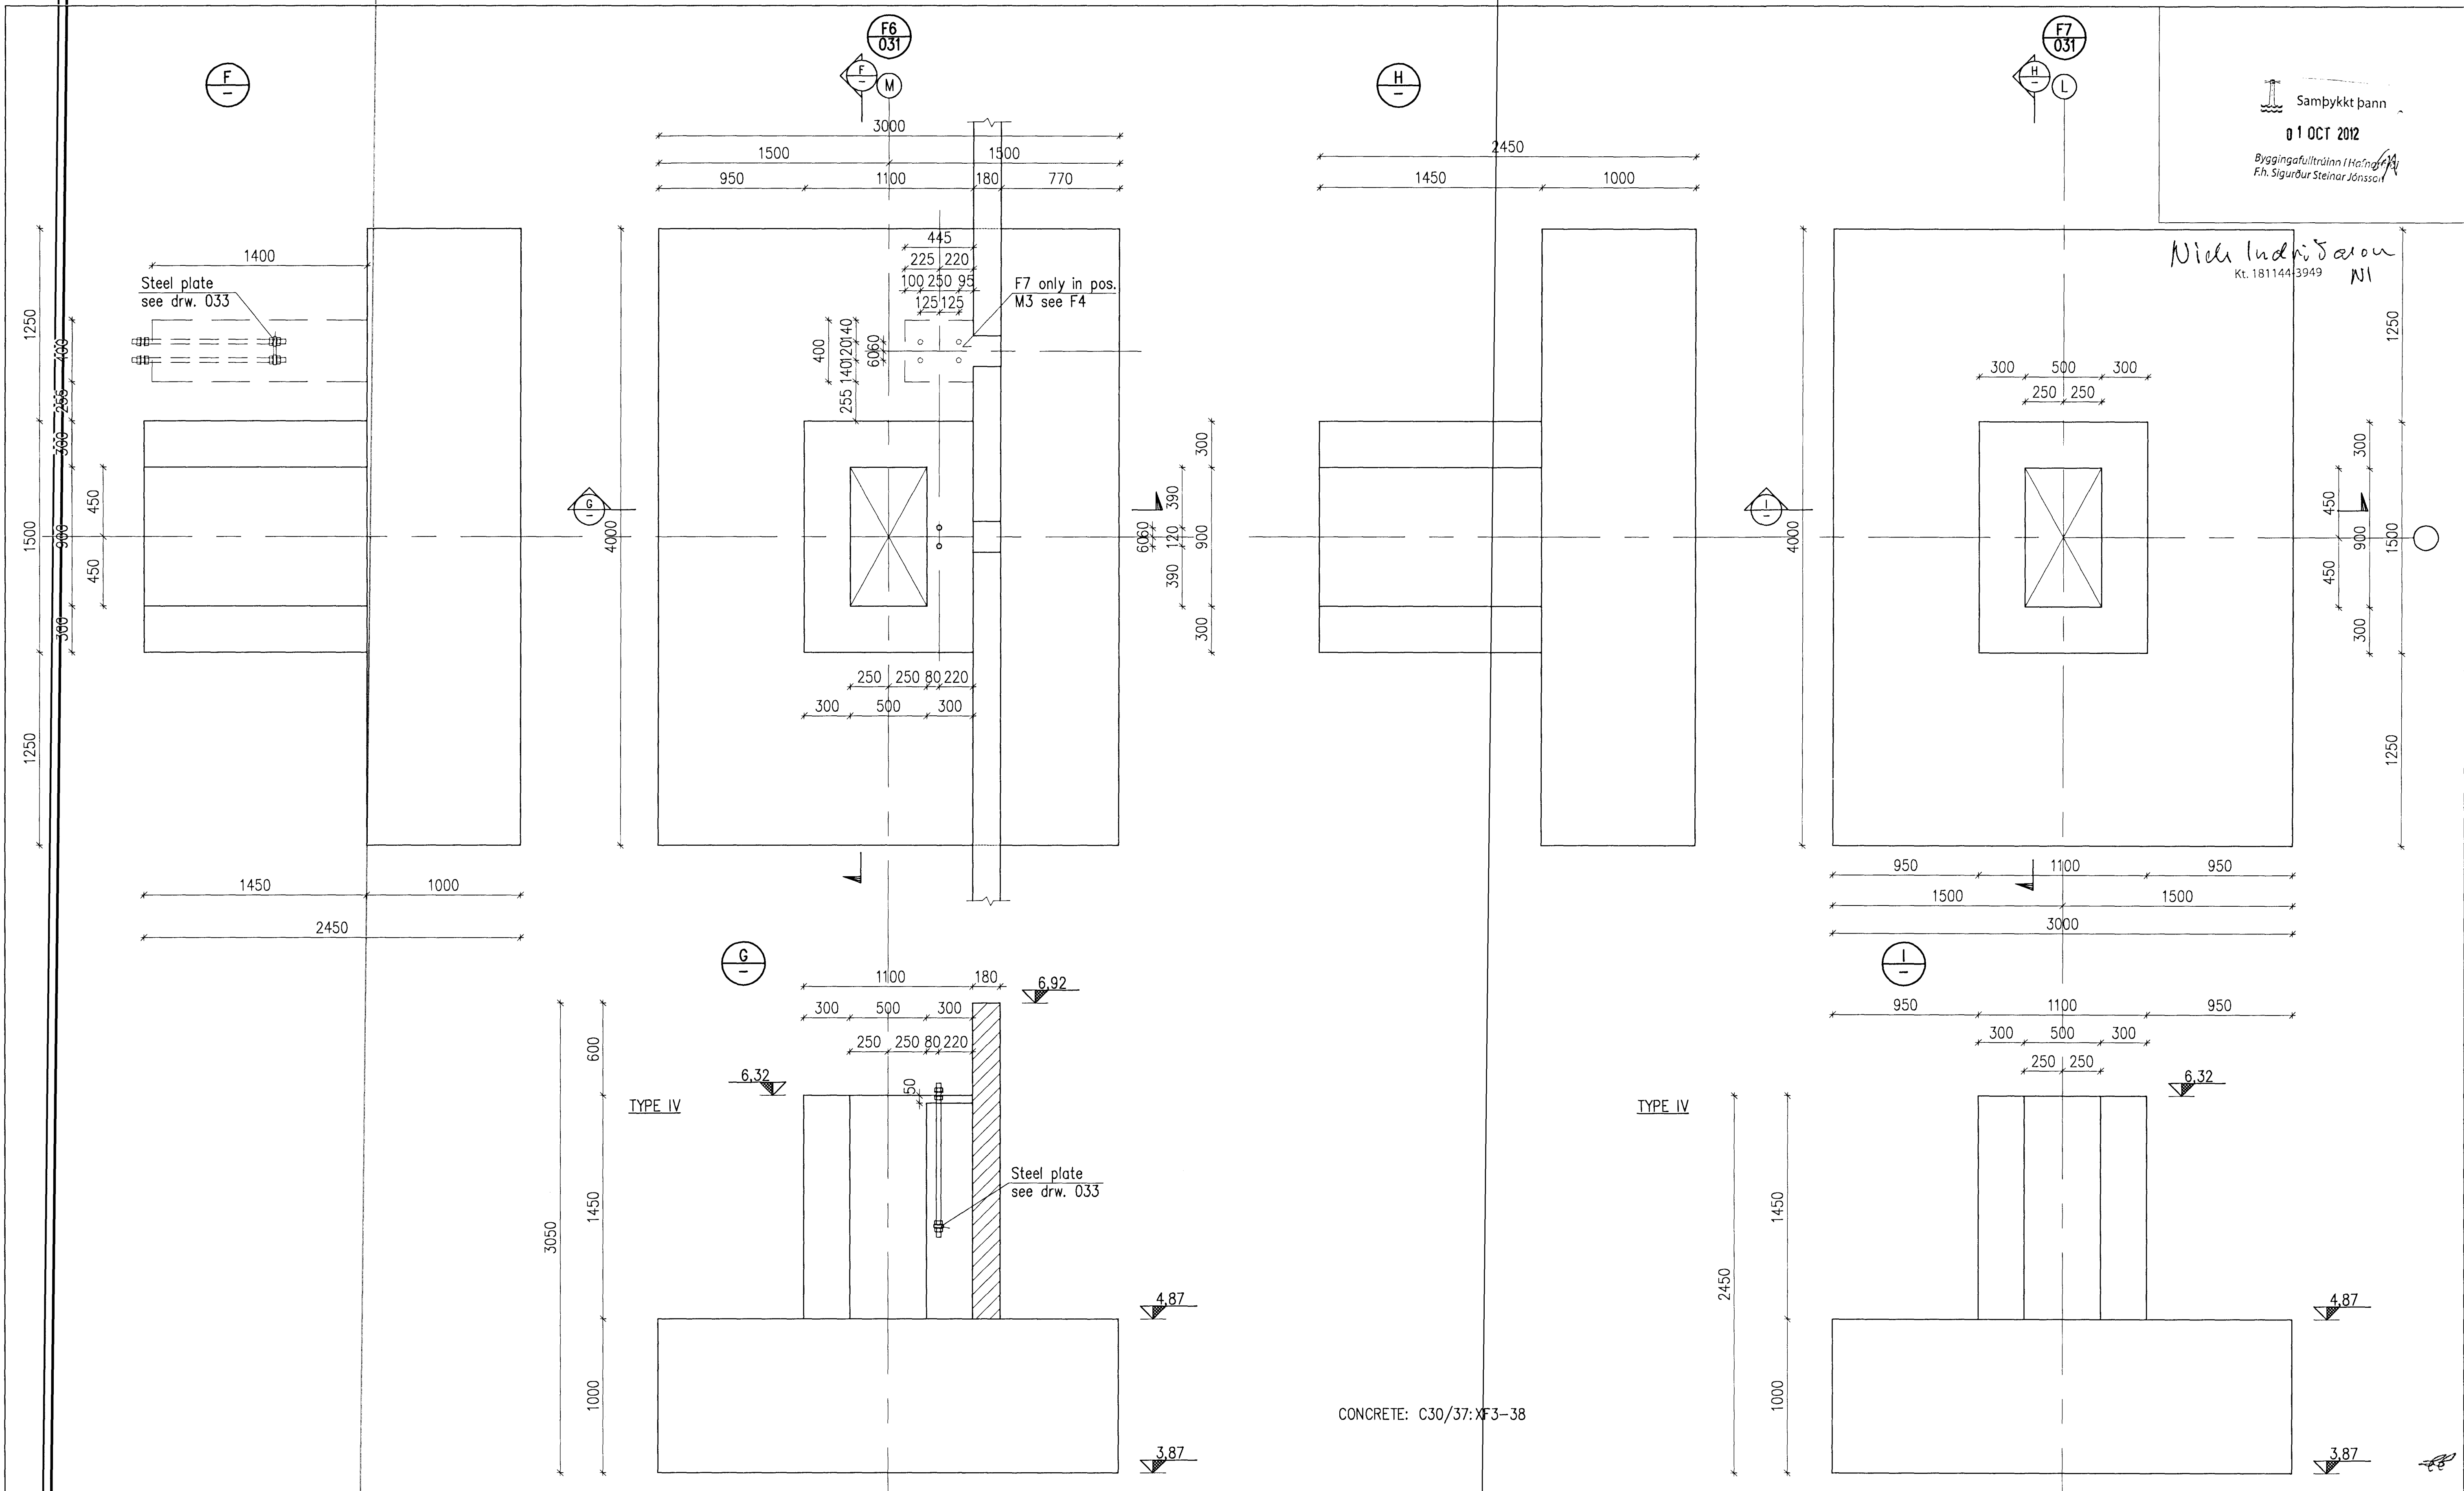

CONCRETE: C30/37;XF3-38

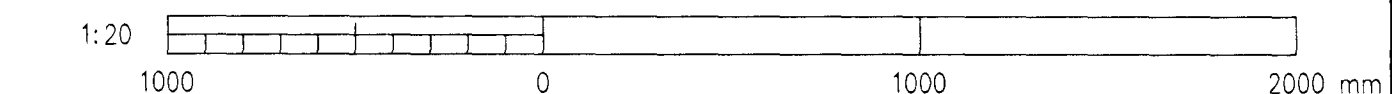

Skýringar: Legend:	This drawing is the property of Rio Tinto Alcan Iceland Ltd. and handed out for personal use only. It may neither be copied nor made available to others without permission of Rio Tinto Alcan Iceland Ltd. The receiver is liable for any misuse.						Dagsetning / Date 2008.10.01		IPU 410 - SUBSTATION 220 kV SWITCHYARD BLD. AND FOUNDATION, DETAILS AND SECTIONS 3/3		Flokkur nr.: 4011		Blað nr.: 01188		
	Start: A1 Mkv.: 1:20 Format: Scale: 1:20 Dimensions without tolerances according to ISO 2768-1 medium.						Tekn. / Draw: LDB		Teg. / Supplier: HRV		Teg. / Supplier: HRV		Tekn. nr. ISAL / Draw. no. of ISAL: 251211		Breyt./Rev.: A
12 Record Drawing		2012.06.11		HS		NI		NI		NI		NI		NI	
Dwg. nr. Rev. no.		Ljón Description		Dags Date		Hm./Tm Des./Drw		Yfir Ckd		Notk. heim Suppl. Ref		Notk. heim ISAL Ref		ISAL Yfirbúð og síðst. dags / ISAL Checked, date ISAL Samþykkt, dags / ISAL Approval, date	