




PLAN 1:200

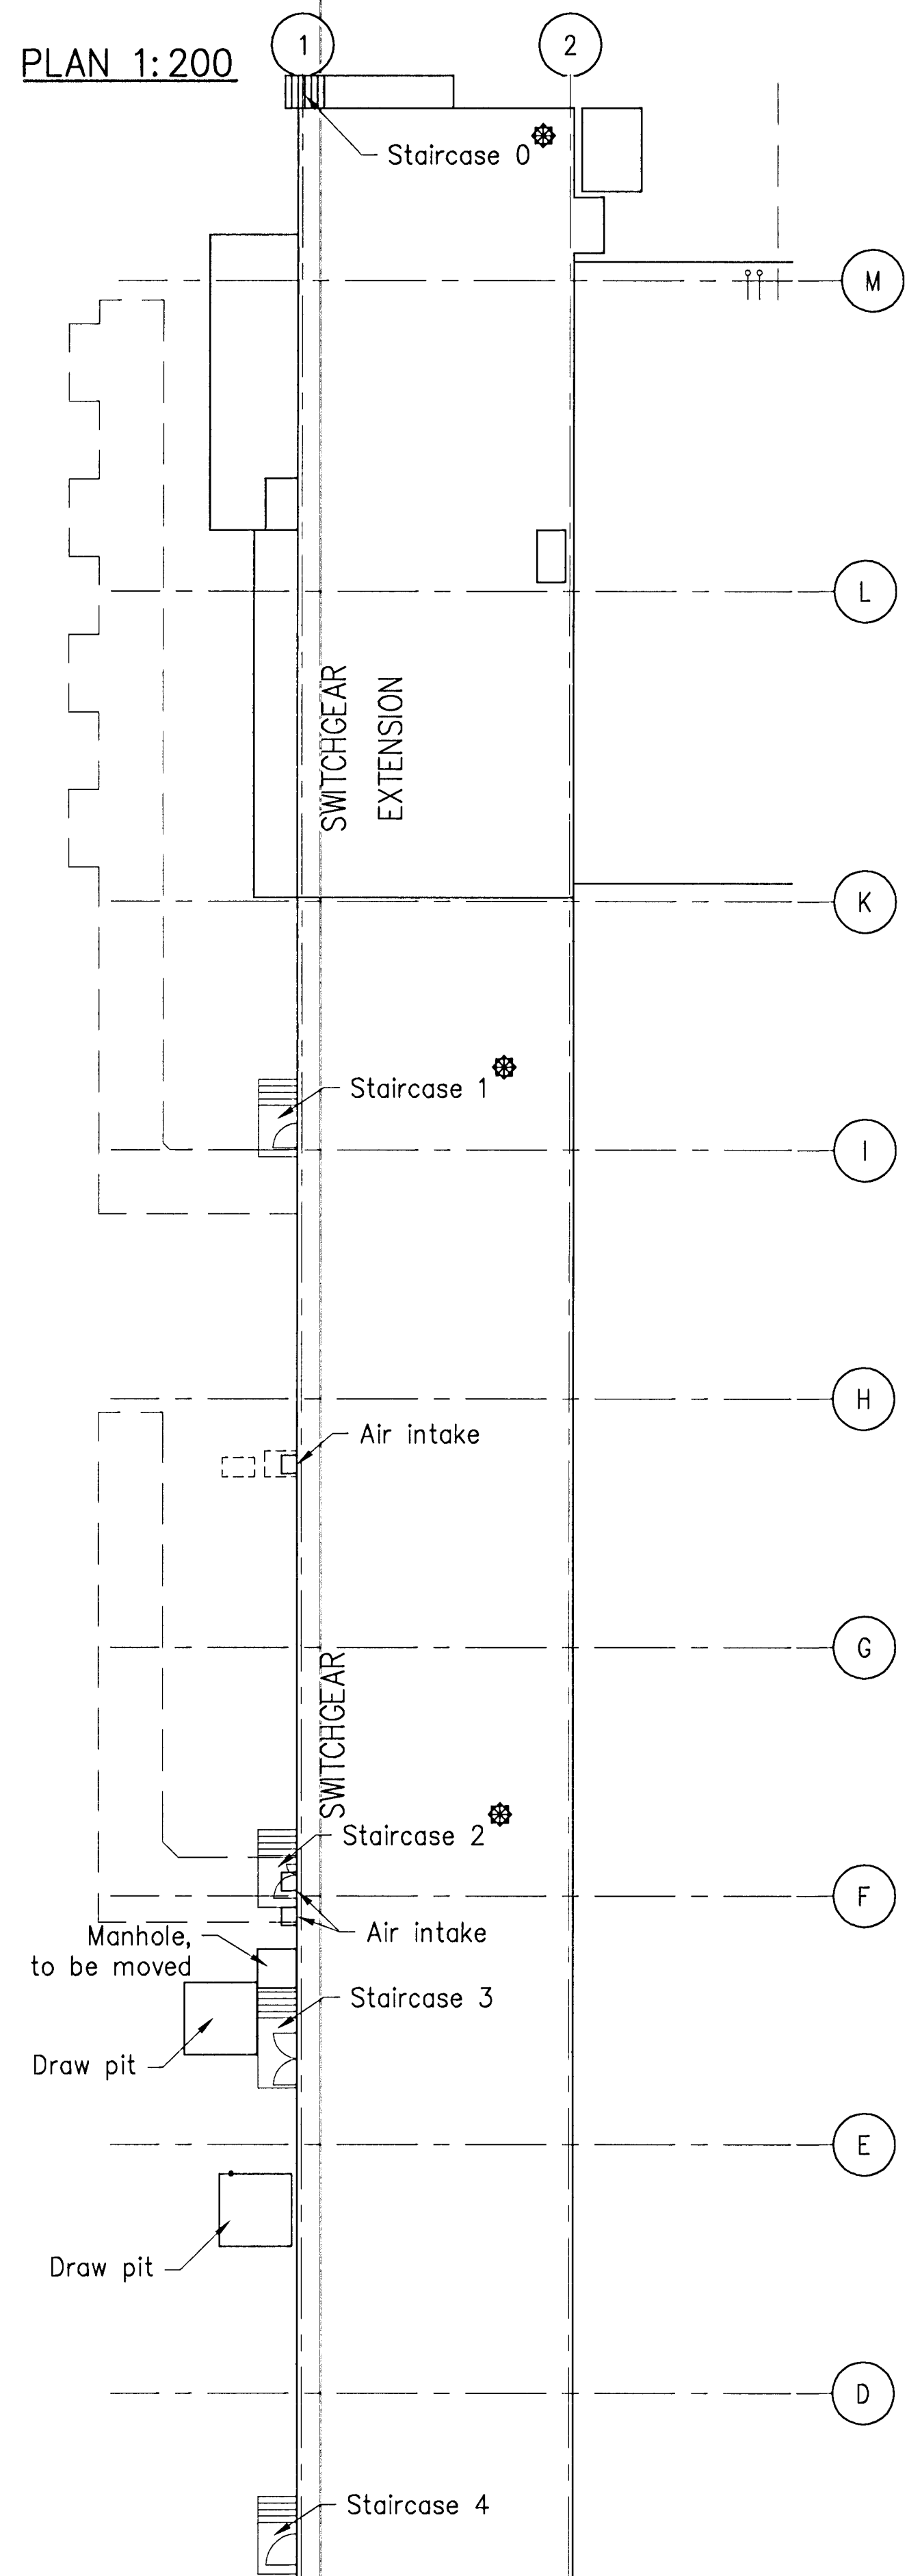

EXISTING ARRANGEMENT 1:50

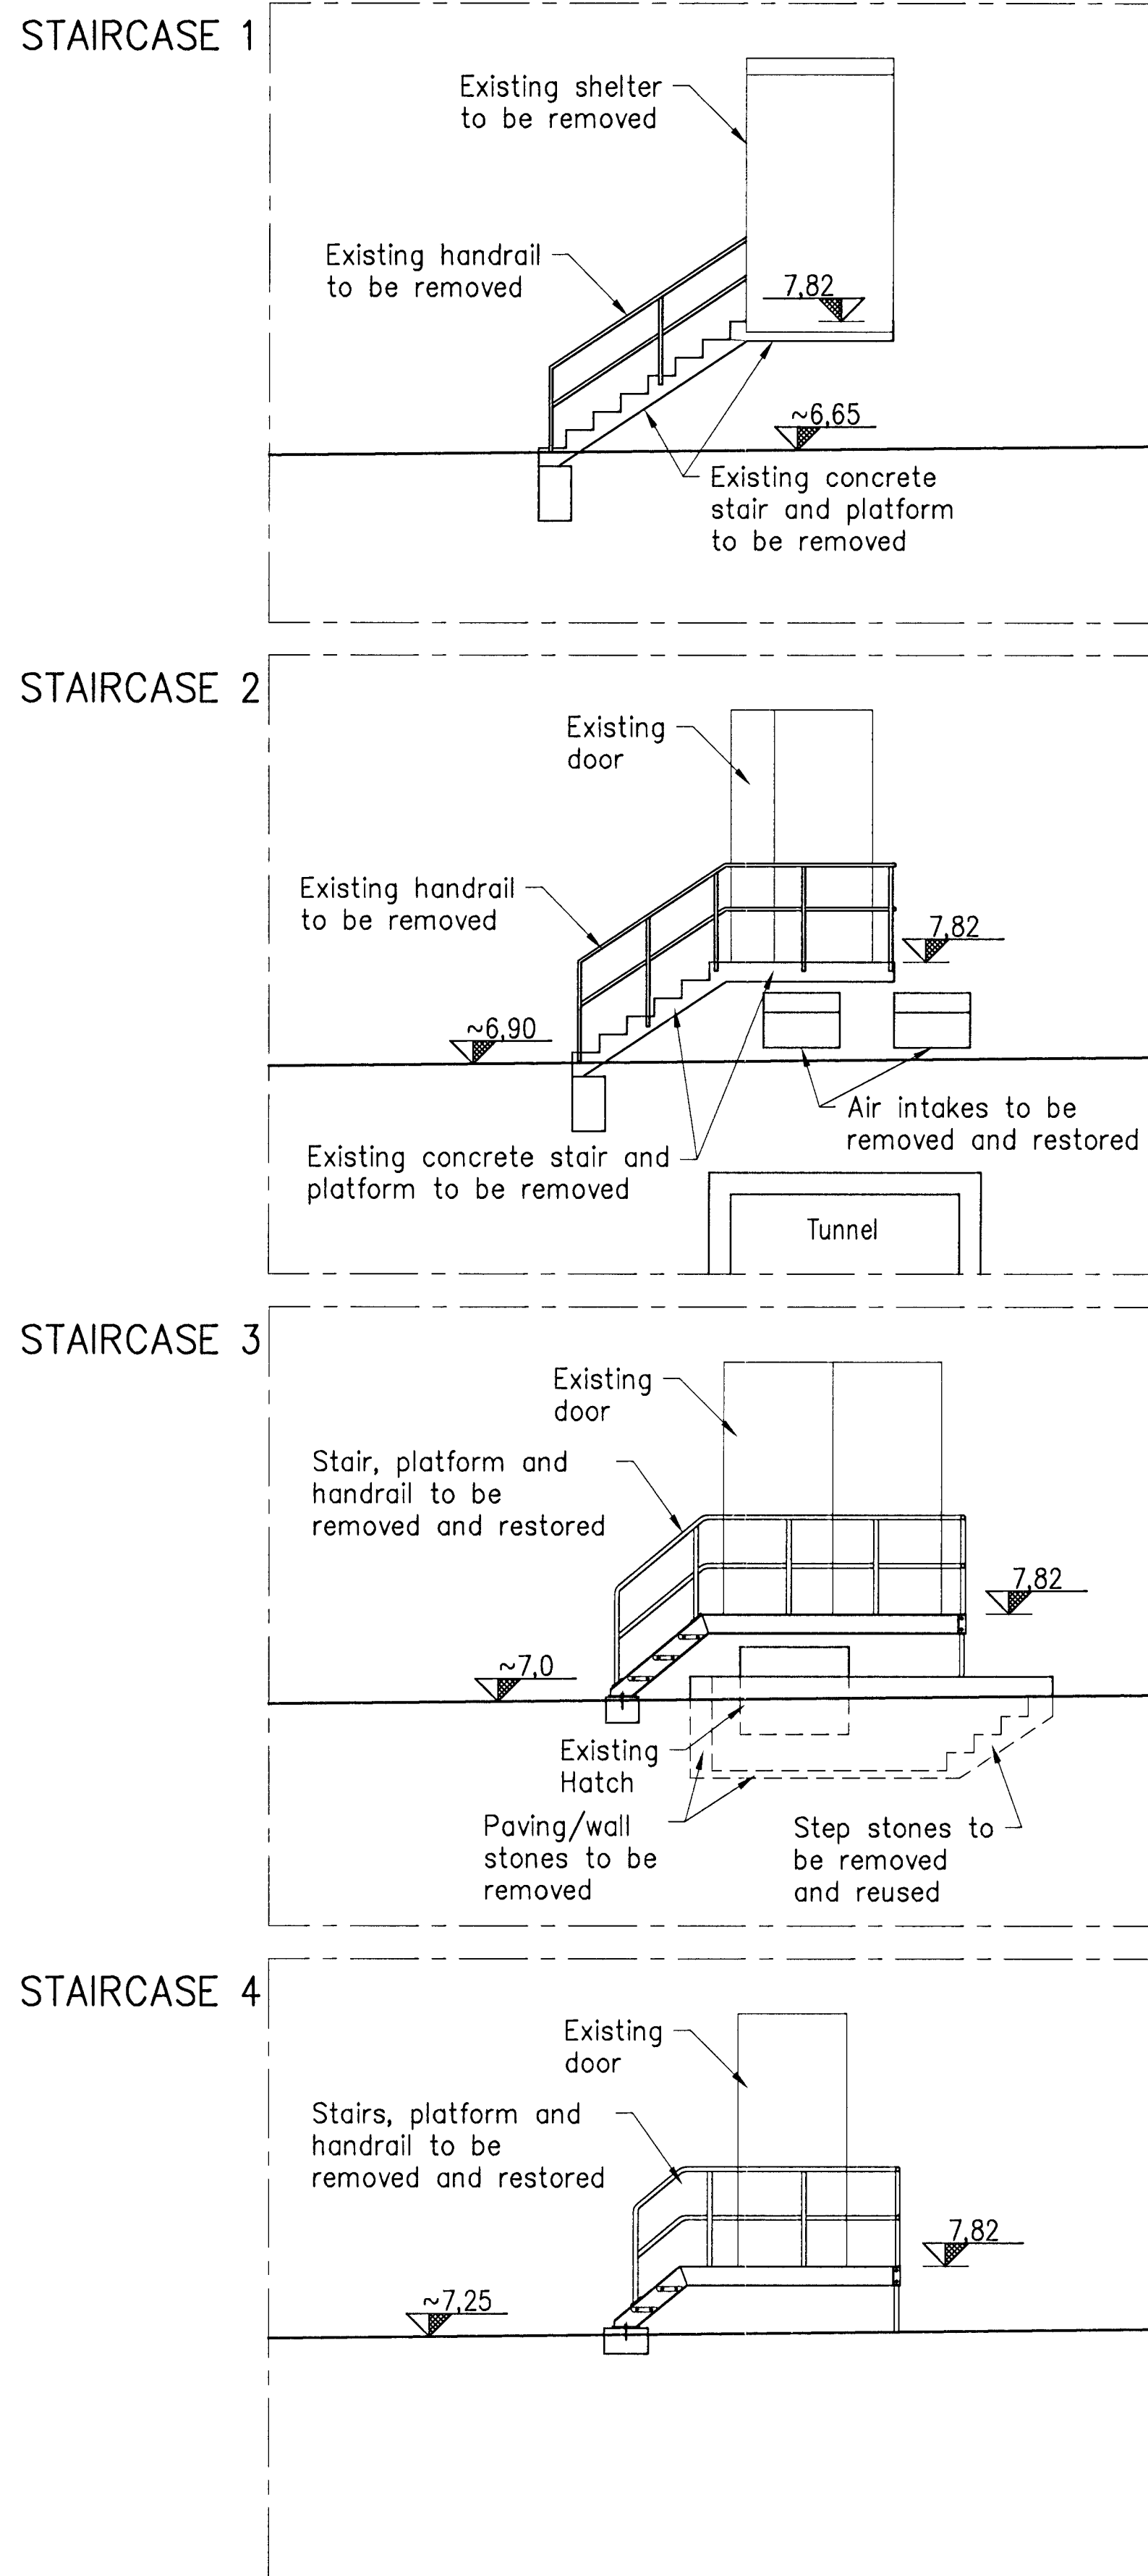


NEW ARRANGEMENT 1:50

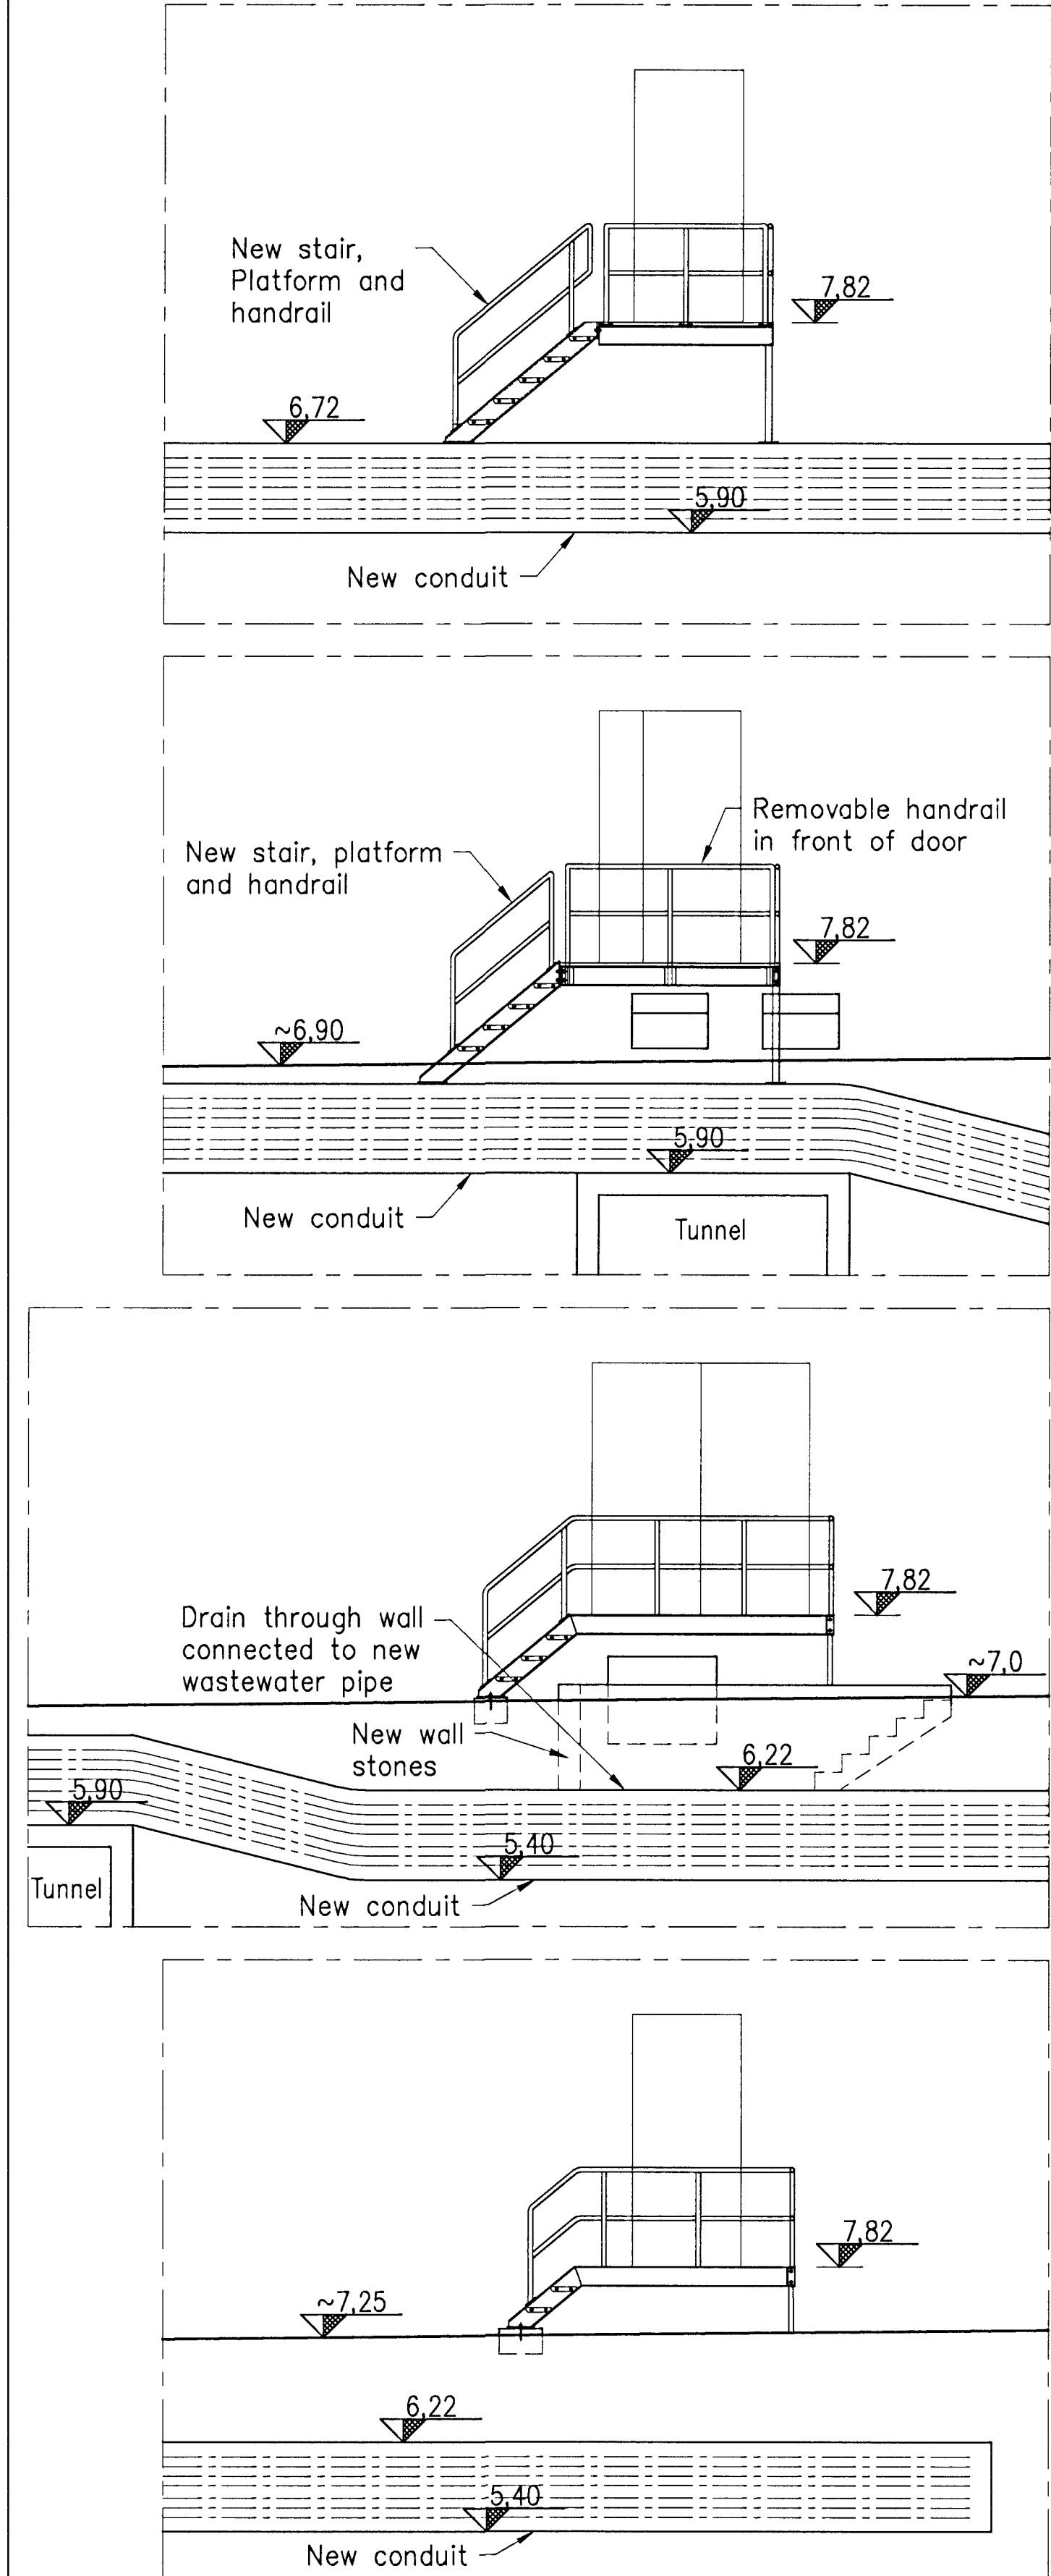

Samþykkt þann
01 OCT 2012
Byggingafulltrúinn / Hafnaráfangi
F.h. Sigurður Steinar Jónsson

Níki Indriðarson
Kt. 181144-3949
NI

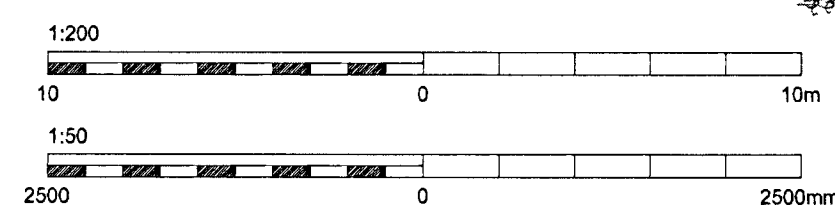

Skýringar:
Legend:
* For details see drw. IDP-410-ZA-015-313

C:\DP\01\IDP\400 - Reduction\410 Substation\Drawings\Civil\IDP-410-C0-015-101.dwg

3	As built	2012.06.11	GMG	NI	64	64	64
Ólg nr	Rev no	Lýsing	Description	Dagsetning	Hor./Bn	Yfir	Notk heim
				Date	Des/Drw	Old	Suppl
							ISAL Rel

This drawing is the property of Rio Tinto Alcan Iceland Ltd. and handed out for personal use only. It may neither be copied nor made available to others without permission of Rio Tinto Alcan Iceland Ltd. The receiver is liable for any misuse.

Scale: 1:50/200
Dimensions without tolerances according to ISO 2768-1 medium.

Dagsetning / Date: 2011.07.19	
Hannað / Designed: GMG	Tekn / Drawn: GMG
Verktaki / Supplier: HRV	
Tekn.nr.verktaka / Supplier drw.no: IDP-410-C0-015-101	
Samþykkt / Approved: NI	Yfir / Chkd: NI
Hluti of / Part of:	

IPU 410 - POWER AREA
AREA ALONG SWITCHGEAR BLD.
PLAN AND VIEWS
DEMOLITION AND RECONSTRUCTION

RioTintoAlcan

Flokkur nr.:	Blað nr.:	Nasta bl. nr.:
4011	01188	
Kostn.nr.-Cono. / Bún.nr.-Eq.no	AKS	
251202	UB01	
ISAL Tekn.nr. ISAL / Drw.no. of ISAL	Breyt./Rev.	
251202	A	

ISAL Yfirlið og skráð, dags / ISAL Checked, date ISAL Samþykkt, dags / ISAL Approval, date