


Níels Indriðason  
 Kt. 181144-3949  
 NI

**WALL IN LINE 6**  
 OUTSIDE VIEW

BEFORE DEMOLITION

AFTER DEMOLITION

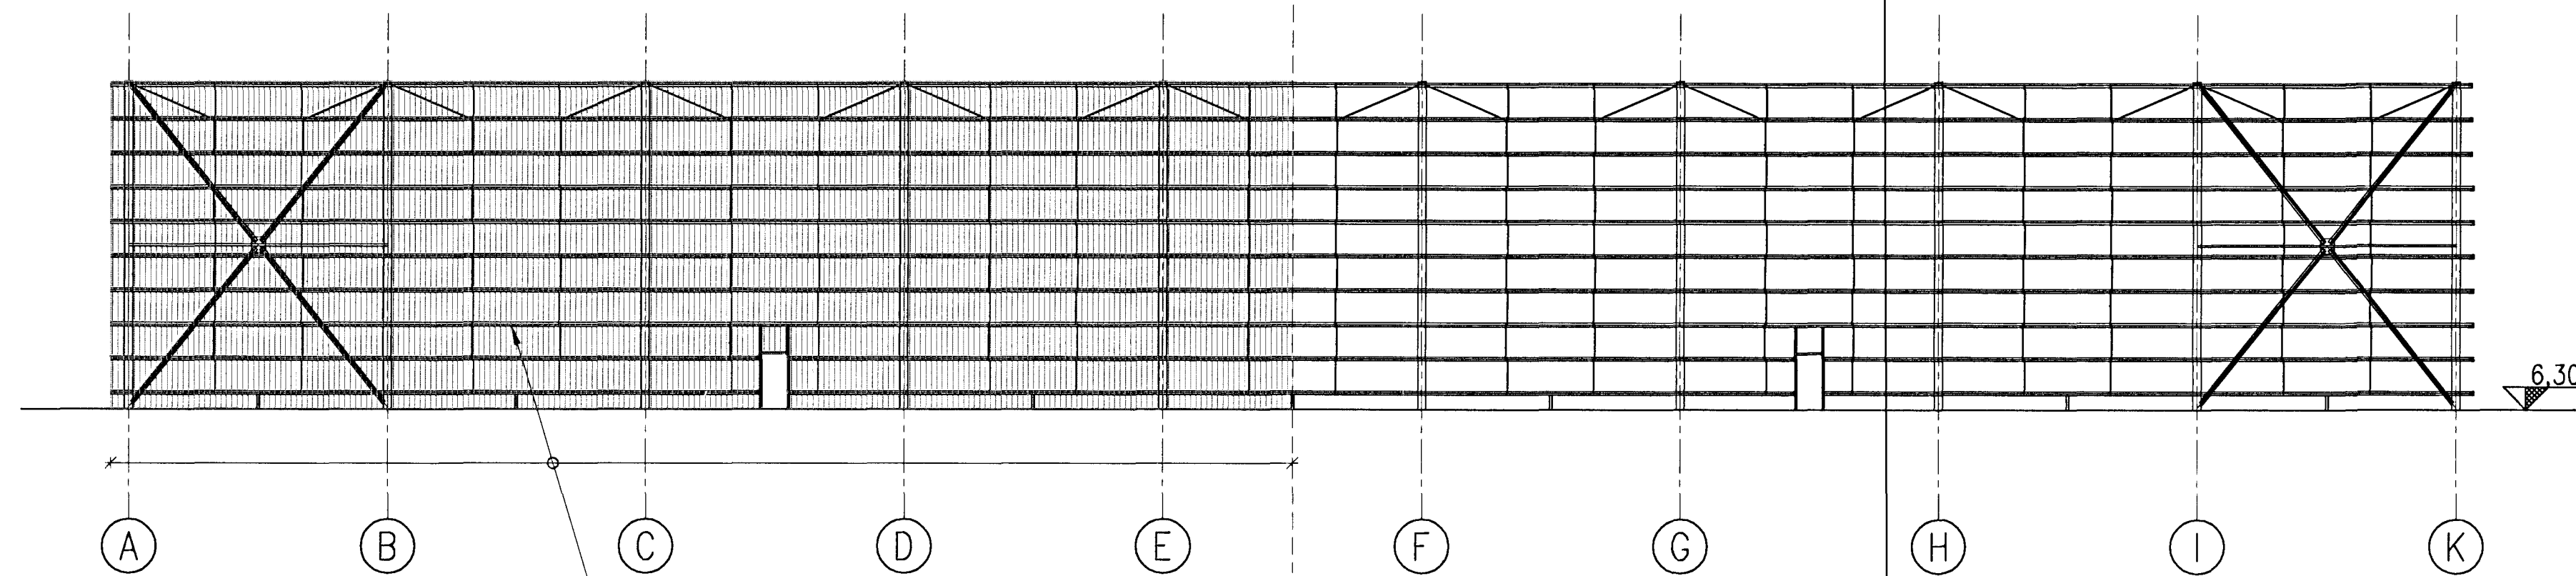


In this area following shall be demounted and disposed of:

- All cladding.

**WALL IN LINE K**  
 OUTSIDE VIEW BEFORE DEMOLITION

**WALL IN LINE K**  
 OUTSIDE VIEW AFTER DEMOLITION

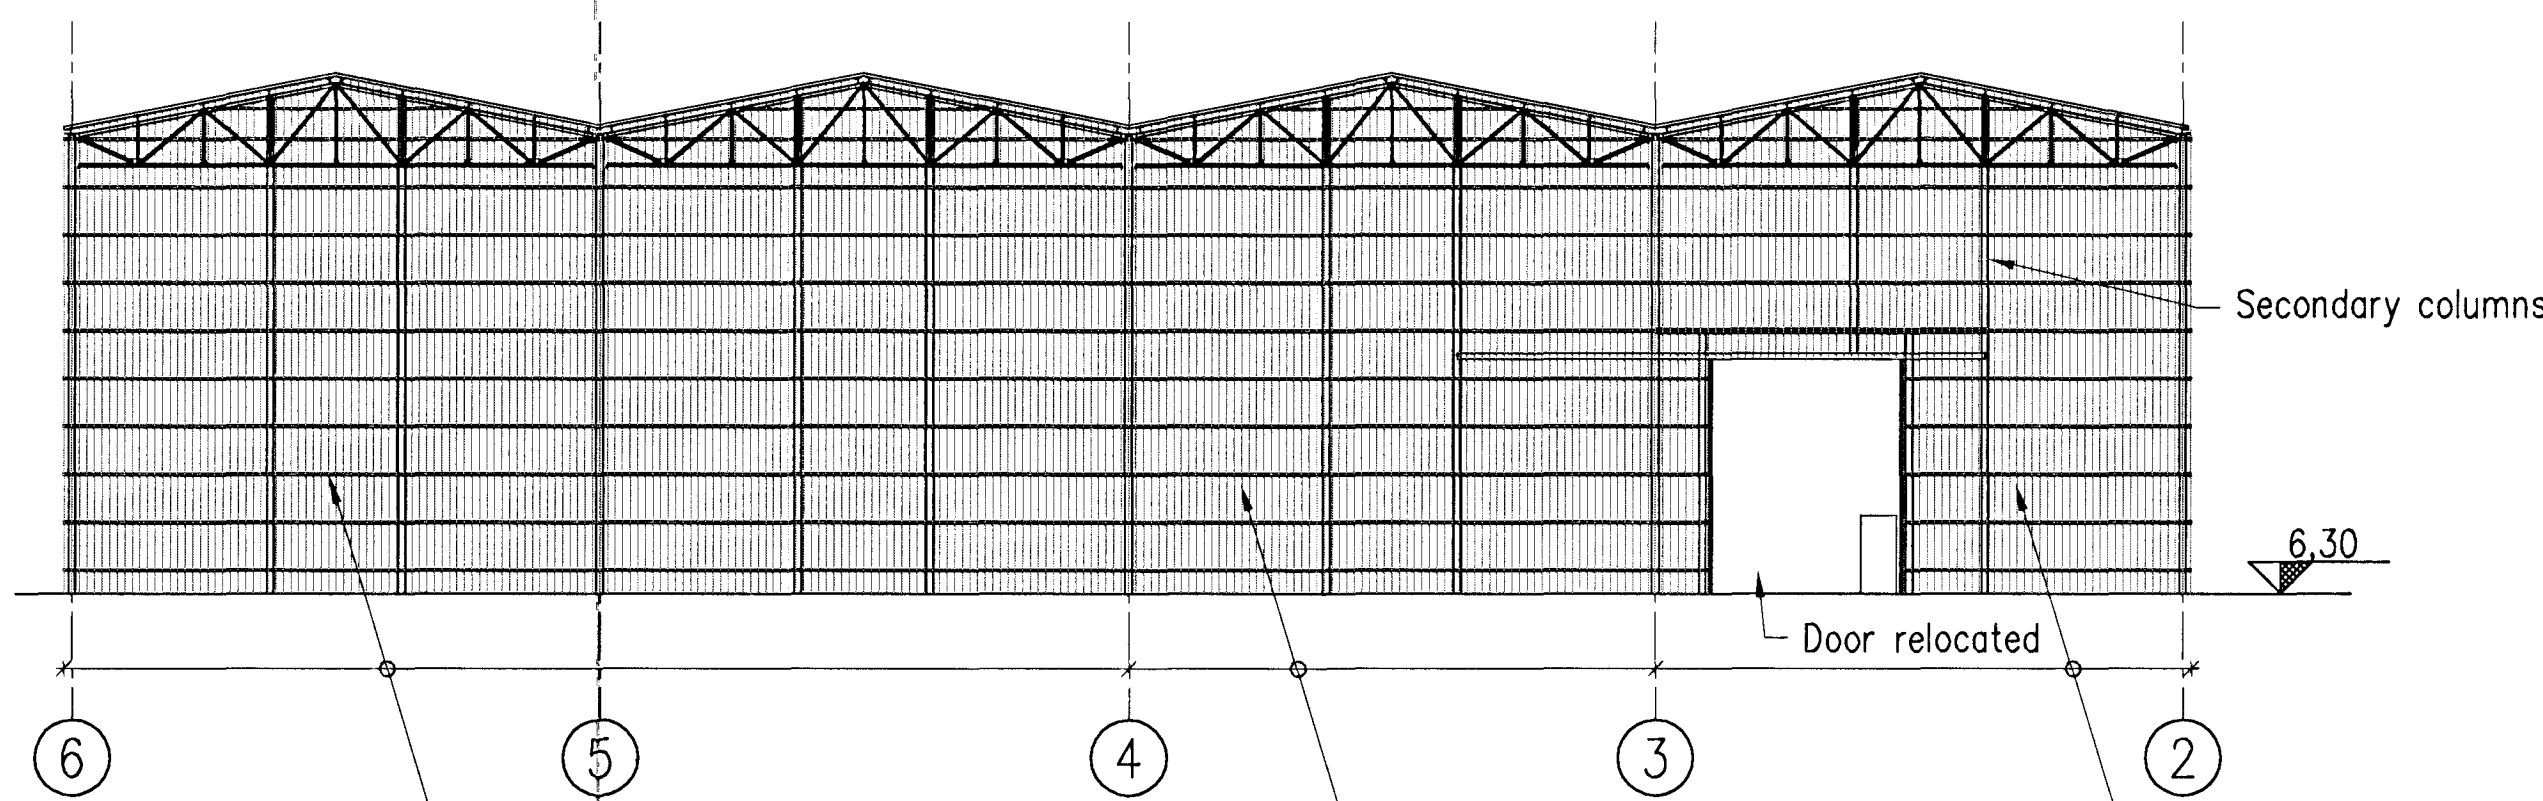


In this area following shall be demounted and disposed of:

- All cladding.
- All wall girts.
- All secondary columns.

In this area no items shall be demounted or disposed of.

In this area following shall be demounted and disposed of:

- All cladding.
- All wall girts.
- All secondary columns.

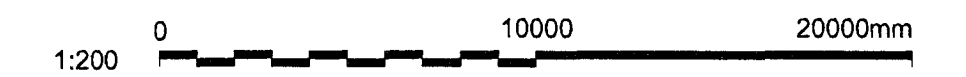

Skýringar  
 Legend:

Stig nr / Rev no	Lýsing / Description	Dagsetning / Date	Han / Tfn / Des / Drw	Yfir / Dkd	Notk heim / Suppl Rel	Notk heim / ISAL Rel
3	Record Drawing	2012.06.11	HS	NI	AK	HS

This drawing is the property of Rio Tinto Alcan Iceland Ltd. and handed out for personal use only. It may neither be copied nor made available to others without permission of Rio Tinto Alcan Iceland Ltd. The receiver is liable for any misuse.

Scale: 1:200  
 Dimensions without tolerances according to ISO 2768-1 medium.



Dagsetning / Date	2011.03.09
Hannað / Designed	Teikn / Drawn
NI	ÁFV
Verktaki / Supplier	HRV
Teikn.nr.verktaka / Supplier drw.no.	IDP-410-CO-015-001
Samþykkt / Approved	Yfir / Check
NI	HS
Hluti af / Part of	

IPU 410 - MAIN SUBSTATION		Flokkur nr.:	Blöð nr.:	Næsta bl.nr.:
220 kV SWITCHYARD BLD.		Kostn.nr.-Cano. / Blm.nr.-Eq.no	4011	01188
EXISTING WALLS IN LINE 6 AND K		Teg.teikningar / Dwg. type	AKS	UB01
DEMOLITION WORK		ISAL	Teikn.nr. ISAL / Drw.no. of ISAL	Breyt./Rev.
RioTintoAlcan		251200	A	
ISAL Yfirfarð og skráð, dags / ISAL Checked, date		ISAL Samþykkt, dags / ISAL Approval, date		