
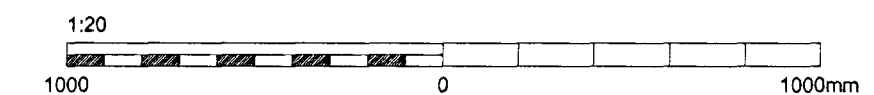


Samþykkt bann
 01 OCT 2012
 Byggingafráttir / Hafnarfráttir
 F.h. Sigurður Steinar Jónsson

Nick Indriðason
 Kt. 181144-3949 NI

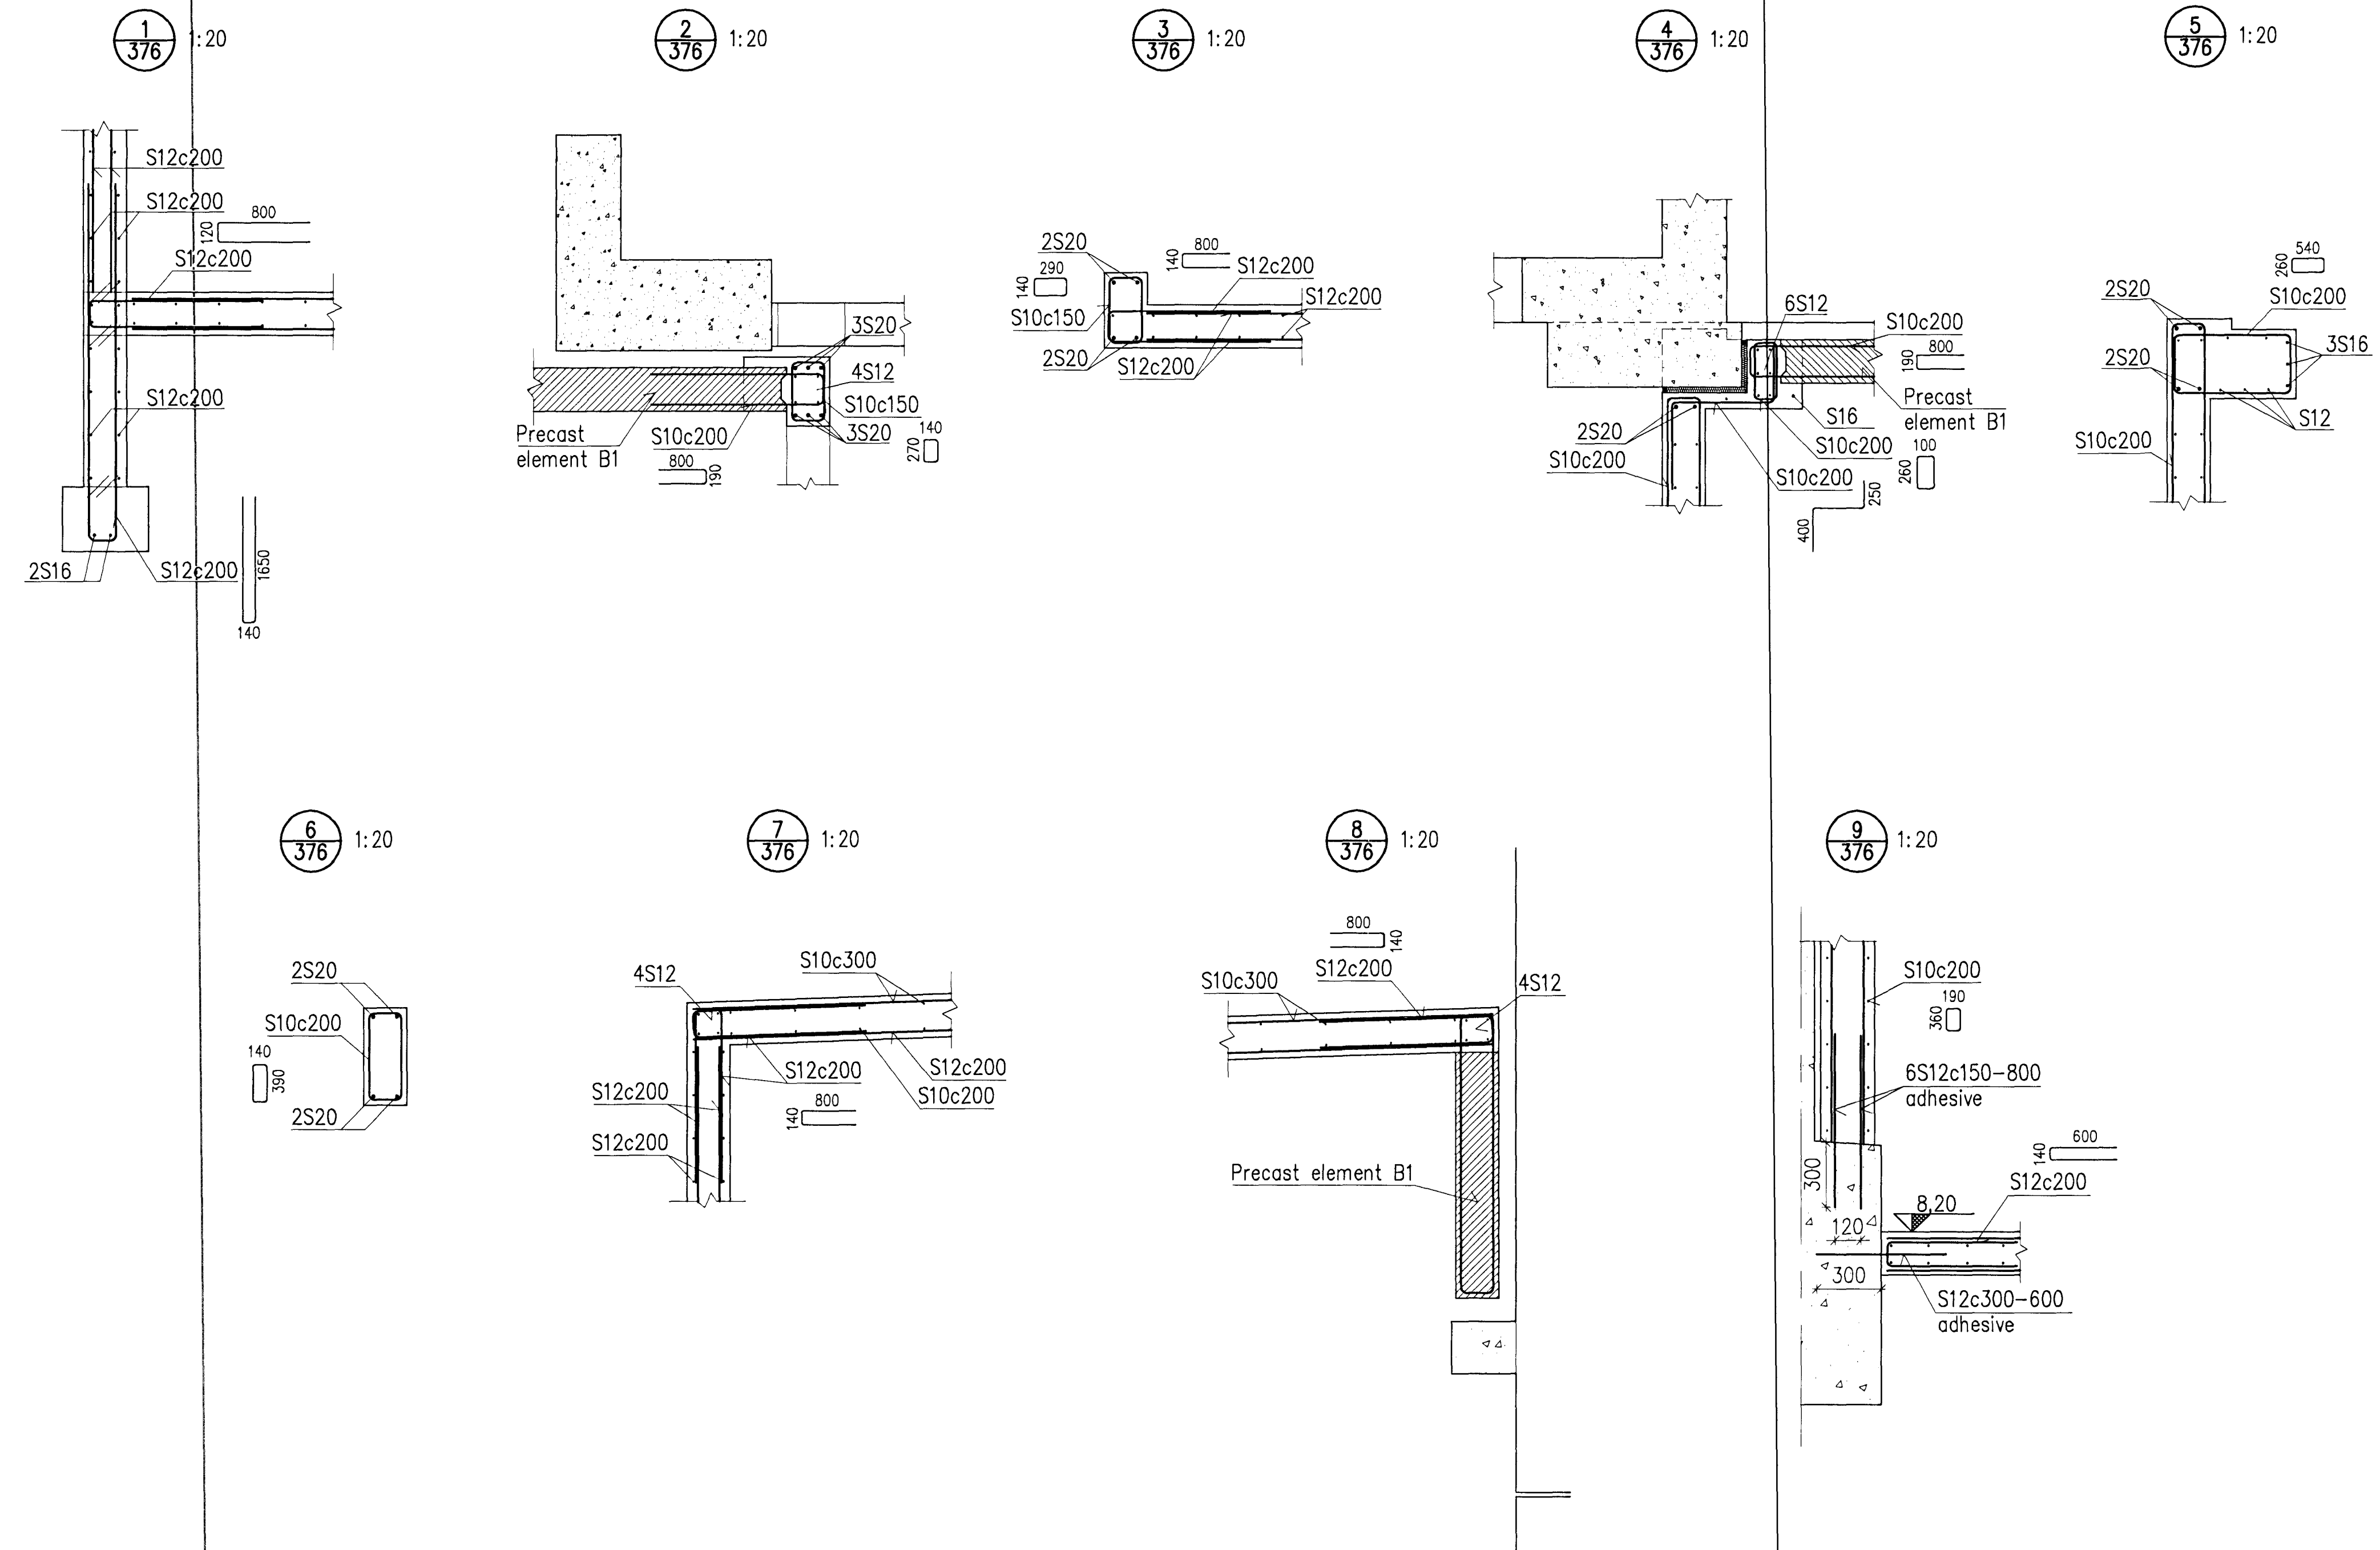

Skýringar:
 Legend:
Concrete: C30/37:XF3-32
 Precast elements are shown on
 drw. IDP-410-CA-015-388

Útg. nr. Rev. no.	12	Record drawing	2012.09.12	GMG	NI	EG	rek
Lýsing Description	Dagsetning Date	Har/Tekn. Des./Dwn	Yfir Chk	Notk. heim. Suppl. Ref.	Notk. heim. ISAL Ref.		

This drawing is the property of Rio Tinto Alcan Iceland Ltd. and loaned out for personal use only. It may neither be copied nor made available to others without permission of Rio Tinto Alcan Iceland Ltd. The receiver is liable for any misuse.

HRVA HATCH
 ISAL PRODUCTION OPERATIONS

Dagsetning / Date: 2011.02.21
 Hannað / Designed: GMG
 Tekn. / Drawn: GMG
 Verktaki / Supplier: HRV
 Tekn.nr.verktaka / Supplier drwns: IDP-410-CA-015-377
 Samþykkt / Approved: NI
 Yfir / Chkd: NI
 Hluti af / Part of:

IPU 410 - RECTIFIER BUILDINGS
 INTAKE BUILDING PL 2
 SECTIONS
 REINFORCEMENT

Flokkur nr.: 4011
 Blað nr.: 13982
 Násta bl. nr.:
 Kostn.nr.-Cena. / Blunn.-Eq.no: 251302
 UB12
 A

Rio Tinto Alcan
 Alcan Iceland Ltd
 Straumavík
 IS-222 Hafnarfordur
 Ísland

Tekn.nr. ISAL / Drwno. of ISAL: 251302
 Breyt./Rev.: A
 ISAL: 16.09.08 og skráð, dags / ISAL Checked, date
 ISAL: Samþykkt, dags / ISAL Approved, date