


Samþykkt þann  
 01 OCT 2012  
 Byggingafrulltrúinn í Hafnarfirði  
 F.h. Sigurður Steinar Jónsson

Níels Indriðason  
 Kr. 181144-3949

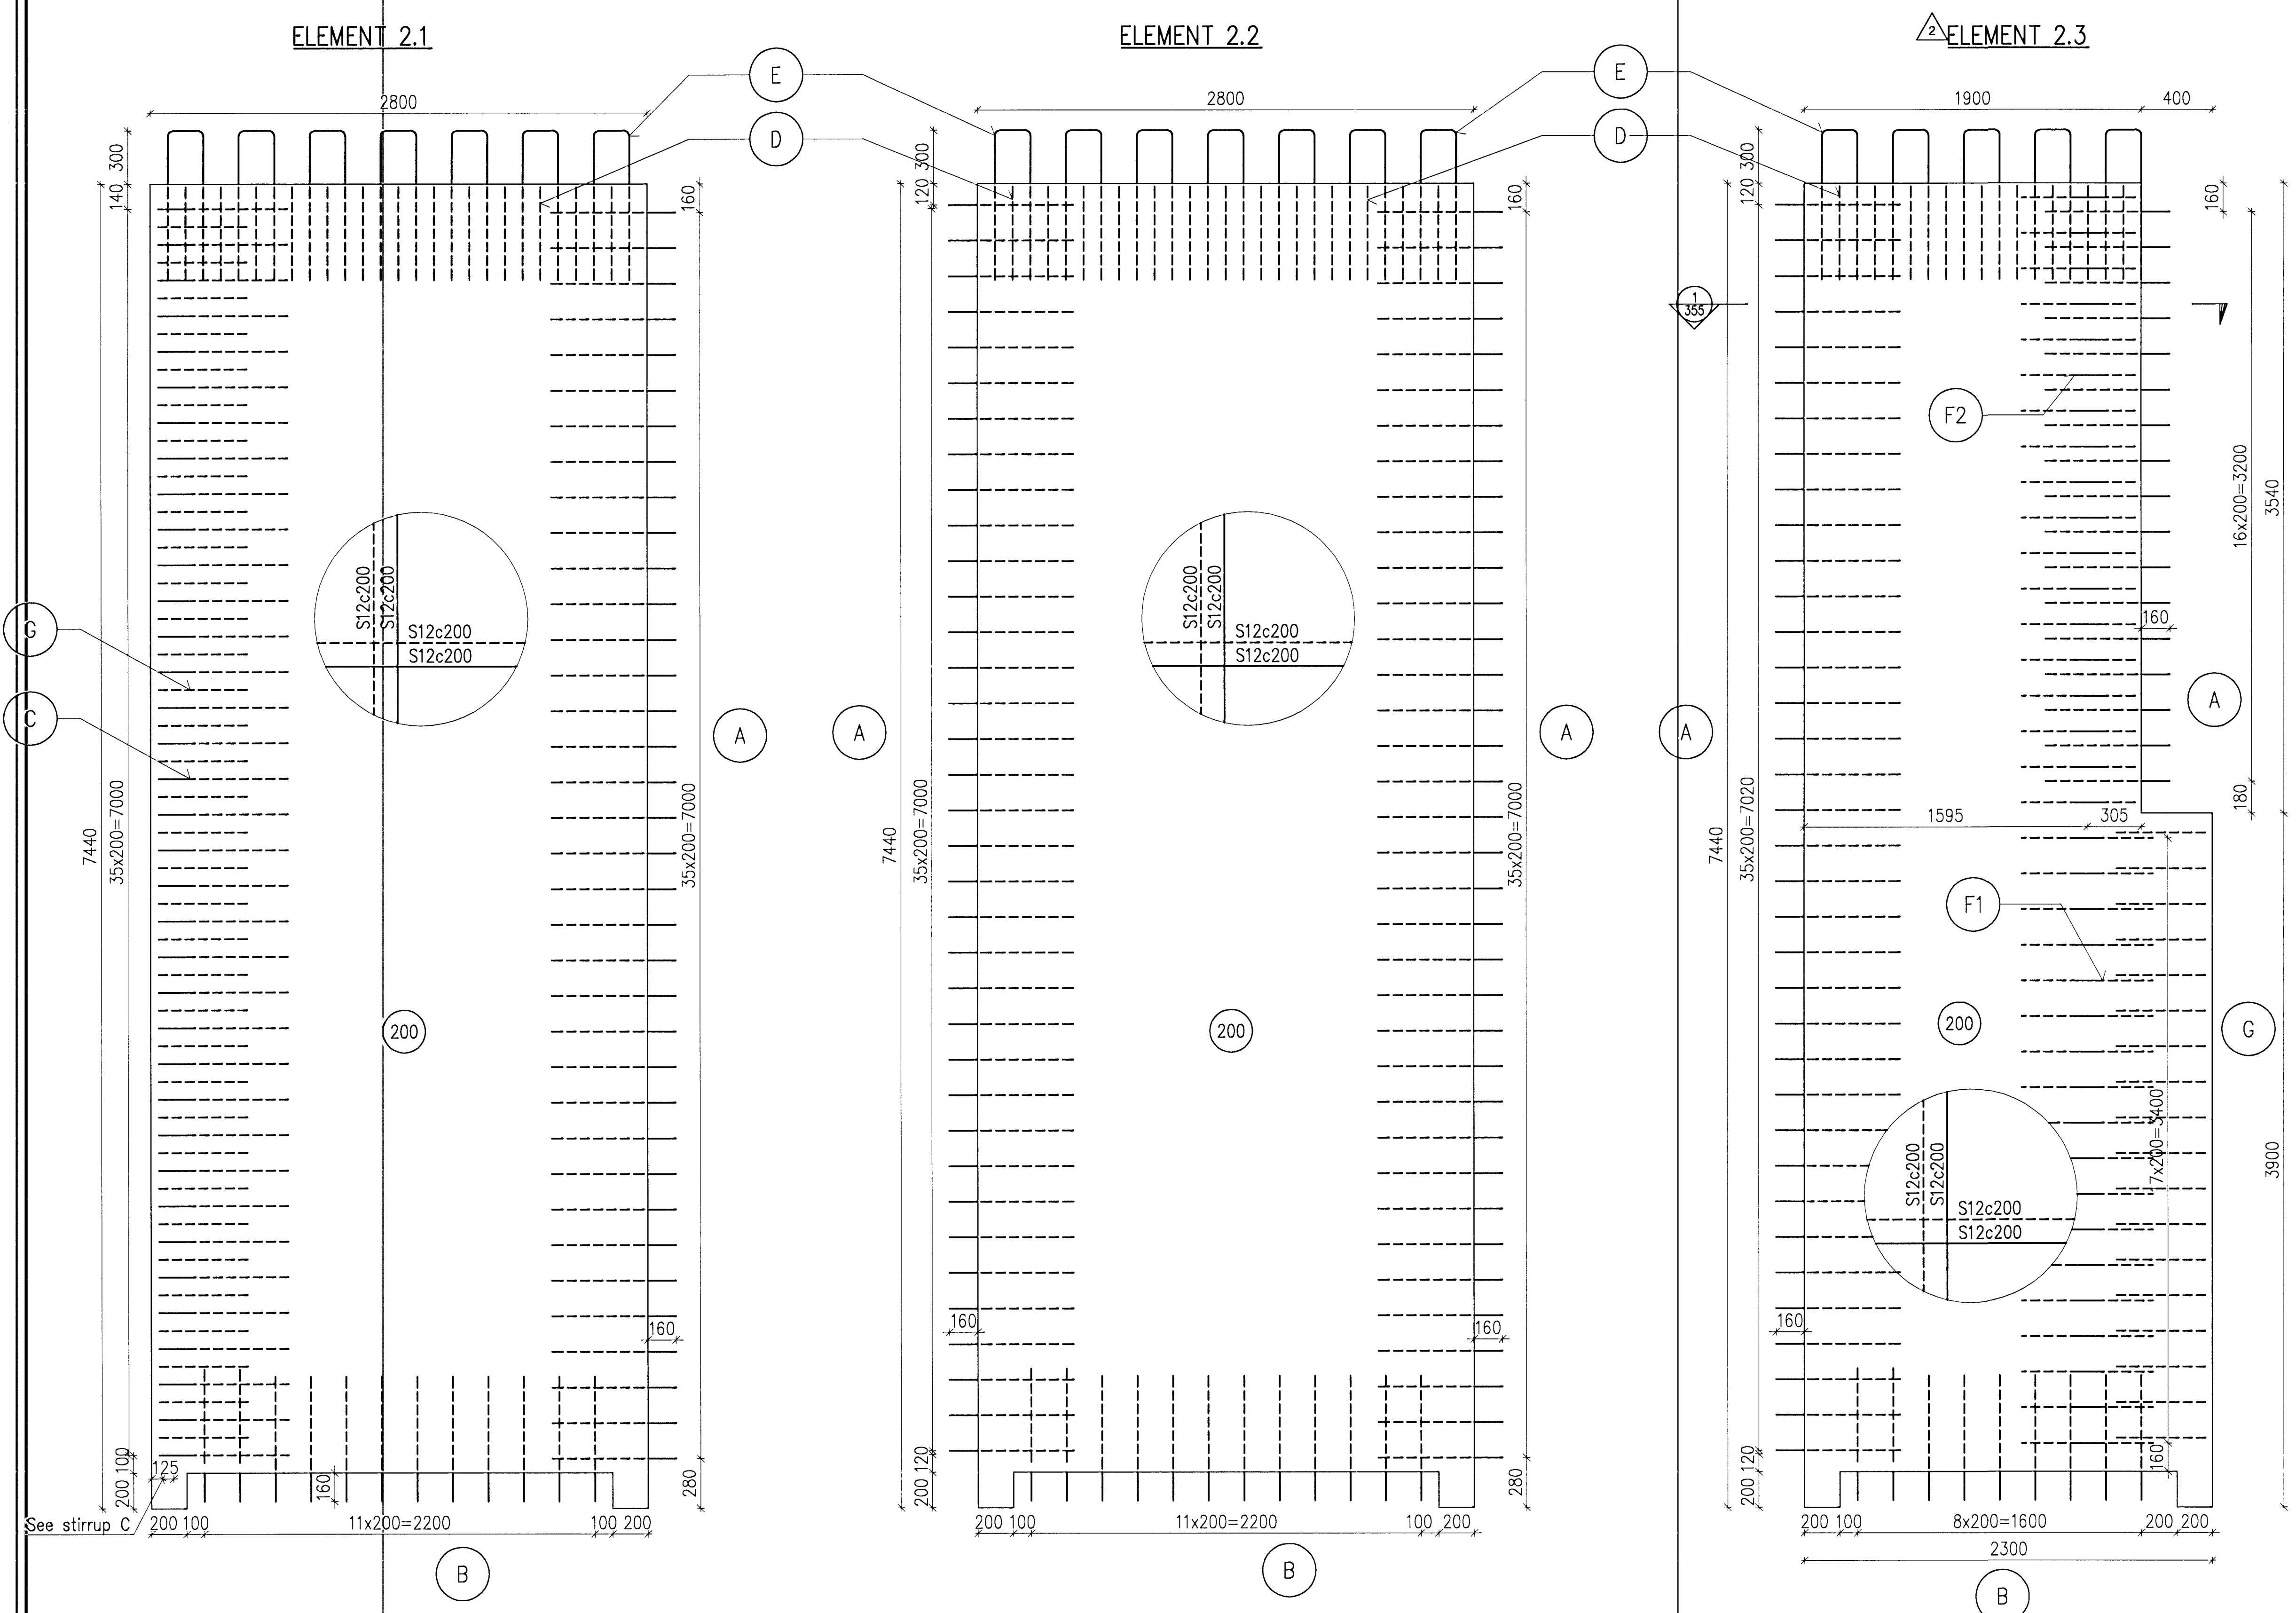

Skýringar:  
 Legend: Stirrups details see drawing 352.

3	Record drawing		2012.09.12	HS	NI	bag	rek		
Ölg nr	Rev no	Lýsing	Dagsetning	Has/Ton	Yfir	Nok heim	Nok heim	ISAL	Rei
		Description	Date	Des/Drw	Old	Suppl	SAI	Rel	

This drawing is the property of Rio Tinto Alcan Iceland Ltd. and handed out for personal use only. It may neither be copied nor made available to others without permission of Rio Tinto Alcan Iceland Ltd. The receiver is liable for any misuse.

Scale: 1:20  
 Dimensions without tolerances according to ISO 2768-1 medium.



Dagsetning / Date	2011.03.07
Hönnuð / Designed	HS
Tekn / Drawn	AFV
Verktaki / Supplier	HRV
Tekn.nr.verktaka / Supplier drwno.	IDP-410-CA-015-353
Samþykkt / Approved	NI
Hluti af: / Part of:	

IPU 410 - RECTIFIER BUILDINGS		Flokkur nr.:	Blöð nr.:	Nasta blnr.:
B5/S2		Kostn.nr.-Cóno. / Búnr.-Eq.no	4011 13982	
PRECAST ELEMENTS		AKS		
REINFORCEMENT		UB12		
RioTintoAlcan		ISAL Tekn.nr. ISAL /Drwno. of ISAL	Breyt./Rev	
ISAL Samþykkt, dags / ISAL Checked, date		251296	A	
ISAL Yfirforð og skráð, dags / ISAL Approval, date				