



WALL ELEMENTS OVERVIEW

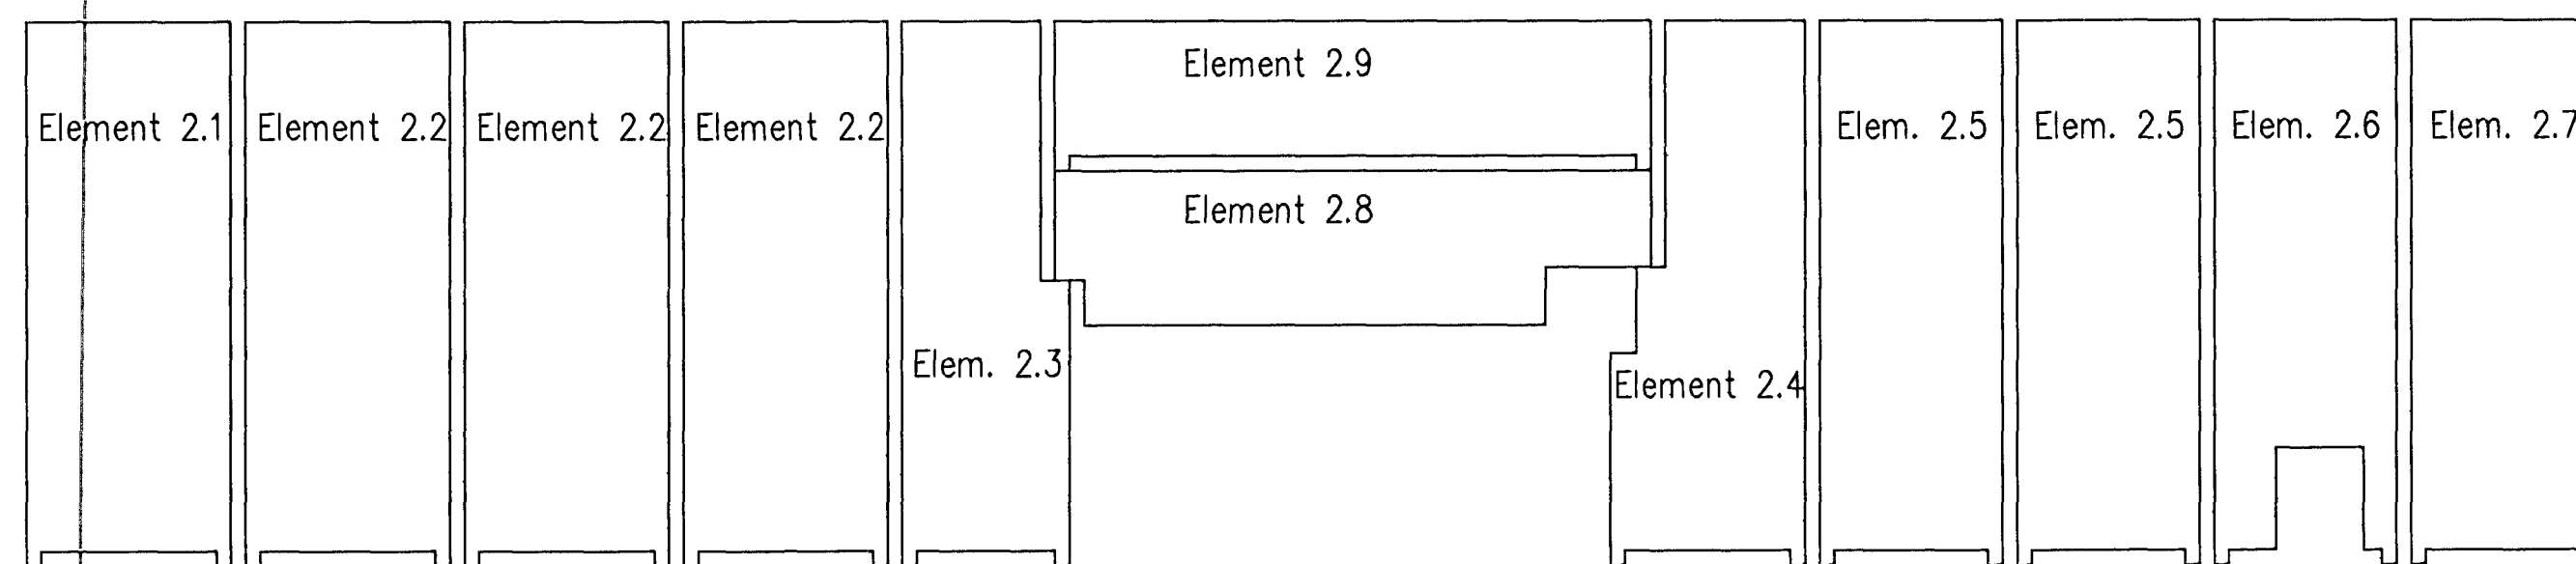


Samþykkt þann
 01 OCT 2012
 Byggingafultrúinn / Hafnarátt
 Fh. Sigurður Steinar Jónsson

STIRRUPS *Nick Indriðason*
 Kt. 181144-3949 *NI*

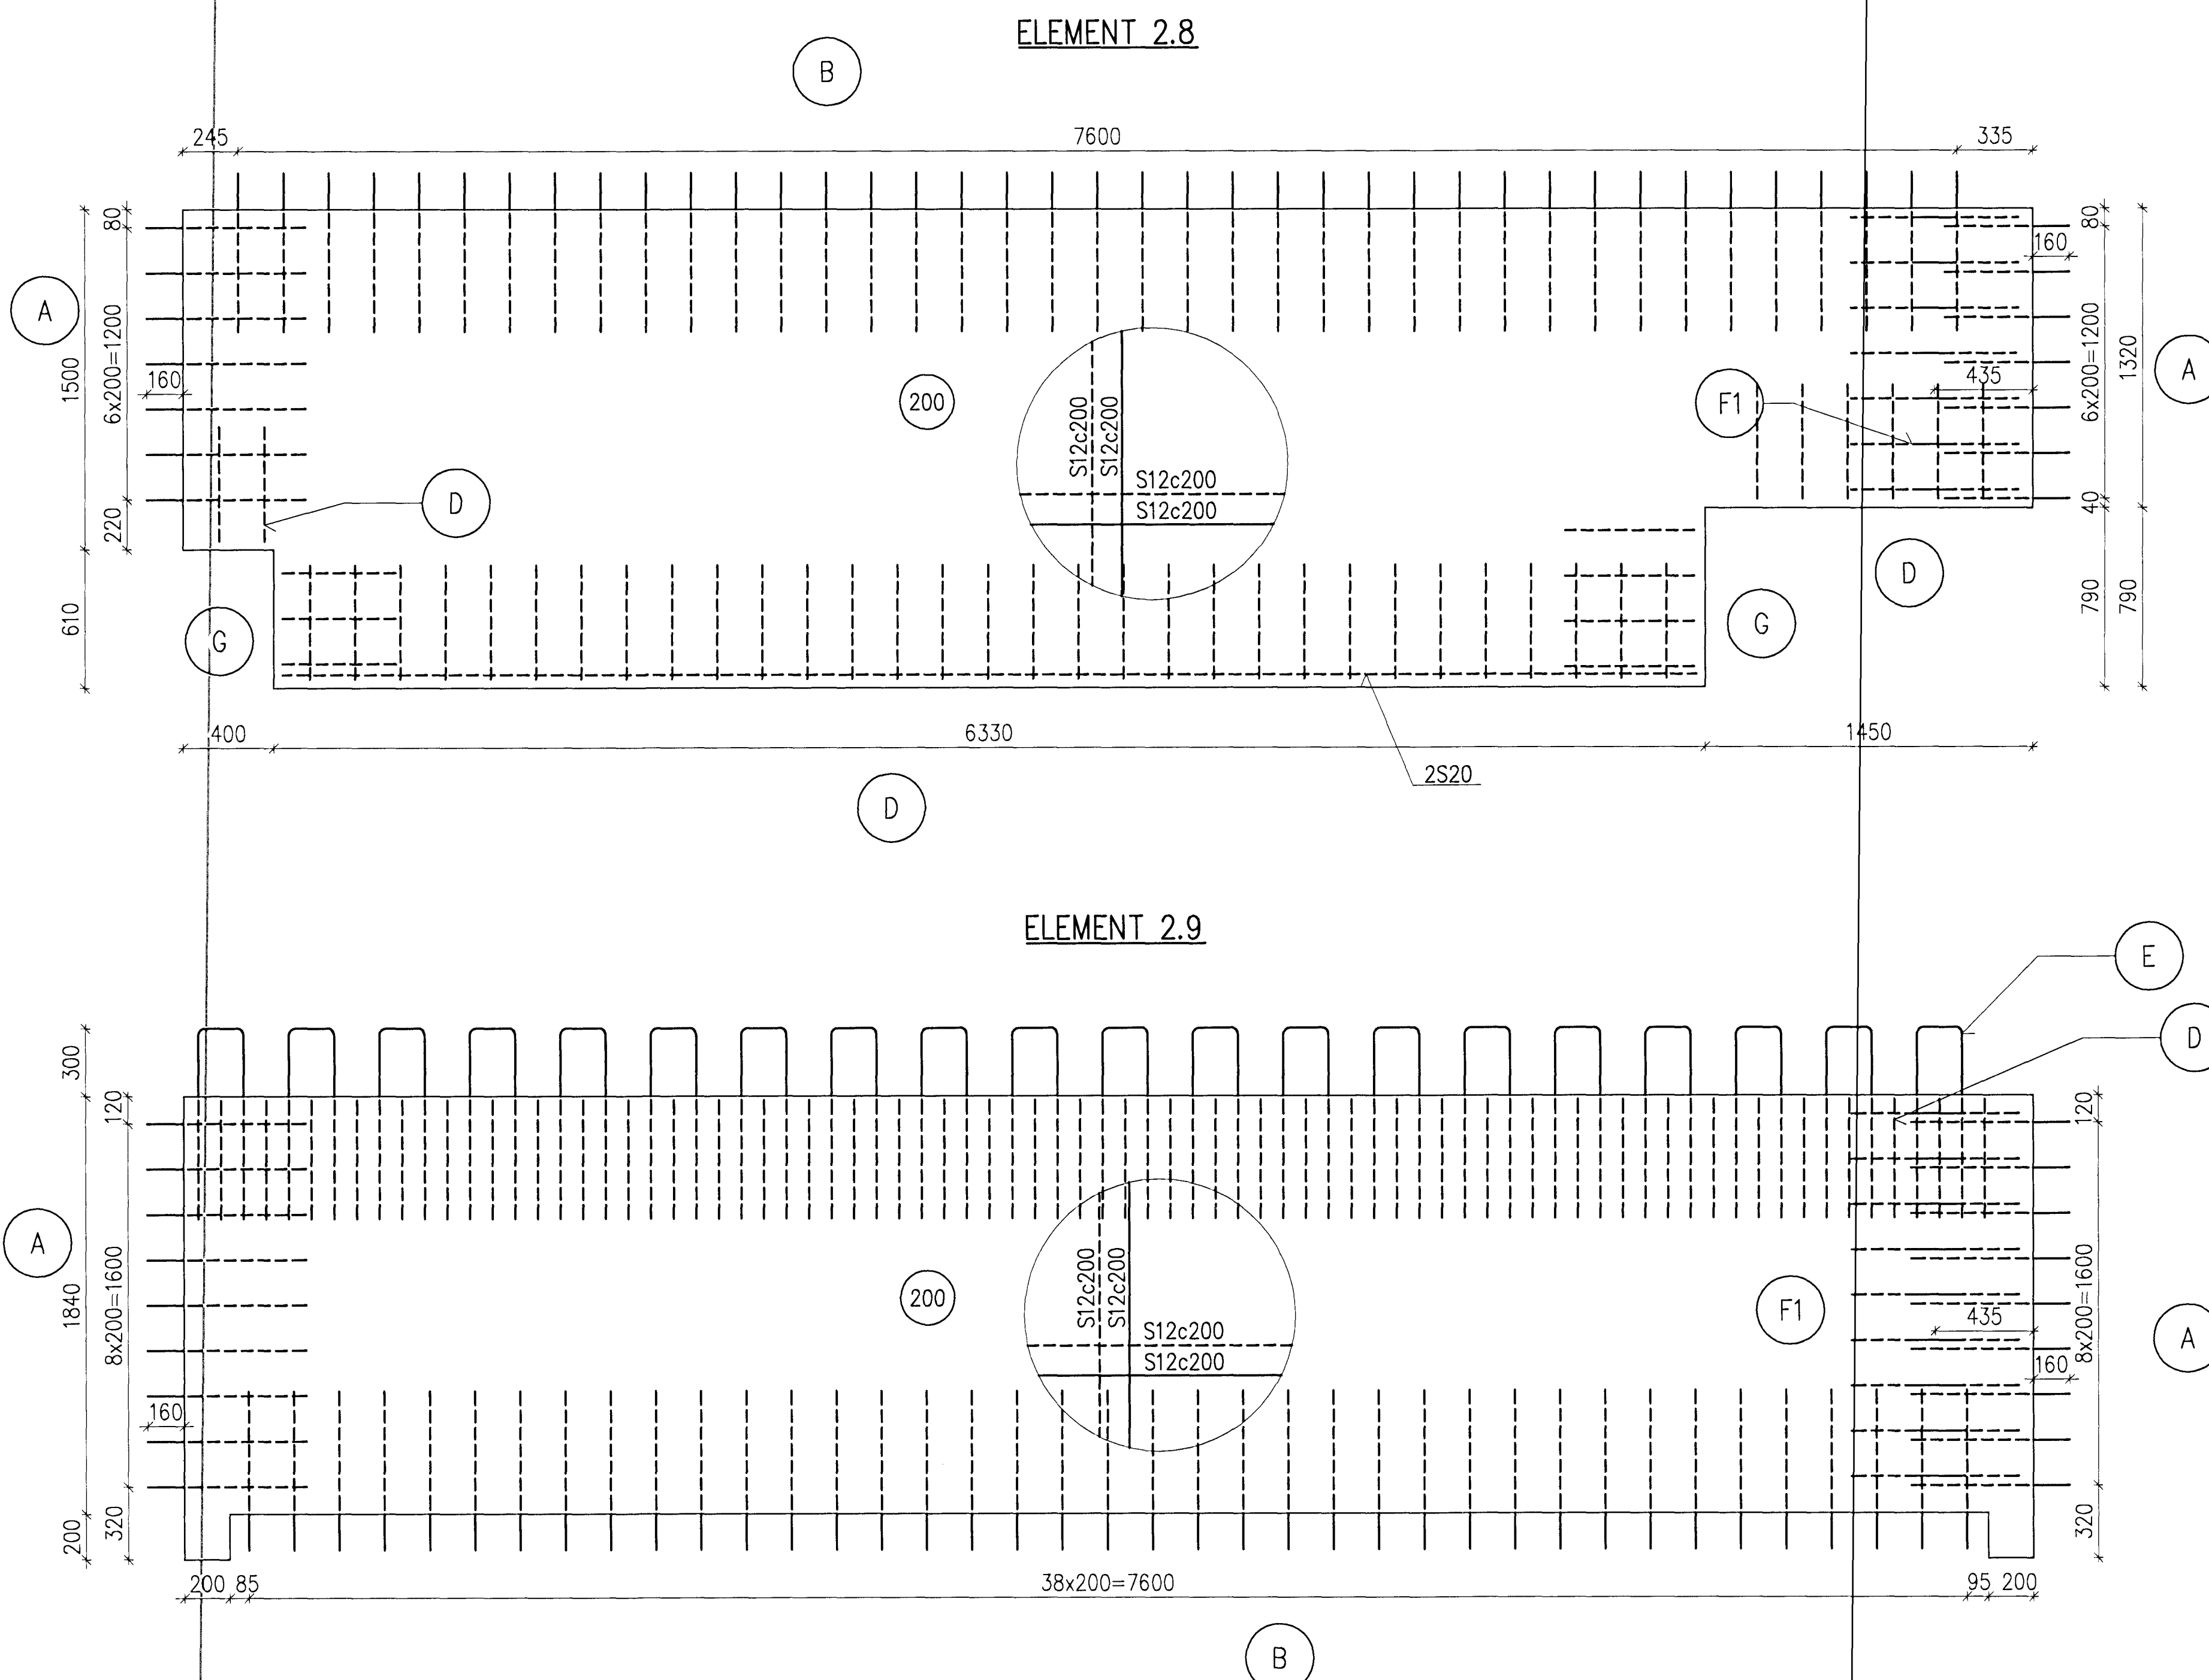

- (A) S12c200
- (B) S12c200
- (C)
- (D) S10c200
- (E) S12c400
Se section 1
Dawing 333
- (F1) S12c200
Se section 1
Dawing 333
- (F2) S12c200
Se section 1
Dawing 333
- (G) S10c200
- (H) S10c200
- (I) S12c200

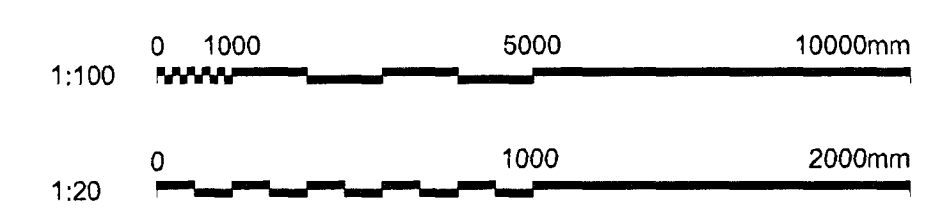

Skýringar:
 Legend:
 Lifting arrangement of elements is not shown. To be in accordance with manufacturers prescription and as approved.
 Concrete: C30/37;XF3-32.

Þing nr / Rev. no	Lýsing / Description	Dagsetning / Date	HS	Yfir / Des. / W	NI	Byg. / Cld	MS / Nsk heim / Suppl. Rg	MS / Nsk heim / ISAL, Ref
4	Record drawing	2012.09.12	HS	NI	Byg.	MS		

This drawing is the property of Rio Tinto Alcan Iceland Ltd. and handed out for personal use only. It may neither be copied nor made available to others without permission of Rio Tinto Alcan Iceland Ltd. The receiver is liable for any misuse.

Start: A1 Mkv.: 1:100/20
 Dimensions without tolerances according to ISO 2768-1 medium.

HRVA HATCH
 REAL PRODUCTION UPGRADE

Dagsetning / Date: 2011.03.07
 Hannað / Designed: HS
 Tekni / Drawn: AFV
 Verktaki / Supplier: HRV
 Tæknirerktaki / Supplier drawing: IDP-410-CA-015-352
 Smítt / Approved: NI
 Yfir / Chd: NI
 Hluti af / Part of:

IPU 410 - RECTIFIER BUILDINGS
 B5/S2
 PRECAST ELEMENTS
 REINFORCEMENT

Flokkur nr.:
 Blað nr.:
 Nasta bl.:
 Kostnaður - Gagn. / Bl. nr. - Eign. /
 4011 13982
 AWS
 UB12
 Tækn.nr. ISAL / Drw.no. of ISAL / Breyt./Rev.
 251295 A
 ISAL Vefarð og skráð dags. / ISAL Checked, date
 ISAL Samþykkt, dags. / ISAL Approved, date