



ROOF, 1:50

Sambýkkt þann
 1 OCT 2012
 Byggingafráttárin í Hafnarfirði
 Fh. Sigurður Steinar Jónsson


Niels Indriðason
 Kt. 181144-3949 NI

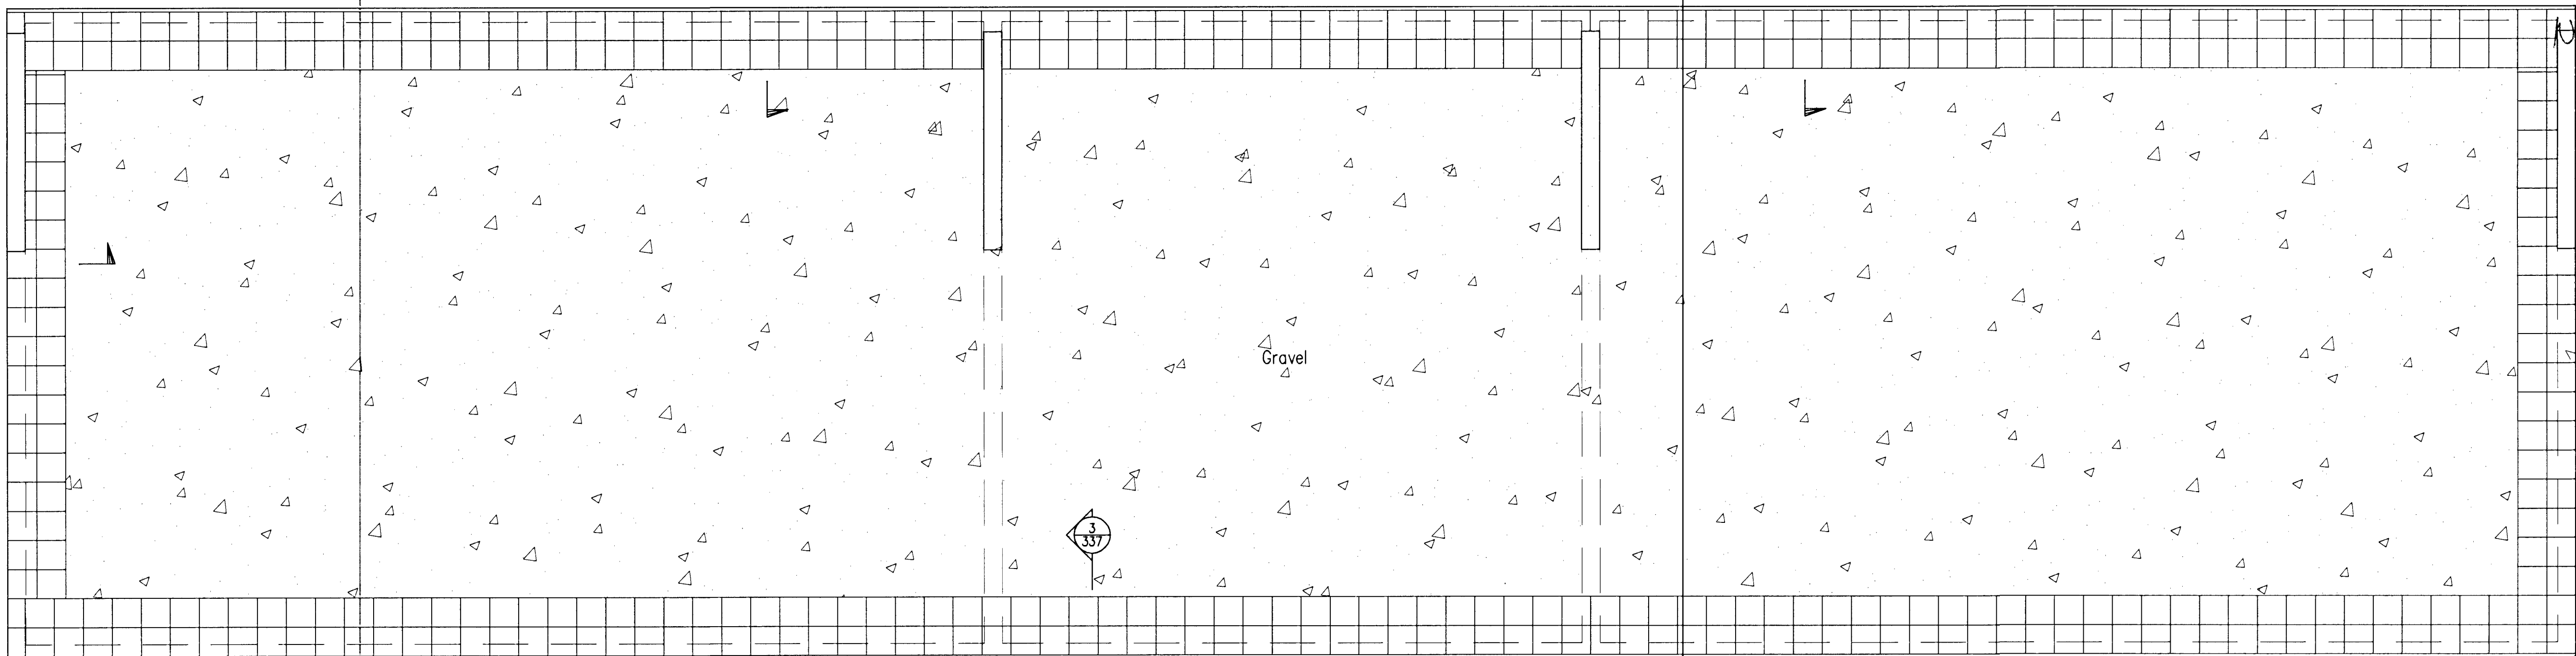

Paving stones
 400x400x50

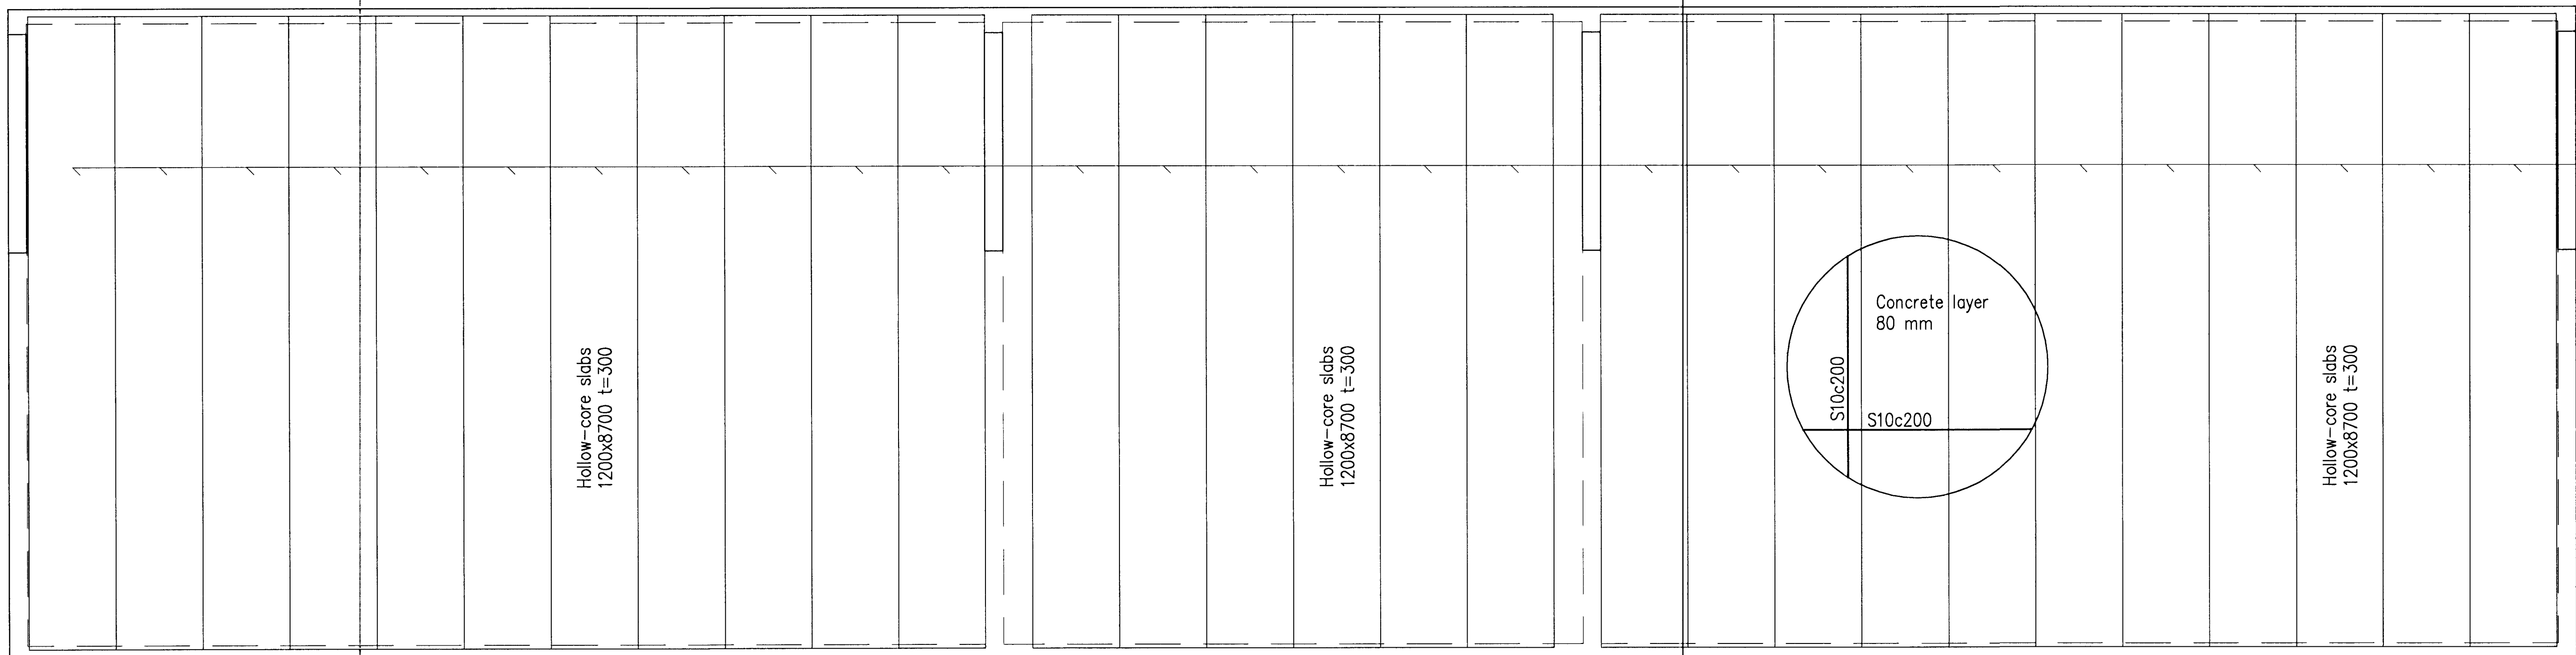

Hollow-core slab
 Load:
 Selfweight 3,0kN/m²
 Concrete 2,0kN/m²
 Gravel 2,0kN/m²
 Snow 5,0kN/m²
 Total 12,0kN/m²
 Fire resistance REI 180.

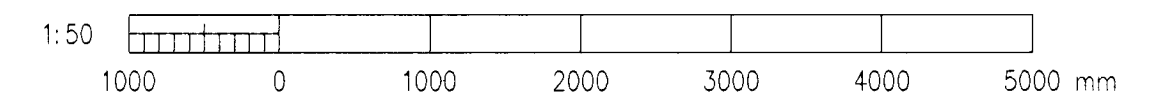

Skýringar
 Legend:

2	Record drawing	2012.09.12	HS	NI	AKG	RES			
Ólg nr	Íþing	Dagsetning	Har/Tn	Yfir	Nok heim	Nok heim	ISAL	Rei	
Rev no	Description	Date	Des/Drw	Old	Suppl	ISAL	Rei		

This drawing is the property of Rio Tinto Alcan Iceland Ltd. and handed out for personal use only. It may neither be copied nor made available to others without permission of Rio Tinto Alcan Iceland Ltd. The receiver is liable for any misuse.
 Scale: 1:50
 Dimensions without tolerances according to ISO 2768-1 medium.



Dagsetning / Date: 2011.03.07
 Hönnuð / Designed: HS
 Teikn / Drawn: LDB
 Verktaki / Supplier: HRV
 Tekn.nr.verktaka / Supplier draw no.: IDP-410-CA-015-336
 Samþykkt / Approved: NI
 Yfir / Chkd: NI
 Hluti af: / Part of:

IPU410-RECTIFIER BUILDINGS		Flokkur nr.:	Bláð nr.:	Nasta bln.:
B5/S2		Kostn.nr.-Cno. / Bún.nr.-Eq.no	4011 13982	
ROOF		AKS	UB12	
BUILDING FITTOUT		ISAL Tekn.nr. ISAL / Drawn of ISAL	Breyt./Rev	
Rio Tinto Alcan		ISAL Tekn.nr. ISAL / Drawn of ISAL	251290 A	
ISAL Yfirbú og skráð, dags / ISAL Checked, date		ISAL Samþykkt, dags / ISAL Approval, date		