
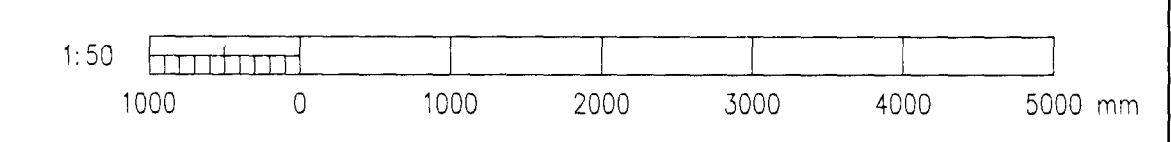


Samþykkt þann  
 01 OCT 2012  
 Byggingafulltrúinn / Hafnaráfangi  
 F.H. Sigurður Steinar Jónsson

Nick Indrisson  
 Kt. 181144-3949  
 AT

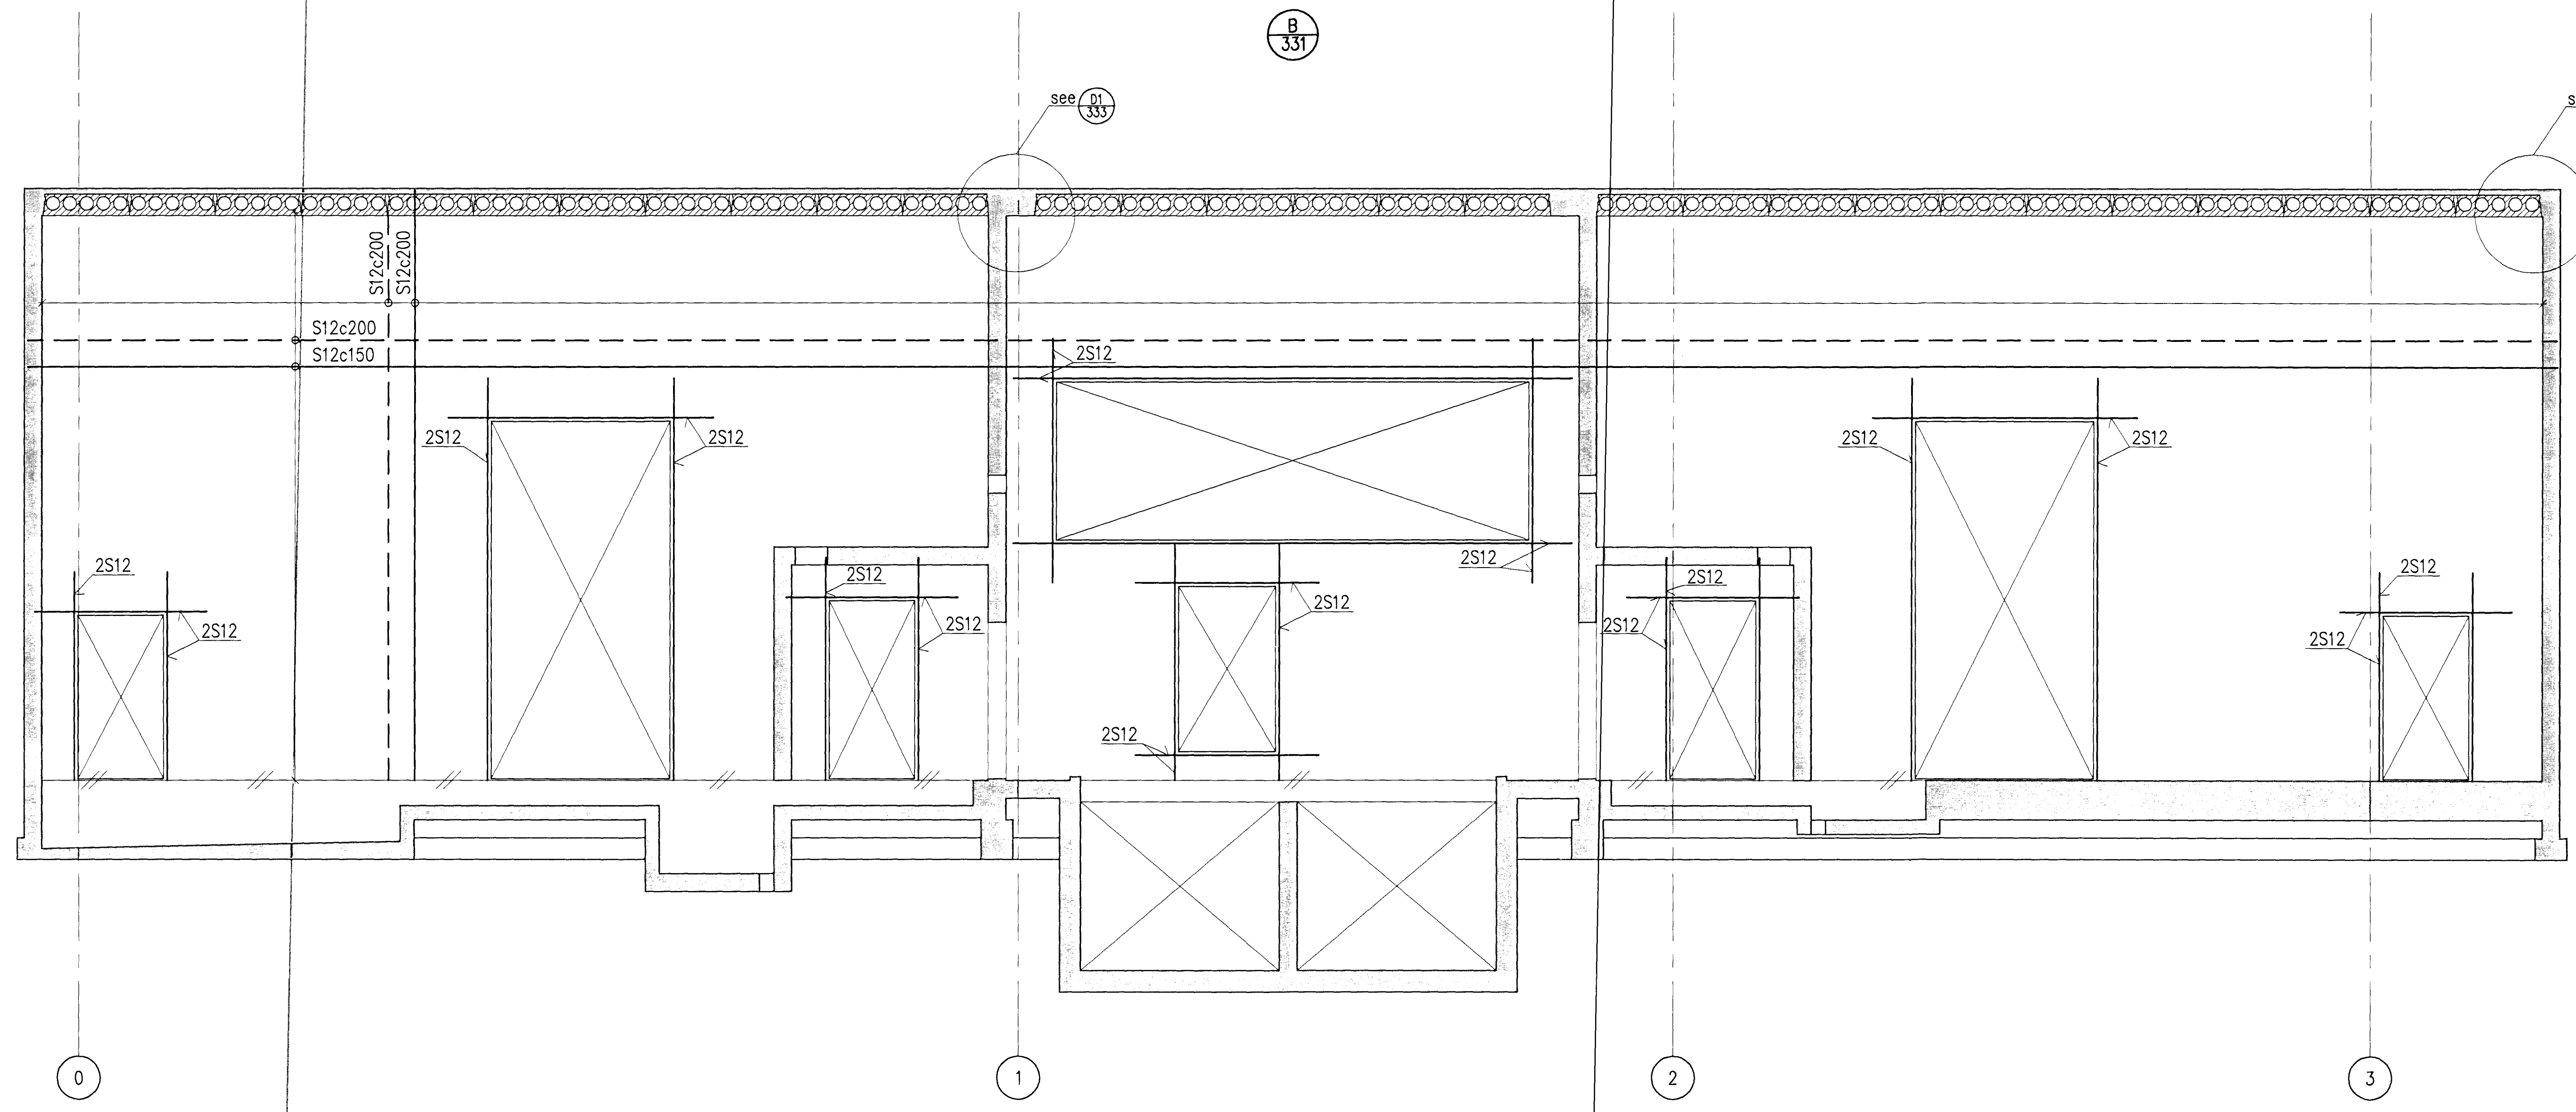

Skýringar: Legend	This drawing is the property of Rio Tinto Alcan Iceland Ltd. and handed out for personal use only. It may neither be copied nor made available to others without permission of Rio Tinto Alcan Iceland Ltd. The receiver is liable for any misuse.											Dagsetning / Date 2011.03.07		IPU410-RECTIFIER BUILDINGS		Flökkur nr.: Blað nr.: Nasta bl. nr.: 4011 13982	
	4 Record drawing		2012.09.12	HS	NI	87	ndh	Formát: A1 Msk.: 1:50 Scale: 1:50 Dimensions without tolerances according to ISO 2768-1 medium.		Tekn. nr. / Verkfr. / Supplier IDP-410-CA-015-334 HRV		B5/S2 WALLS SIDE VIEW 2/3 REINFORCEMENT		Tekn. nr. ISAL / Drw. no. of ISAL 251288		Breyt./Rev. A	
C:\DP\01 IDP\400 - Reduction\410 Substation\Drawings\Civil\IDP-410-CA-015-334.dwg		Lýsing Description		Dagsetning Date		Höf./Dr. Des./Drw.		Títt Dtd.		Msk. heim Suppl. Ref.		Msk. heim Suppl. Ref.		ISAL Yfirfarið og skráð, dags / ISAL Checked, date		ISAL Samþykkt, dags / ISAL Approval, date	