



Nick Indriðason  
 Kt. 181144-3949  
 NI


F SECTION, 1:50  
 324

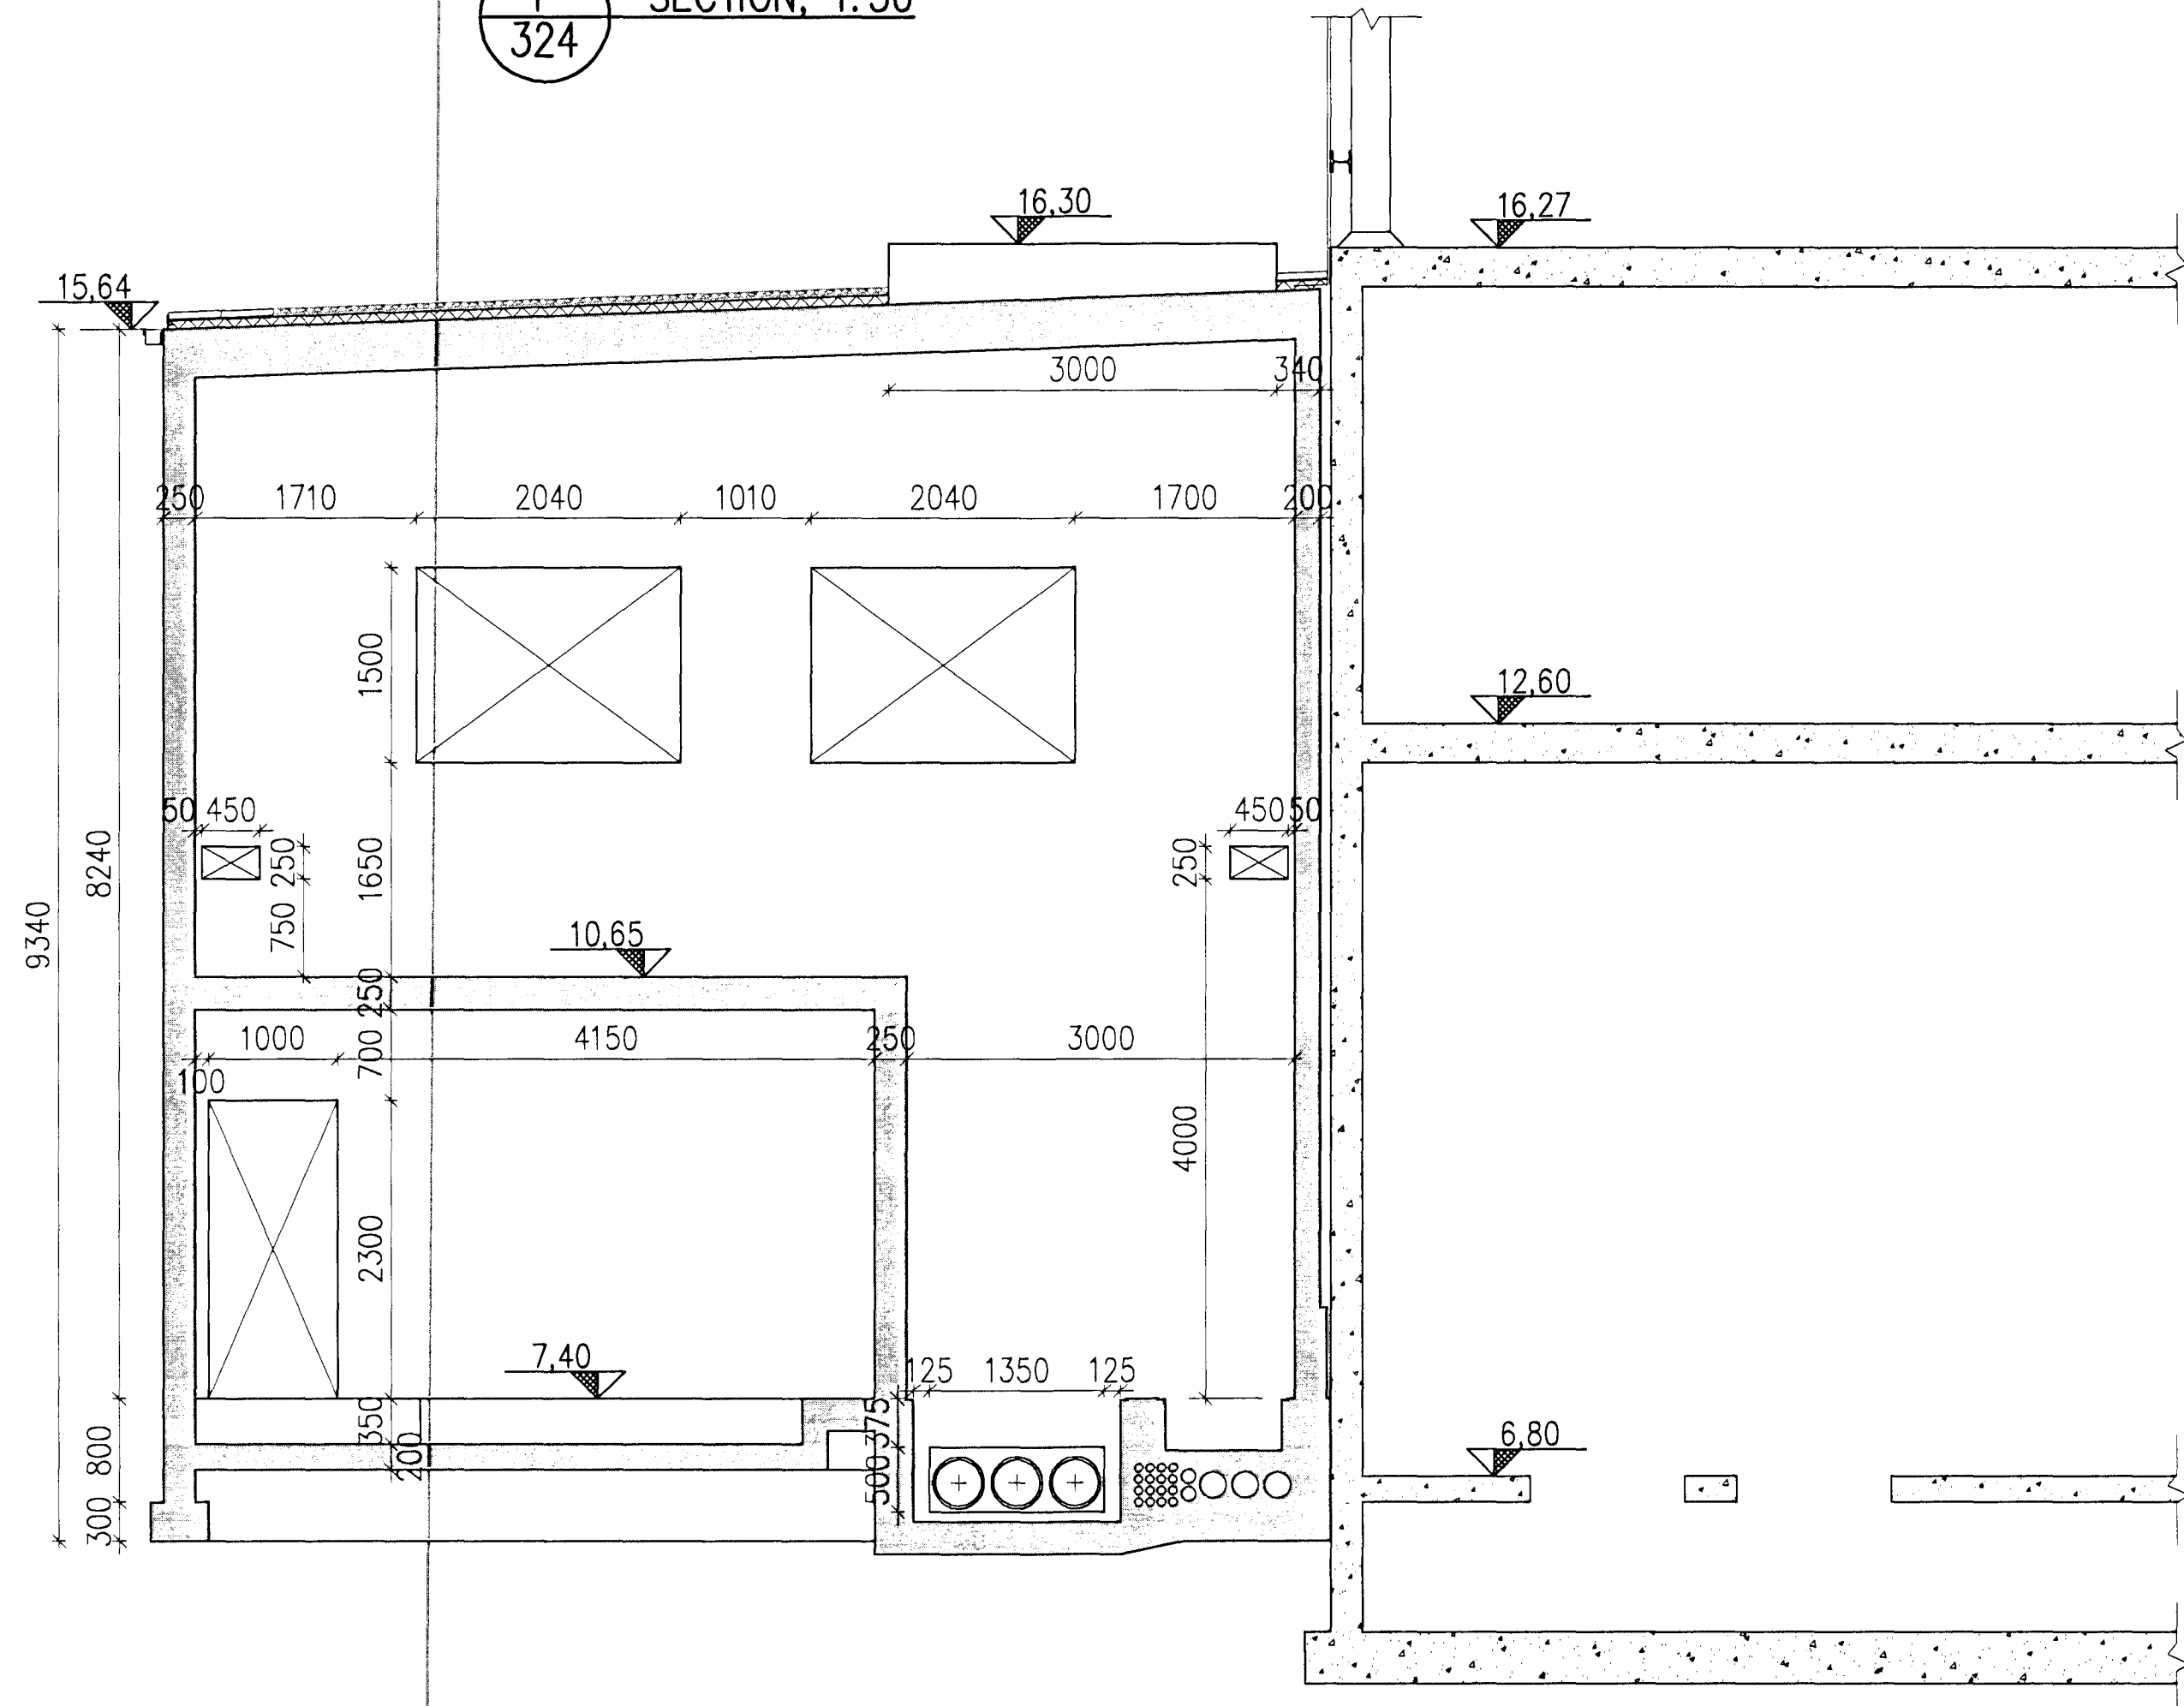

G SECTION, 1:50  
 324

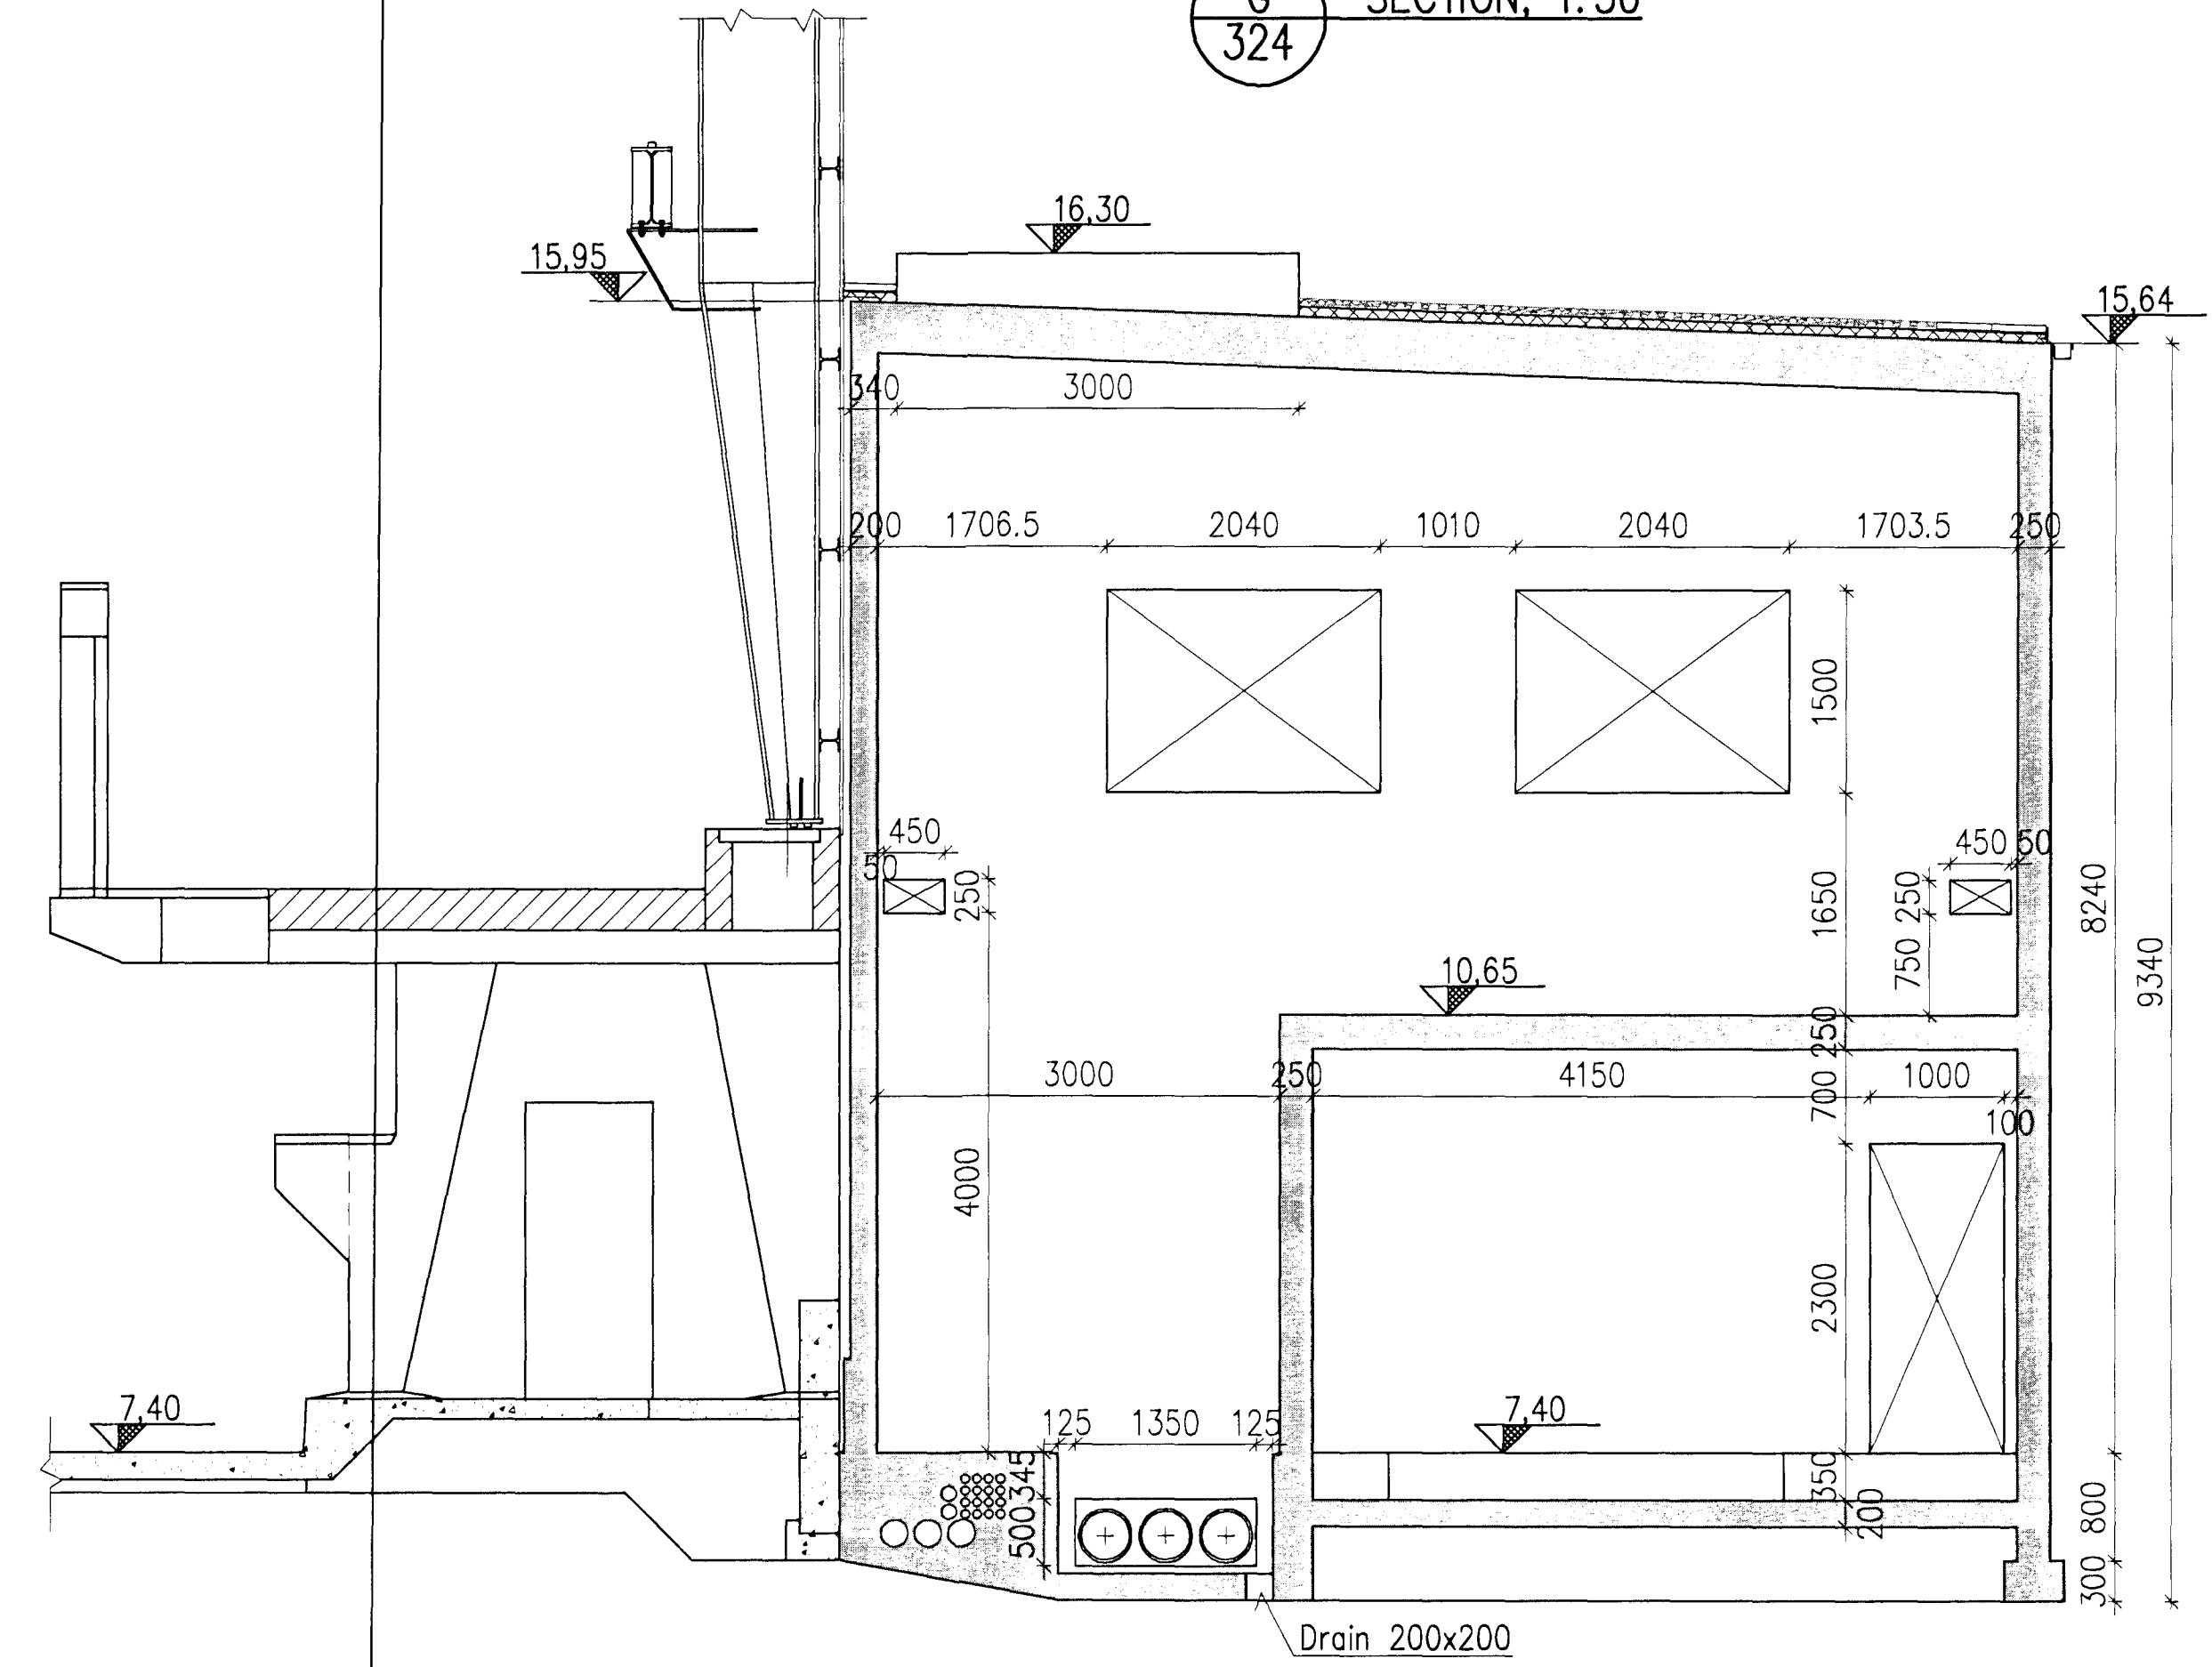

CONCRETE: C30/37:XF3-32

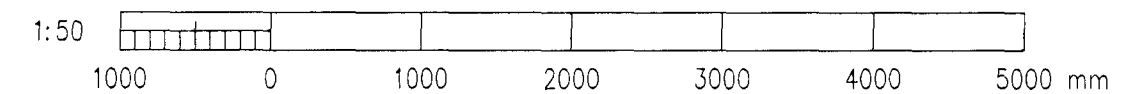

Skjringar Legend

Stig nr / Rev no	Lýsing / Description	Dagsetning / Date	Har/Þan / Des/Draw	Yfir / Ckd	Notk heim / Suppl Rel	Notk heim / ISAL Rel
4	Record drawing	2012.09.12	HS	NI	Eng	res->

This drawing is the property of Rio Tinto Alcan Iceland Ltd. and handed out for personal use only. It may neither be copied nor made available to others without permission of Rio Tinto Alcan Iceland Ltd. The receiver is liable for any misuse.

Stig nr: A1  
 Skala: 1:50  
 Dimensions without tolerances according to ISO 2768-1 medium.



Dagsetning / Date	2011.03.07
Harmað / Designed	GMG
Tekni / Drawn	GMG
Verktaki / Supplier	HRV
Tekni.nr.verktaka / Supplier draw.no.	IDP-410-CA-015-330
Samþykkt / Approved	NI
Hliði af / Part of:	

IPU410-RECTIFIER BUILDINGS  
 B5/S2  
 SECTIONS F AND G  
 Teg.tekningar / Dwg. type: FORM WORK  
 UB12

**RioTintoAlcan**

Flokkur nr. / Class nr.:	4011	Blátt nr. / Bln.nr.-Eq.no	13982
Tekni.nr. ISAL / Draw.no. of ISAL	251284	Breyt / Rev	A