


Samþykkt þann
 01 OCT 2012
 Byggingafrádráttur / Hafnarhát
 F.h. Sigurður Steinar Jónsson

C SECTION
 324

6 SECTION

D SECTION
 324

15.64-15.95
 Níels Indriðason
 Kt. 181144-3949 NI

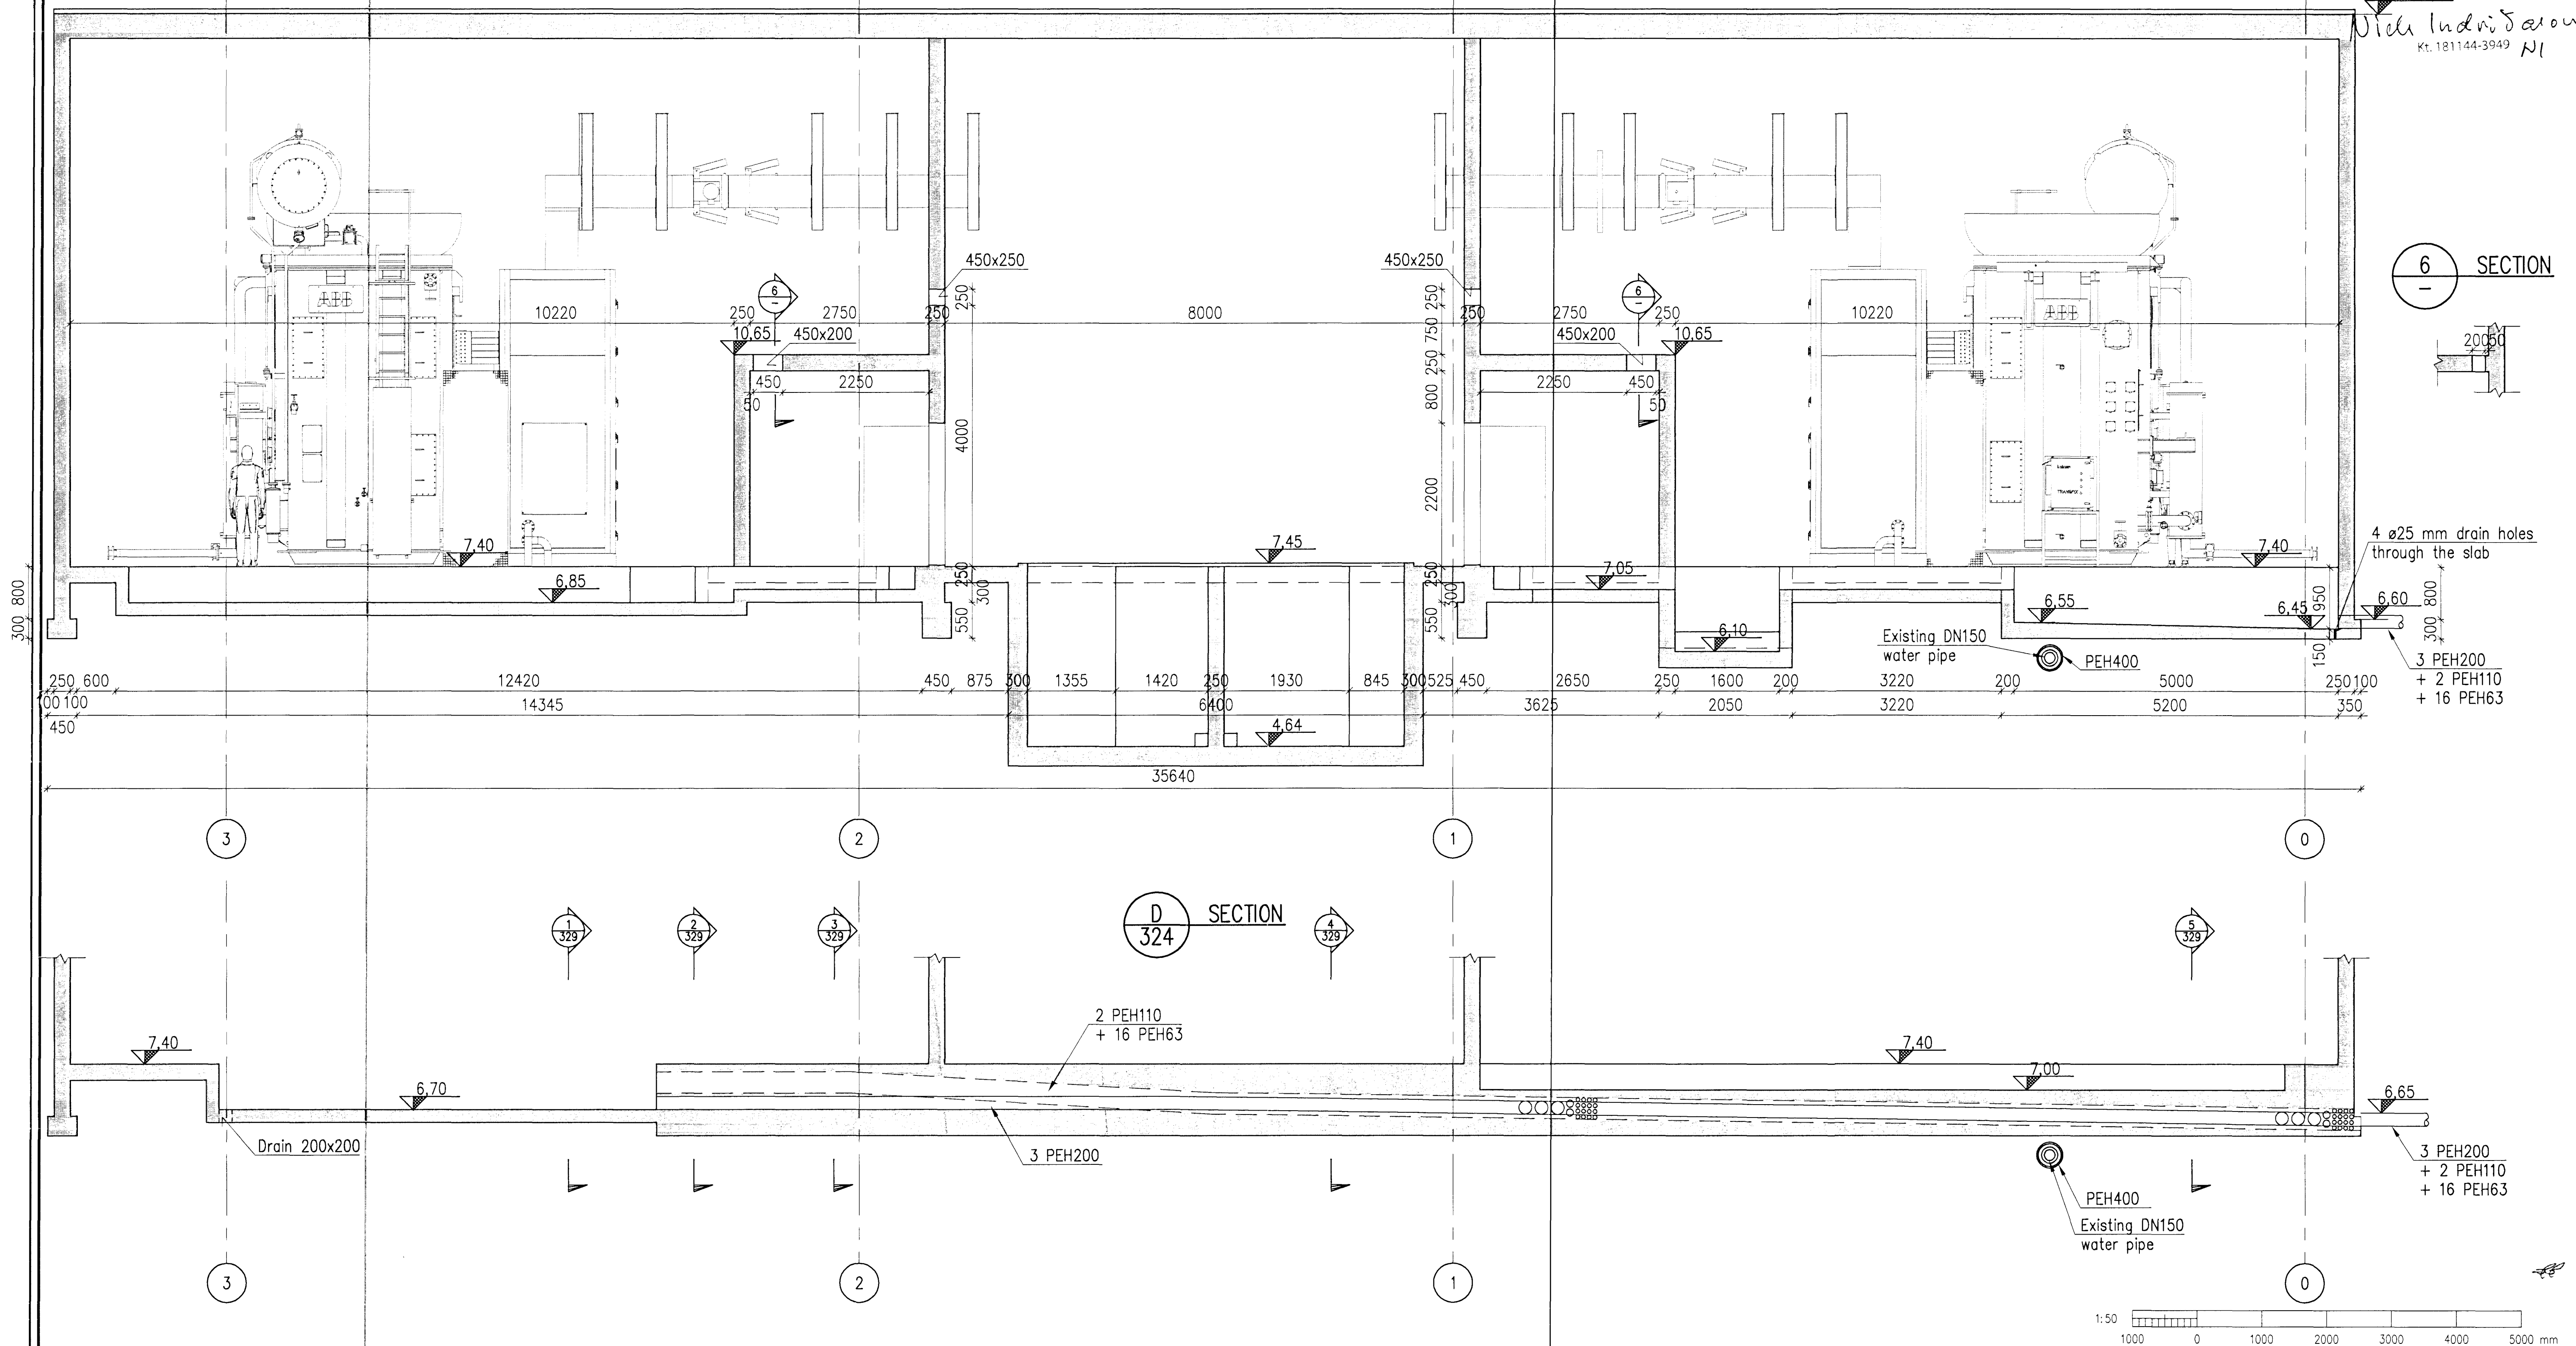

Skýringar:
 Legend:

| Stig nr / Rev no | Lýsing / Description | Dagsetning / Date | Hor./Tín / Des./Dwn | Yfir / Old | Notk heim / Suppl Rel | Notk heim / ISAL Rel |
|------------------|----------------------|-------------------|---------------------|------------|-----------------------|----------------------|
| 3 | Record drawing | 2012.09.12 | HS | NI | skj | re3.3 |

This drawing is the property of Rio Tinto Alcan Iceland Ltd. and handed out for personal use only. It may neither be copied nor made available for others without permission of Rio Tinto Alcan Iceland Ltd. The receiver is liable for any misuse.

Stærð: A1 Máv. 1:50
 Formál: A1 Máv. 1:50
 Dimensions without tolerances according to ISO 2768-1 medium.

| | | | |
|---|--|----------------------------|--|
| Dagsetning / Date 2011.03.07 | | Tökn / Drawn LDB | |
| Hannað / Designed HS | | Verktaki / Supplier HRV | |
| Tökn nr. verktaka / Supplier draw no. IDP-410-CA-015-328 | | Yfir / Chkd NI | |
| Símbull / Approved NI | | Hluti af / Part of: | |

| | | | |
|---|--|--|--|
| IPU410-RECTIFIER BUILDINGS B5/S2 SECTIONS C AND D | | Flokkur nr.: Blað nr.: 4011 13982 | |
| Teg. tekið / Drawn FORM WORK | | Kostn. nr. - Cono. / Búna. nr. - Eq. no. AKS UB12 | |
| Rio Tinto Alcan Alcan Iceland Ltd IS-222 Hafnarforður Ísland | | Tökn nr. ISAL / Drawn of ISAL 251282 | |
| ISAL Yfirforð og gætt / ISAL Checked, date | | Næsta bl. nr. / Breyt./Rev. A | |