


Samþykkt bann
 1 OCT 2012
 Byggingafulltrúinn / Hattarinn
 F.h. Sigurður Steinar Jónsson

Níels Indriðason
 Kt. 181144-3949 NI

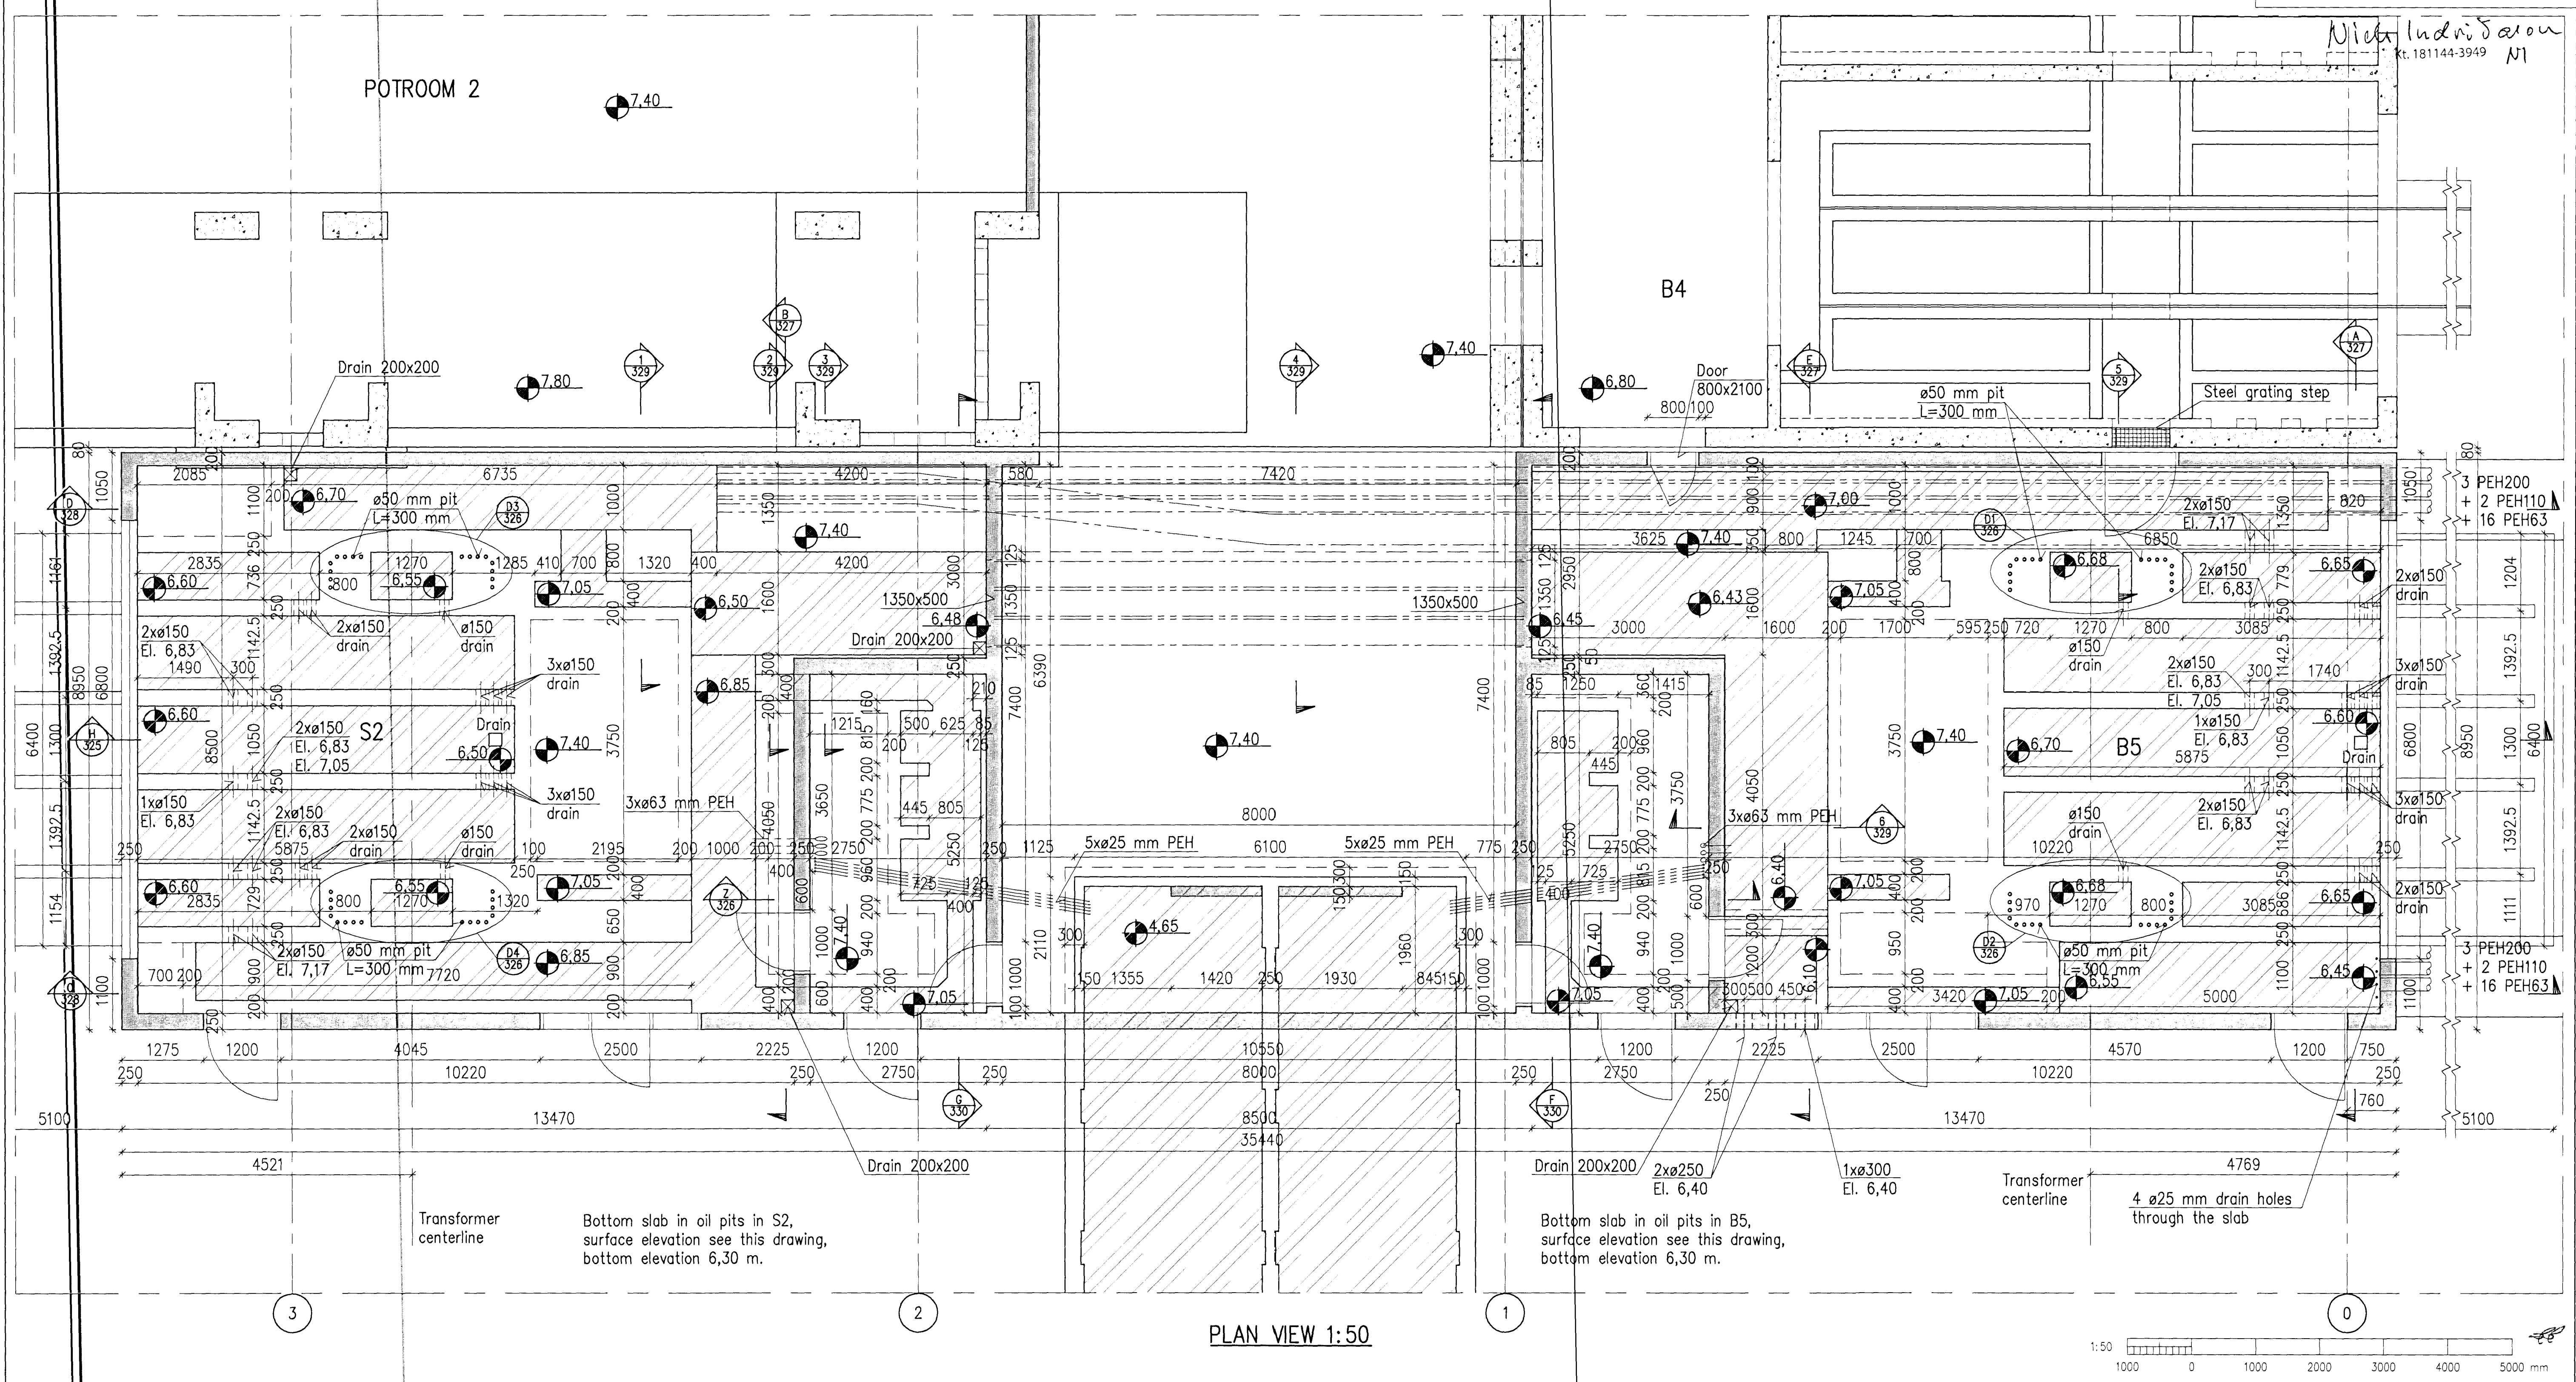

PLAN VIEW 1:50

Skýringar Legend:	This drawing is the property of Rio Tinto Alcan Iceland Ltd. and handed out for personal use only. It may neither be copied nor made available to others without permission of Rio Tinto Alcan Iceland Ltd. The receiver is liable for any misuse.				Dagsetning / Date 2011.03.07		IPU410-RECTIFIER BUILDINGS		Flökur nr.: Blað nr.: Nasta bl./nr.:		
	Sérst. Form: A1 Mkv.: 1:50 Scale: 1:50				HRVA HATCH REAL PRODUCTION SERVICES		B5/S2 PLAN VIEW		Kostn.nr.-Cono. / Blán.nr.-Eq.no 4011 13982		
4 Record drawing				2012.09.12 HS NI		Tökn.nr./vertikala / Supplier draw.no. IDP-410-CA-015-324		Teg.teglingar / Dag. type: FORM WORK		AKS UB12	
Útg. nr. / Rev. no.				Lýsing / Description		Sambúikt / Approved		Yfir / Chkd NI NI		Tökn.nr. ISAL / Draw.no. of ISAL / Breyt./Rev. 251278 A	
C:\VDP\01 IDP-410 - Reduction\410 Substation\Drawings\Civil\IDP-410-CA-015-324.dwg				Dagsetning / Date		Höfundur / Designer		Tökn. / Supplier		ISAL Yfirforð og skráð, dags / ISAL Checked, date	
				Dagsetning / Date		Höfundur / Designer		Tökn. / Supplier		ISAL Samþykkt, dags / ISAL Approved, date	