



M: 1205334

Samþykkt þann
 01 OCT 2012
 Byggingafrúnn (Hafnarfjörður)
 Fh. Sigurður Steinar Jónsson

Níel Indriðsson
 Kt. 181144-3949

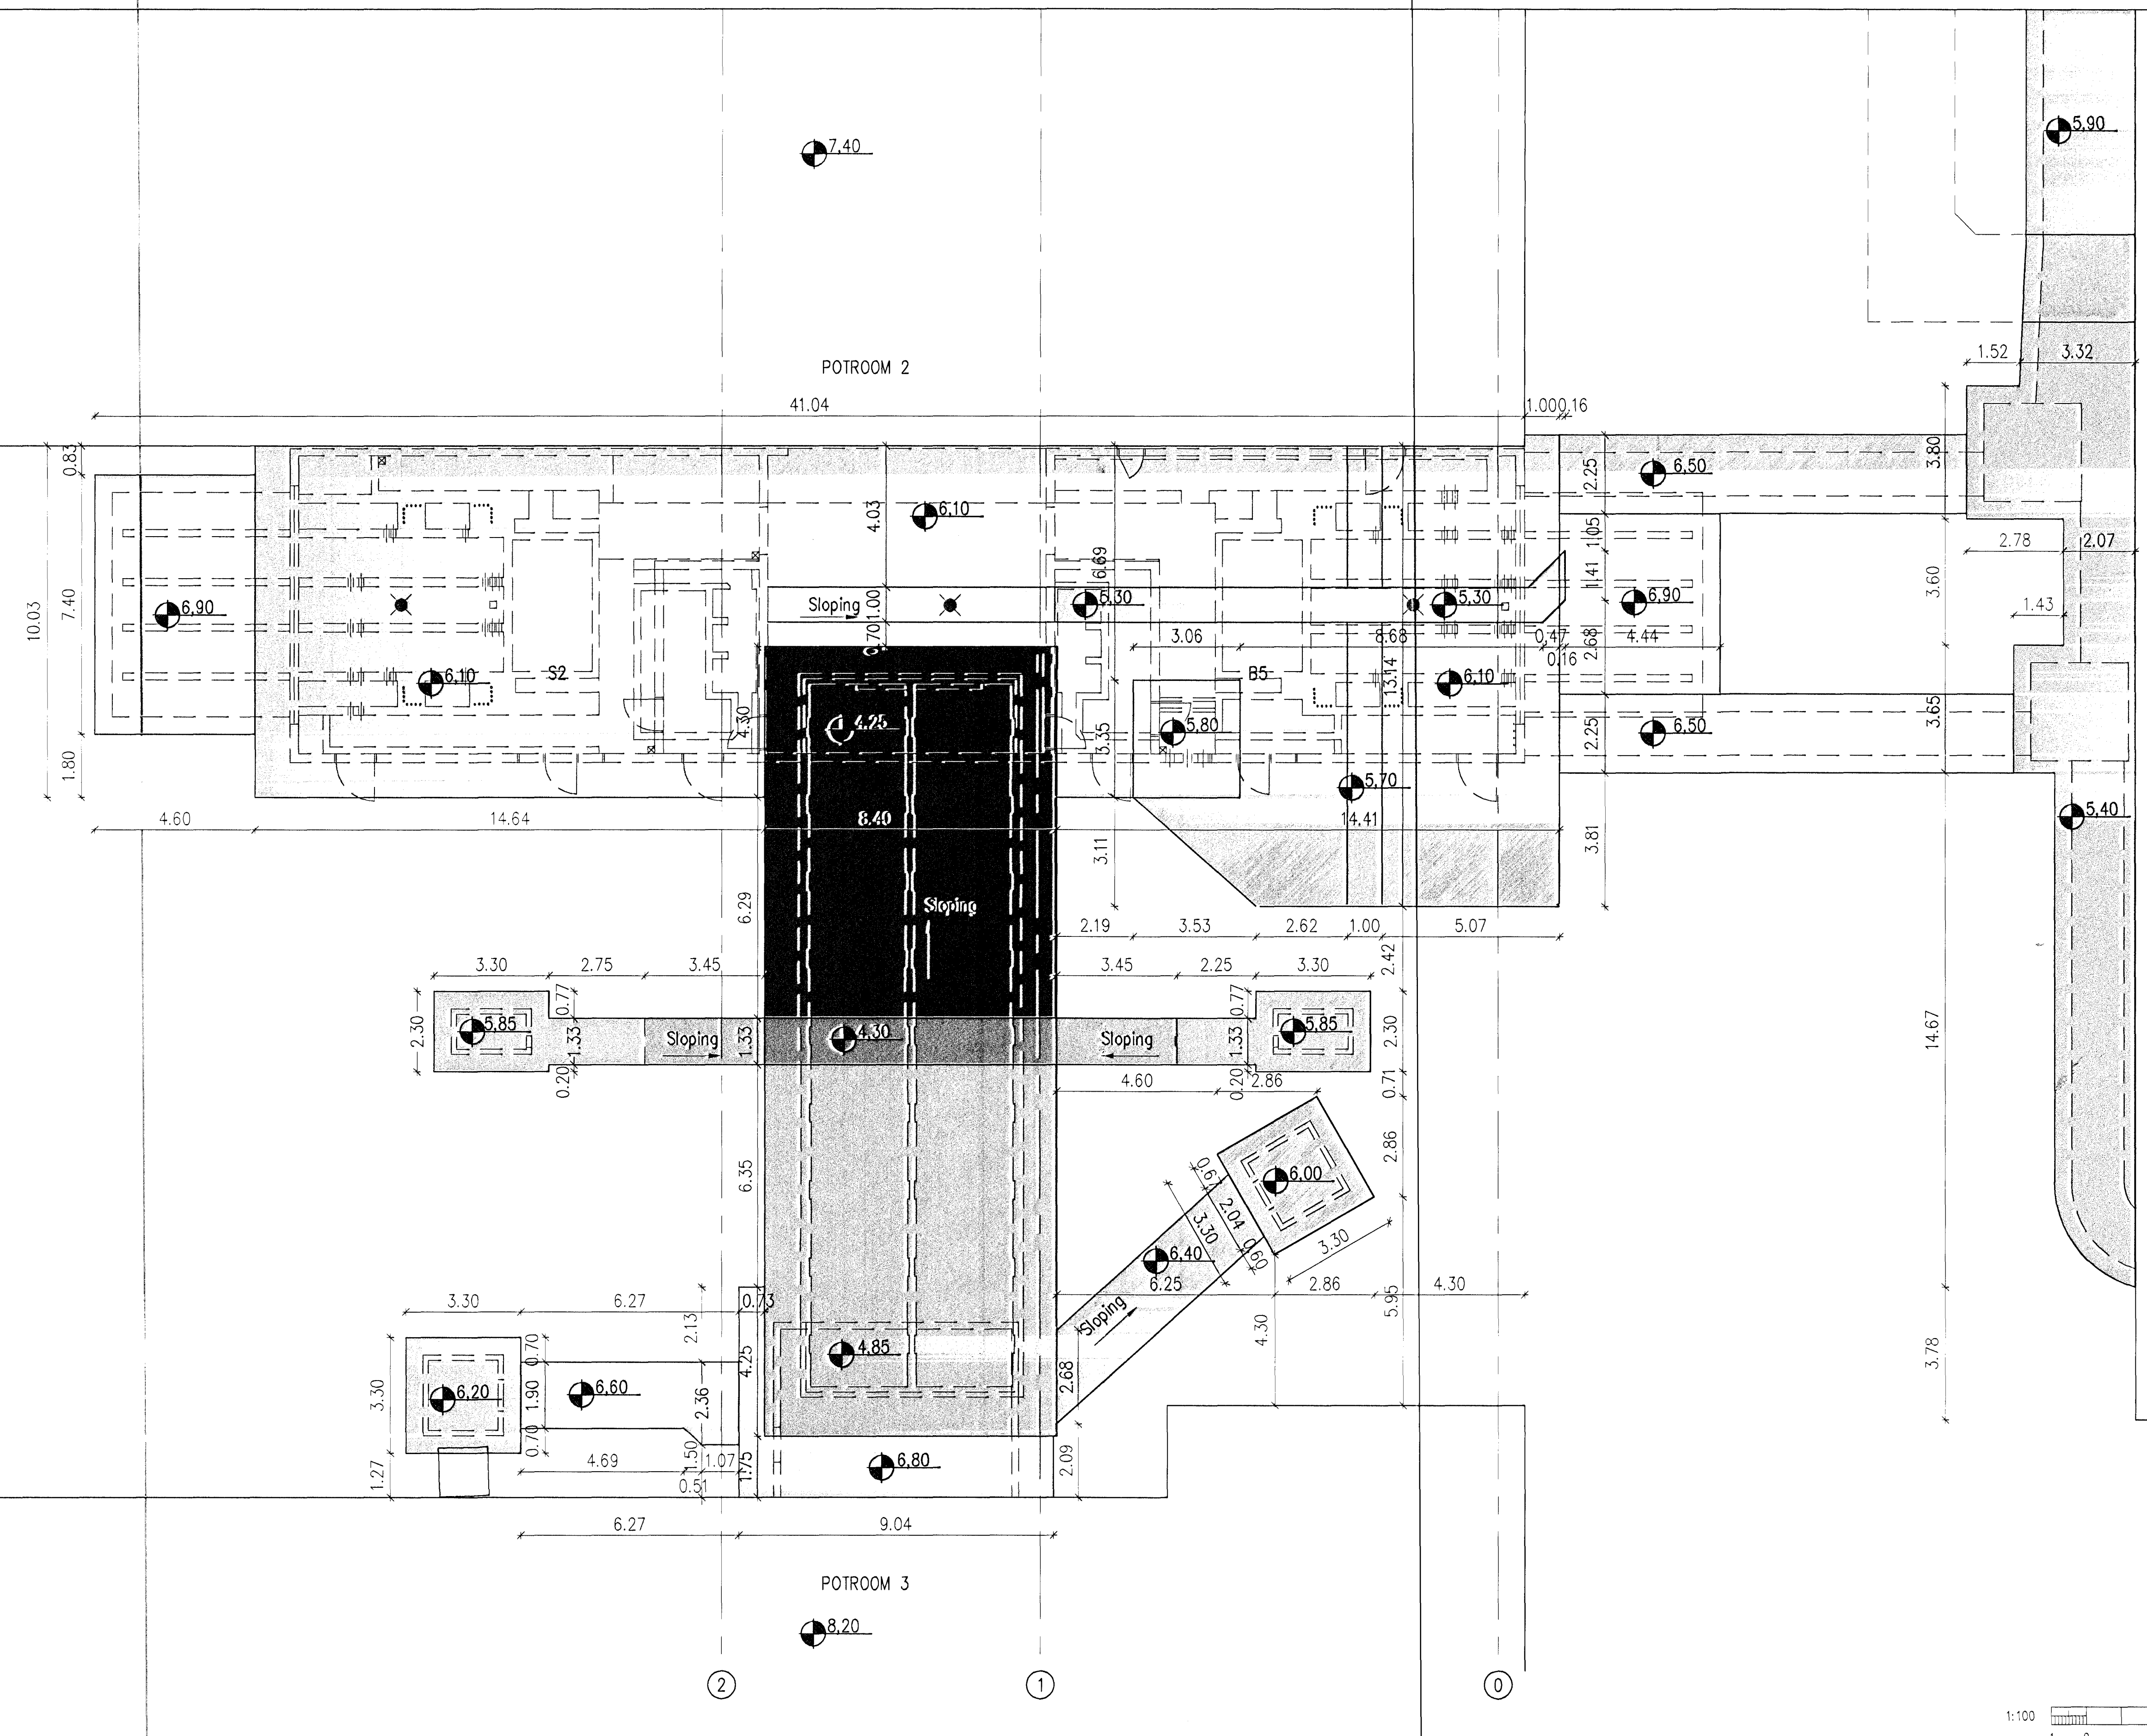

Exploration holes

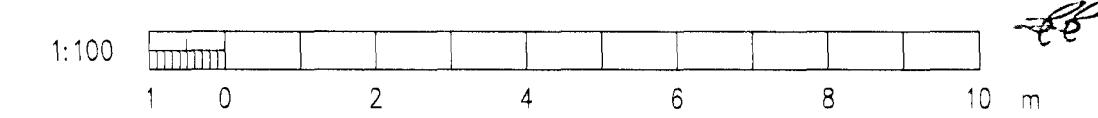

Utg. nr. Rev. no.	Útg. Description	Dagsetning Date	HRV/HR Des/Draw	Yfir Ovd.	Notk. heim Suppl. the	Notk. heim ISAL the
14	Record drawing	2012.09.12	HS	NI	HRV	HRV

This drawing is the property of Rio Tinto Alcan Iceland Ltd. and it may neither be copied nor made available to others without permission of Rio Tinto Alcan Iceland Ltd. The receiver is liable for any misuse.

Scale: 1:100
 Dimensions without tolerances according to ISO 2768-M medium.

HRV HATCH
 ISAL PRODUCTION UPGRADE

Dagsetning / Date	2010.09.29
HRV / Designed	HRV
HRV / Supplier	HRV
HRV / Approved	HRV
HRV / Part of	HRV

IPU410-RECTIFIER BUILDINGS B5/S2, RECTIFIER BUILDINGS, CABLE COND. AND BUSBAR TUNNEL, PLAN 2/2		Flakkur nr. / Blað nr.:	Næsta bl. nr.:
EXCAVATION		Kostn. nr. - Cono. / Búna. nr. - E. no.	13982
Rio Tinto Alcan		AKS	UB12
ISAL Yfirfarið og skráð, dags / ISAL Checked, date		ISAL / Dr. no. of ISAL	251206
ISAL Samþykkt, dags / ISAL Approved, date		Breyt. / Rev.	A