




Samþykkt þann
 18 MAY 2011
 Byggingarástafa Markúsar
 F.h. Sigurður Steinarsson

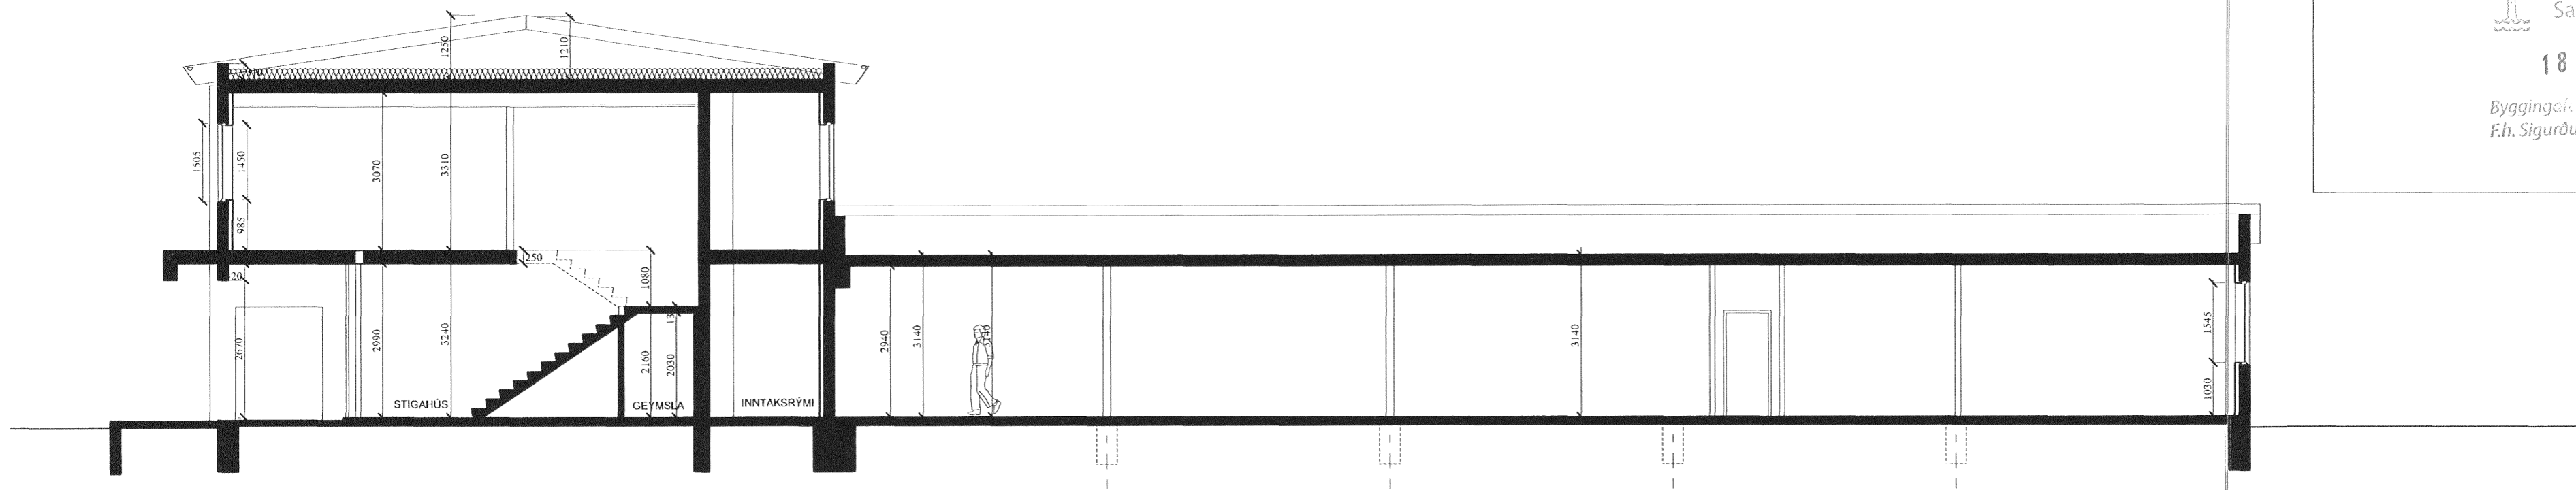

SNEIDING A-A

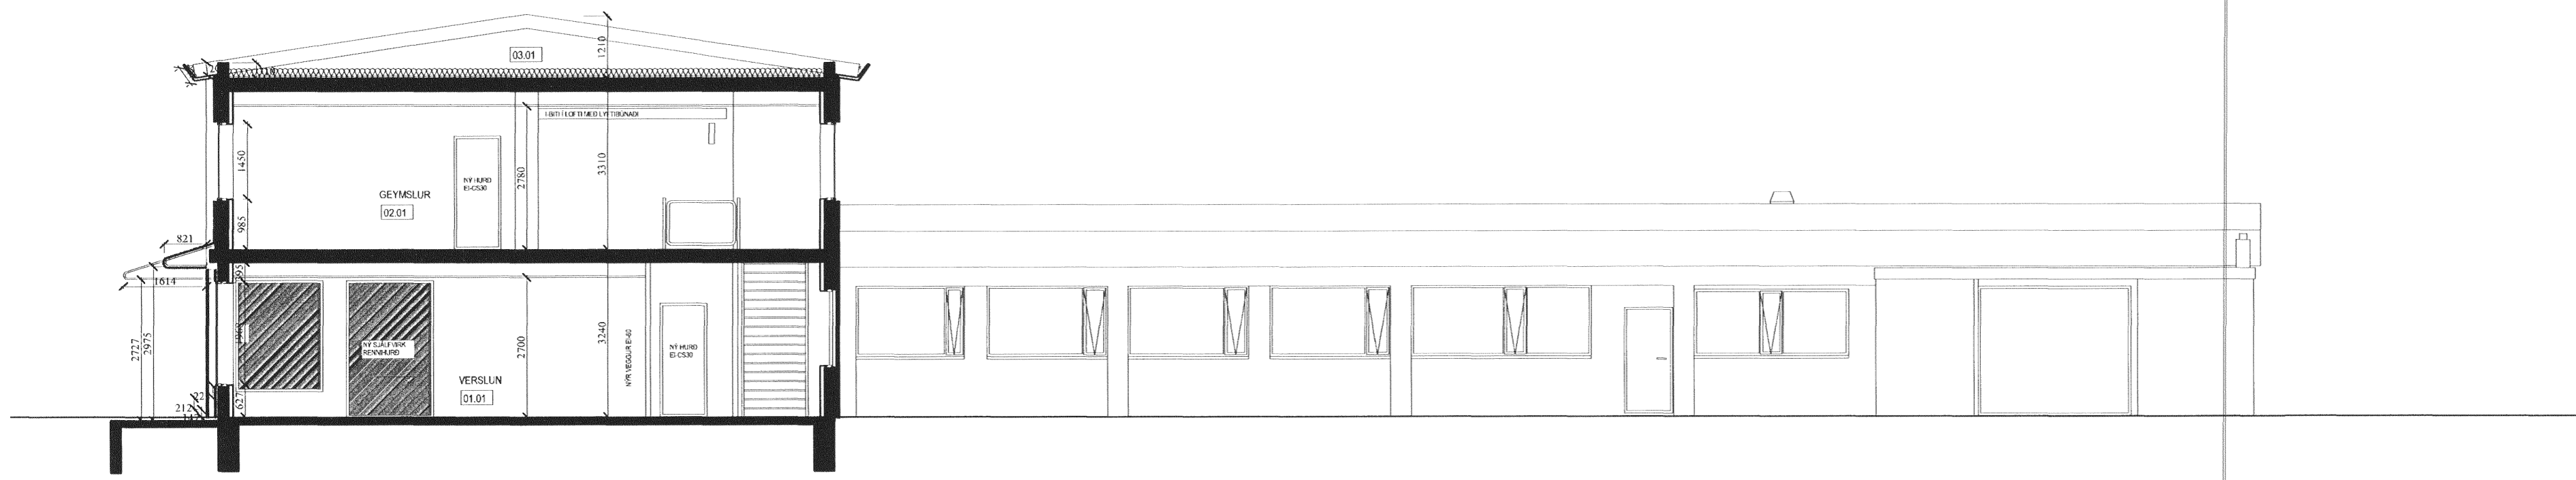

SNEIDING B-B

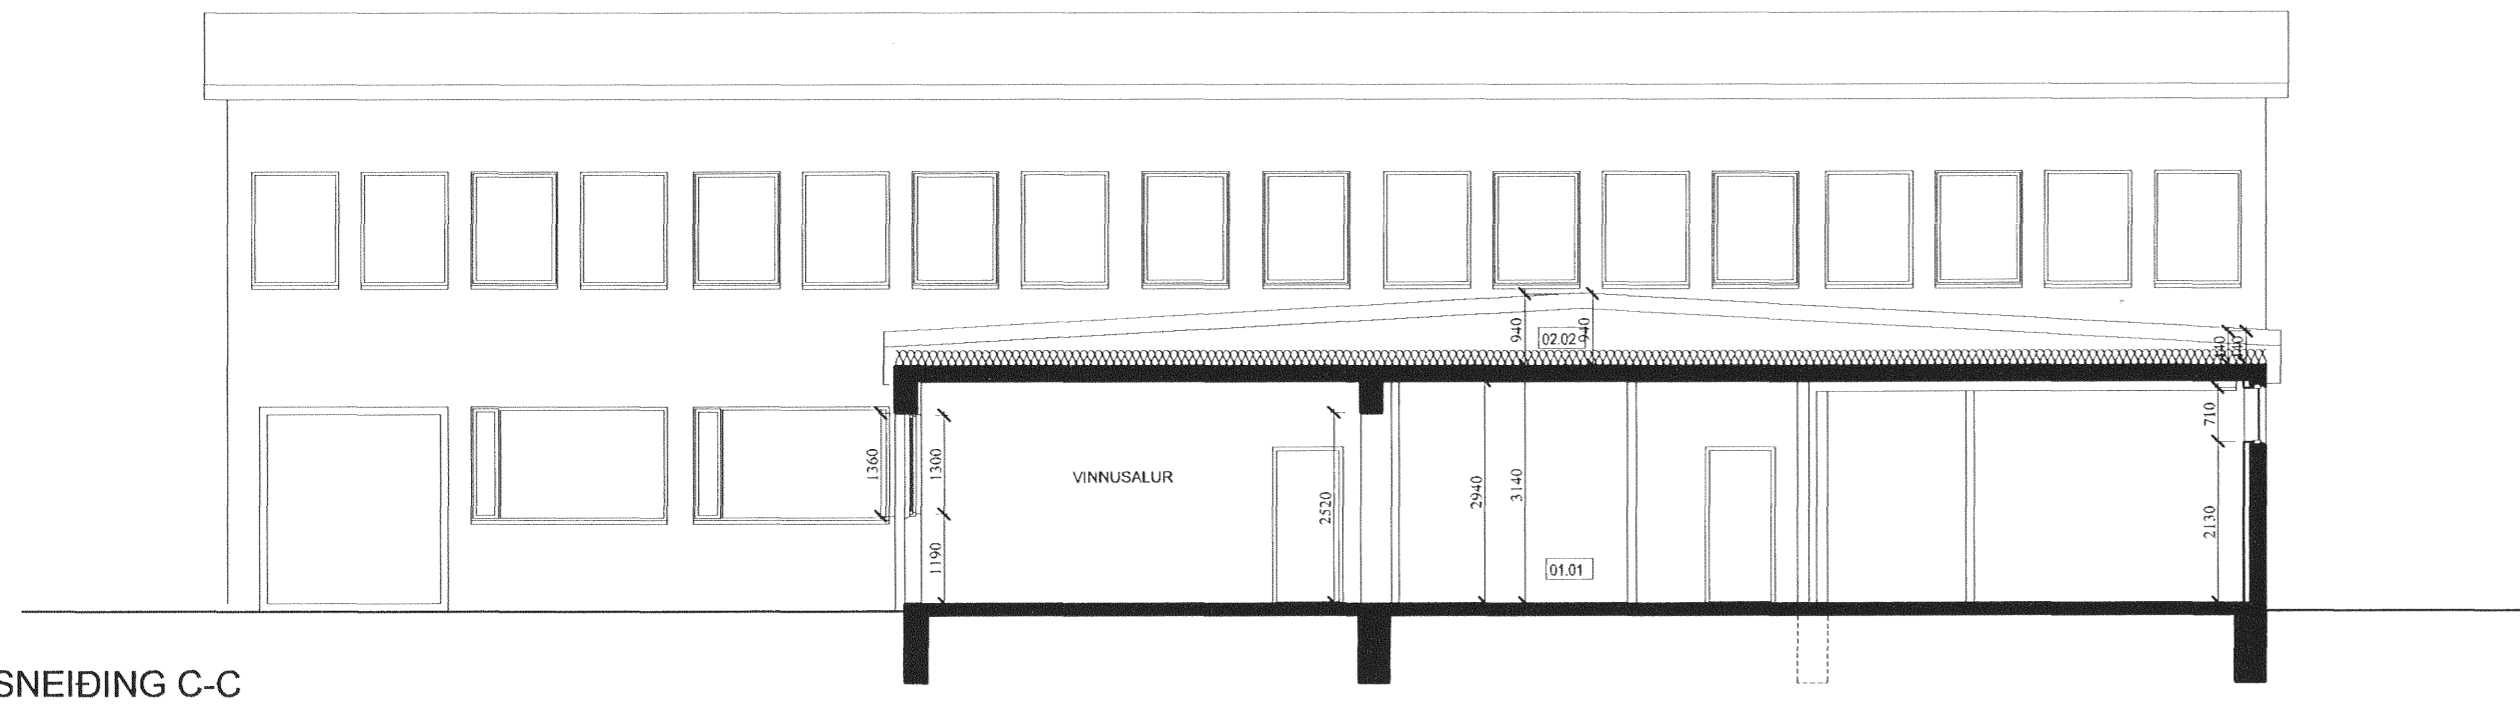

SNEIDING C-C

TRÖNUHRAUN 8, HAFNARFIRÐI
 Reyndarteikningar 1.04

Sneiðingar A-A, B-B og C-C

Mkv.: 1:100

ARGOS ehf. ARKITEKTASTOFA GRÉTARS OG STEFÁNS
 Eyjarslóð 9, 101 Reykjavík
 s: 552 1760, f: 562 1687, netf: argos@argos.is 8. apríl 2011

Stefán Örn Stefánsson arkitekt f.a. kt. 140147-4519
 Grétar Markússon arkitekt f.a. kt. 270852-4169



Fyrsti áfangi hússins var samþykktur í byggingarnefnd Hafnarfjarðar eftir uppráttum Gunnars Sigurðssonar 1971. Þessir upprættir eru byggðir á þeim auk mælinga á staðnum.