

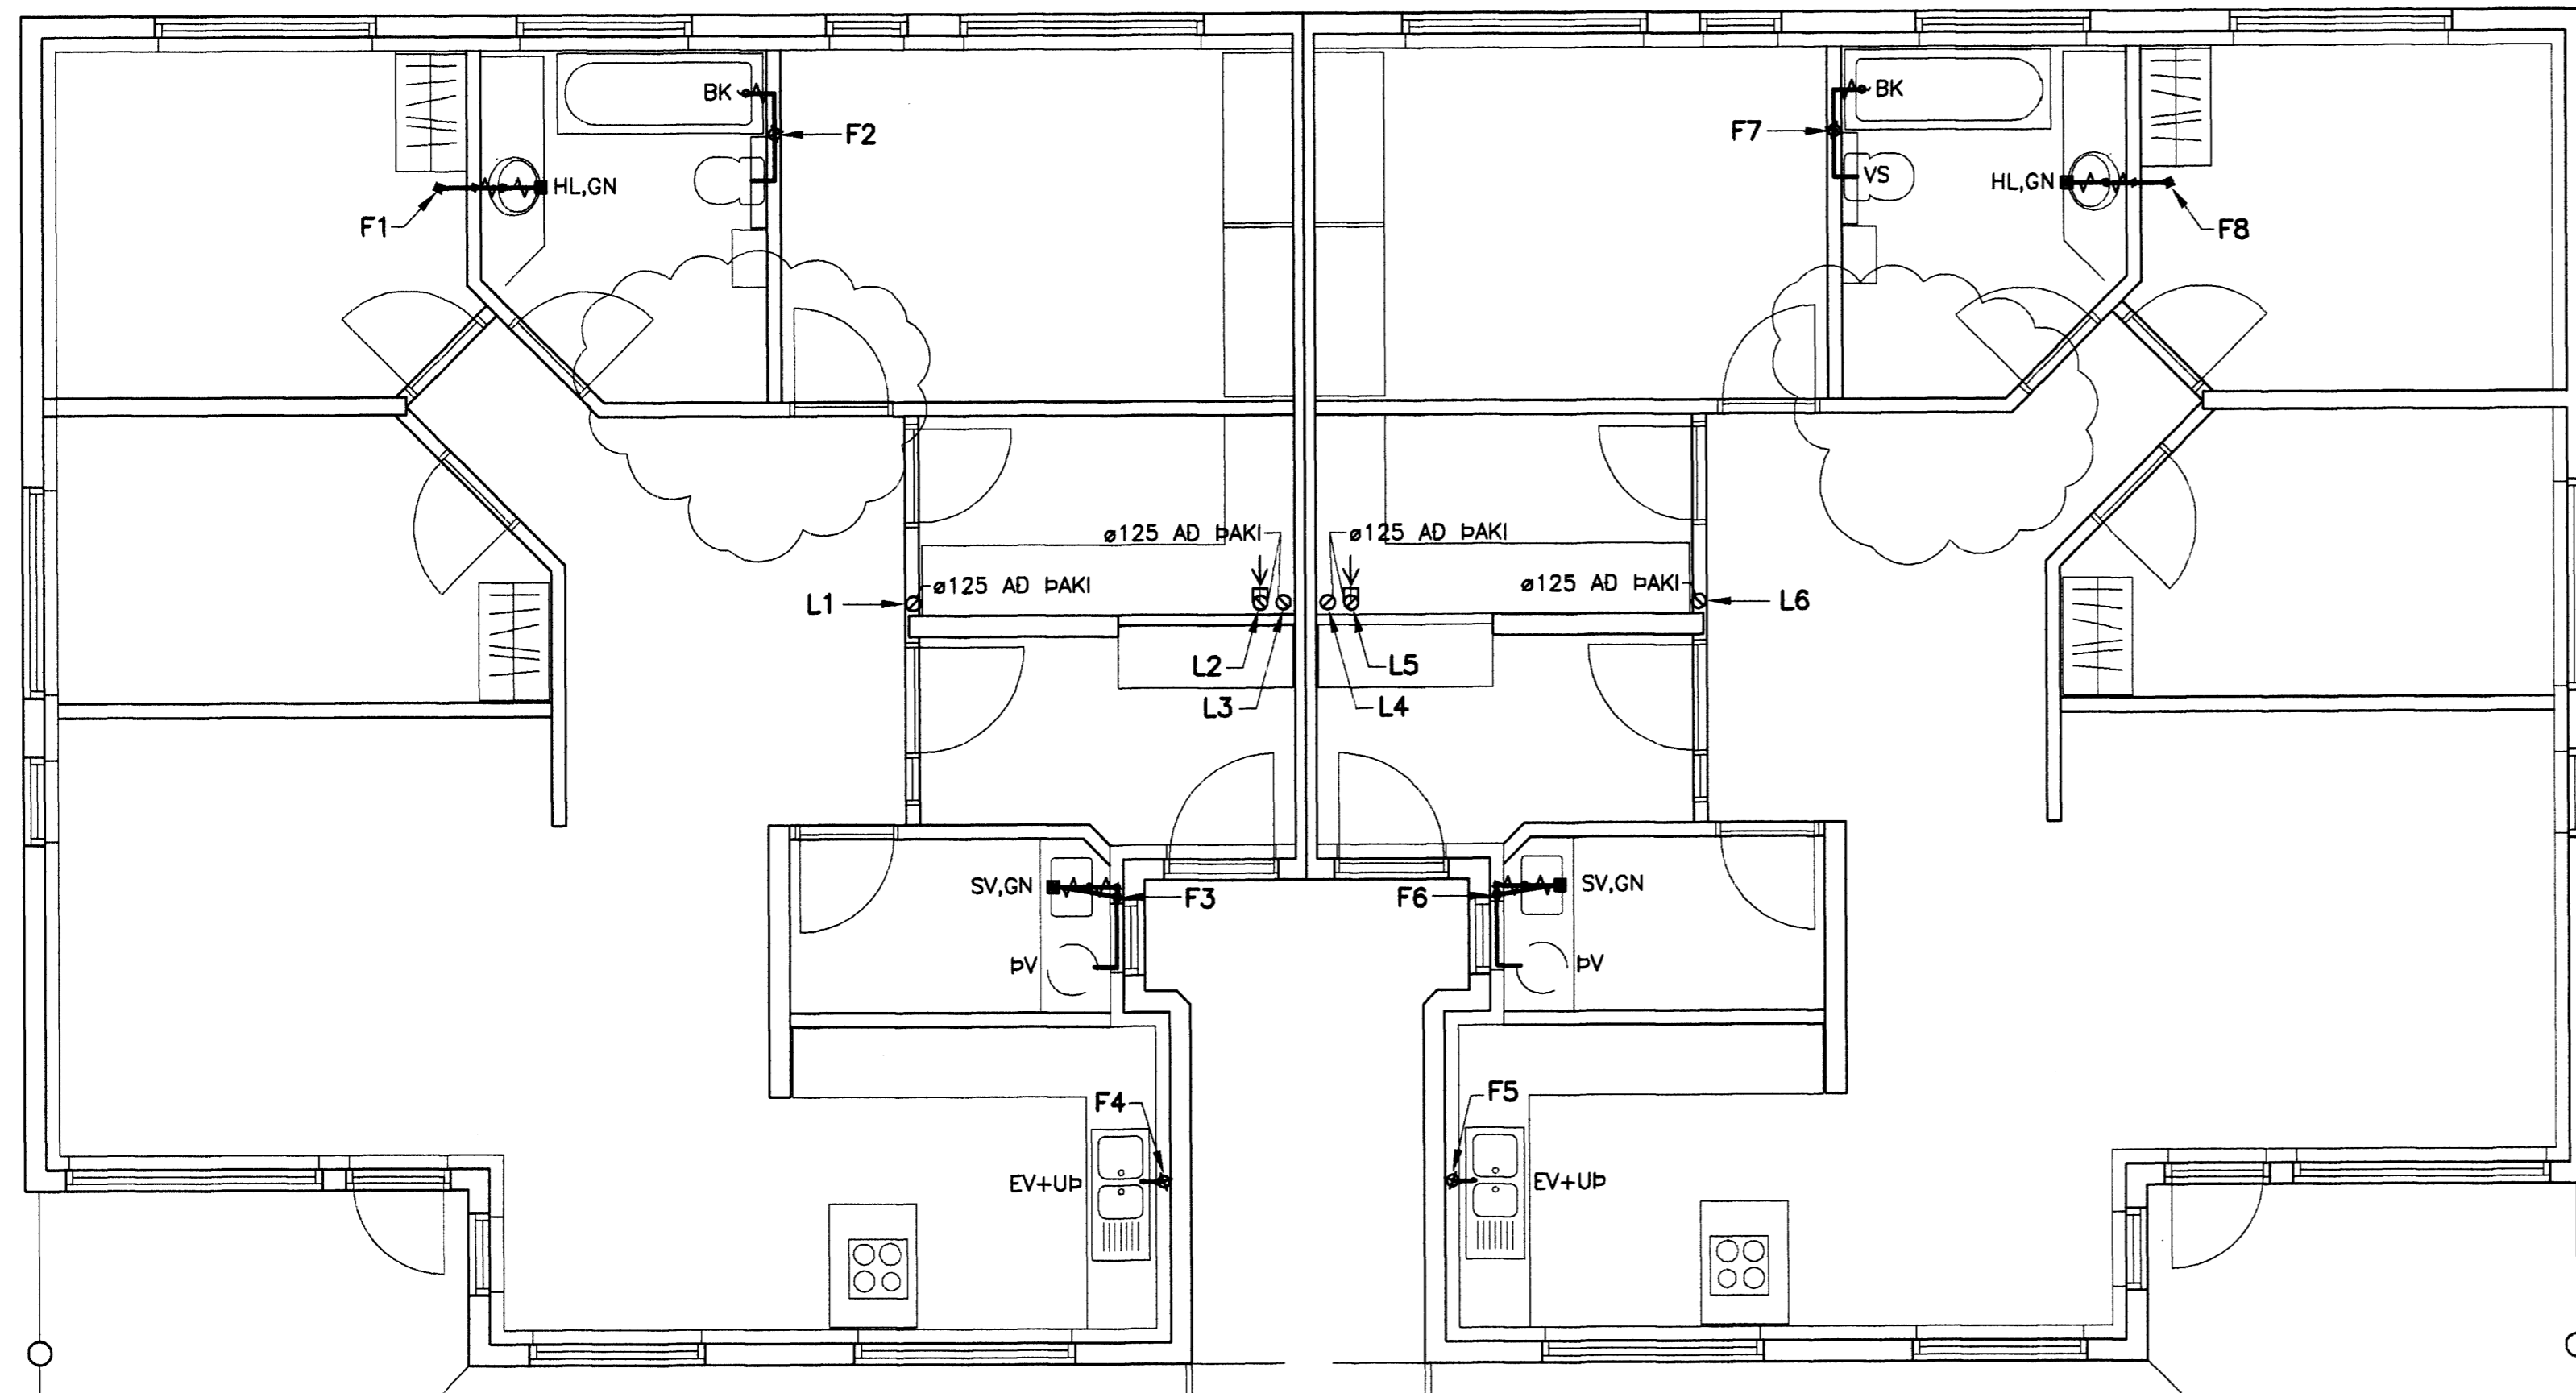



DAGS	NR.	BREYTINGAR	SAHR.
20.08.09	A	Surtur teknar burtu	

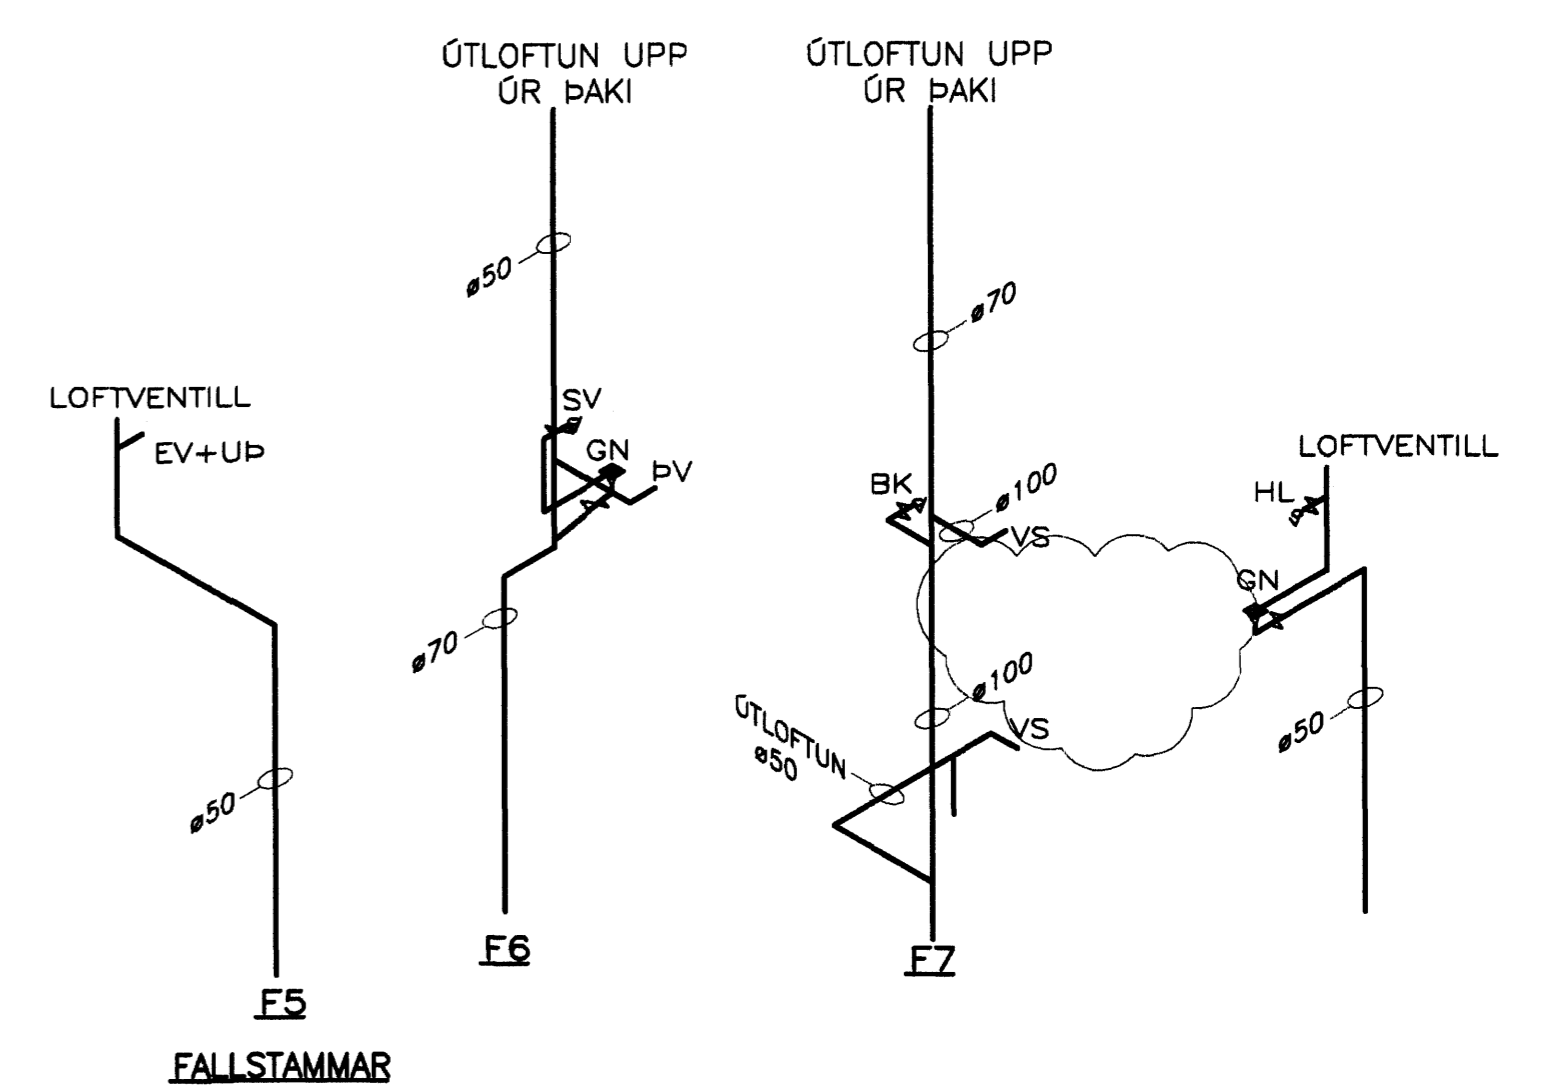


GRUNNMYND 2.HÆÐ. 1:50

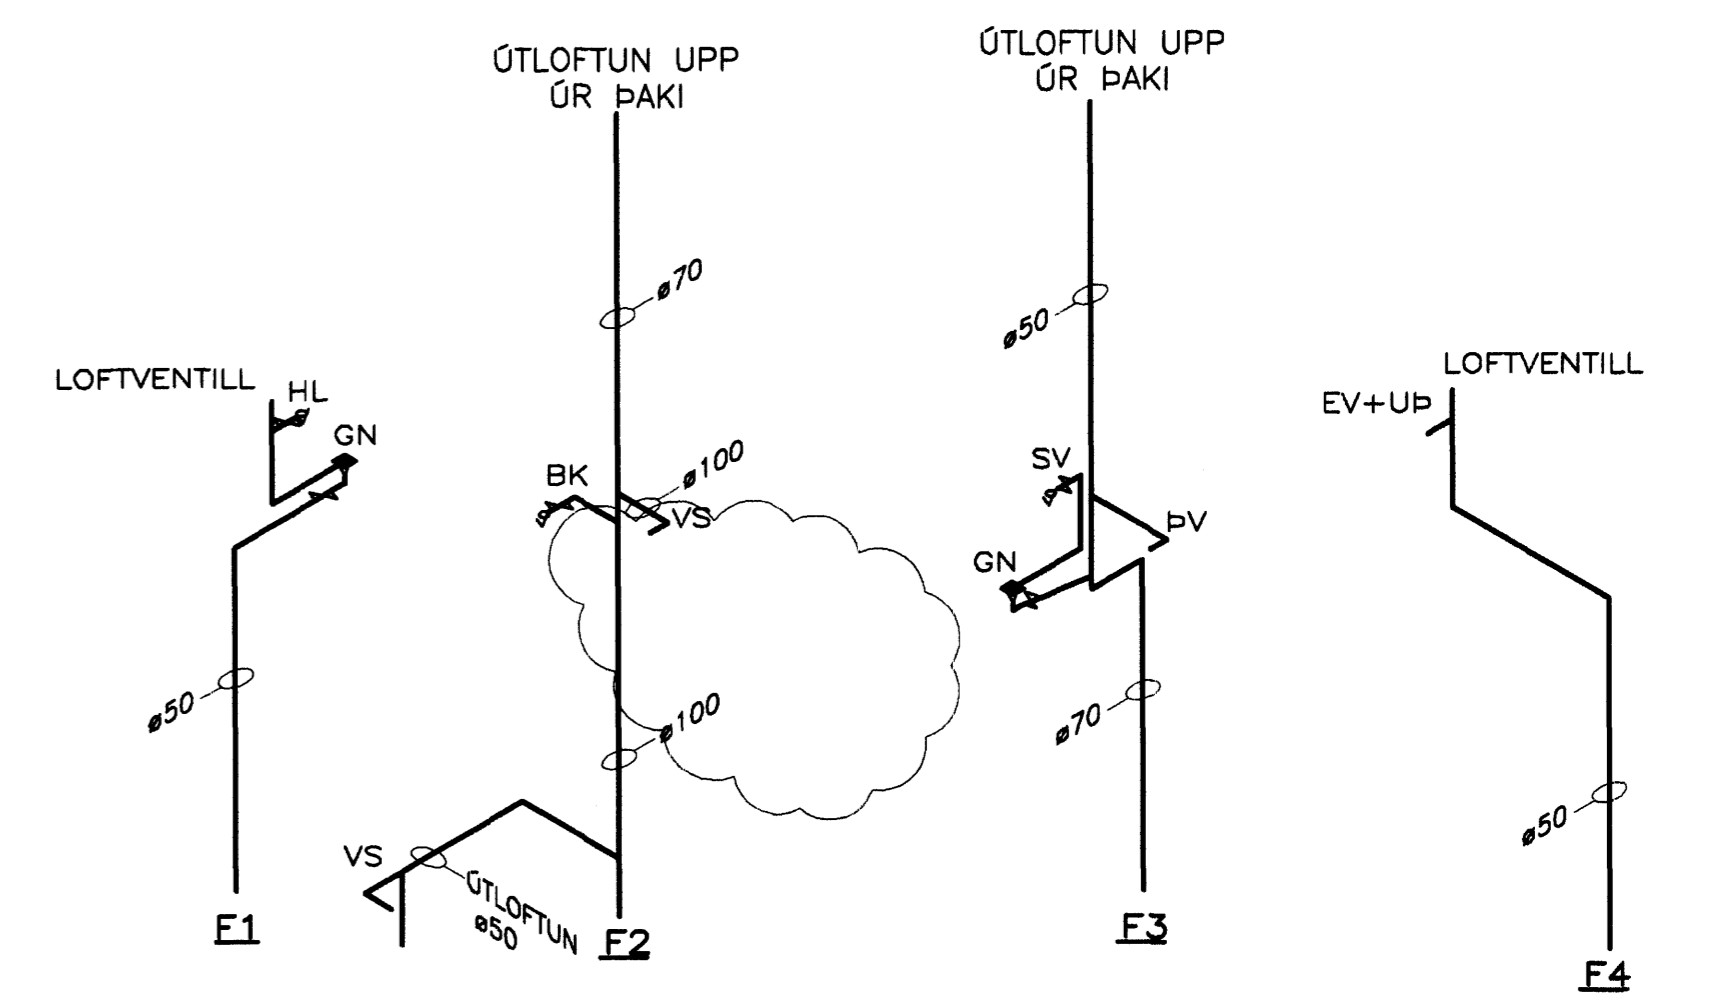

FALLSTAMMAR

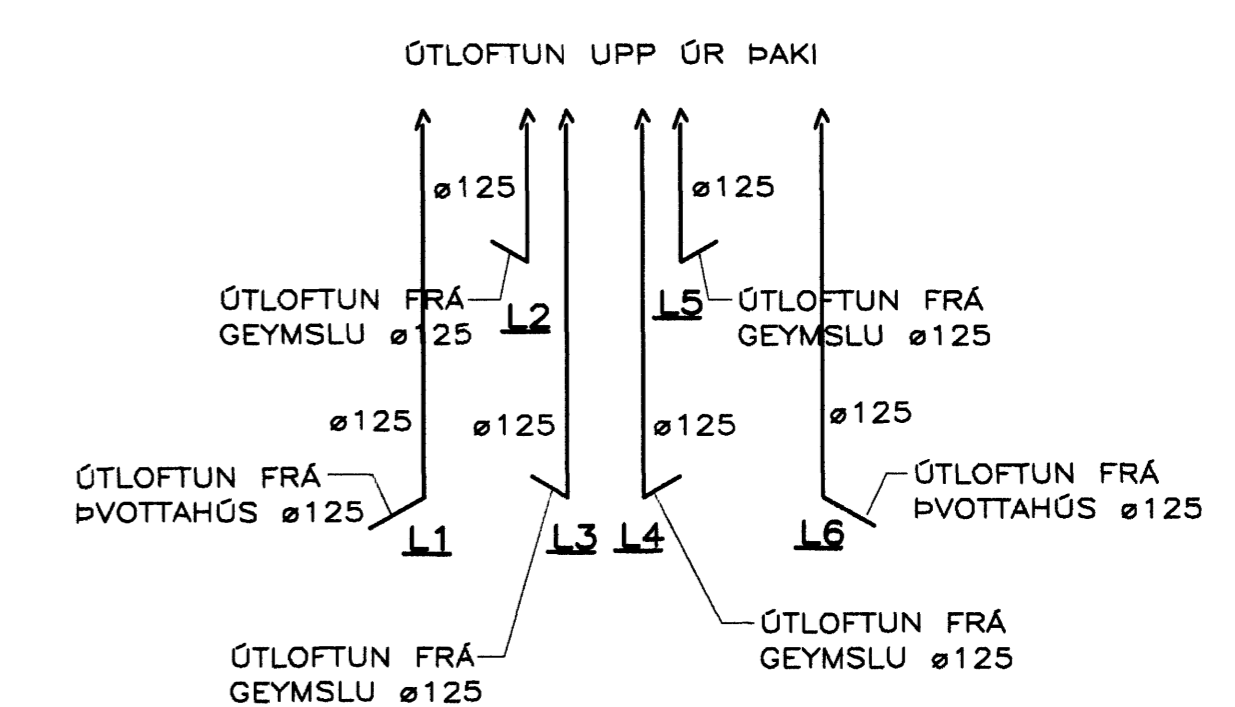

LOFTRÉSISTOKKAR

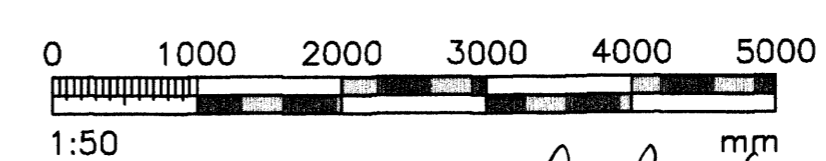

Handwritten signature: Danf. Jón Gunnlaússon

SKEMAN 19 - 108 KEKJAVAR - SM: 517 9050 - NETFANG: jona@verki.is, ghr@verki.is	TEKINGIDAGUR	07.73	06.06.07
DREKAVELLIR 38	TEKINGI	311	
HAFNARFIRÐI	TEKINGI	FJÖRÞYLI	
FRÁVEITU- OG LOFTRÉSISLAGNIR	TEKINGI	Jón Gunnlaússon	FRUMÓTGÁFA
GRUNNMYND 2.HÆÐ	TEKINGI	280255-4329	1:50
FALLSTAMMAR OG LOFTRÉSISTOKKAR	TEKINGI		
DRÖGMAÐUR	TEKINGI	Jón Gunnlaússon	321