




Samþykkt þann

14 JAN 2010

Byggingafrúinn í Hafnarfirði
F.h. Hrólfur S. Gunnlaugsson

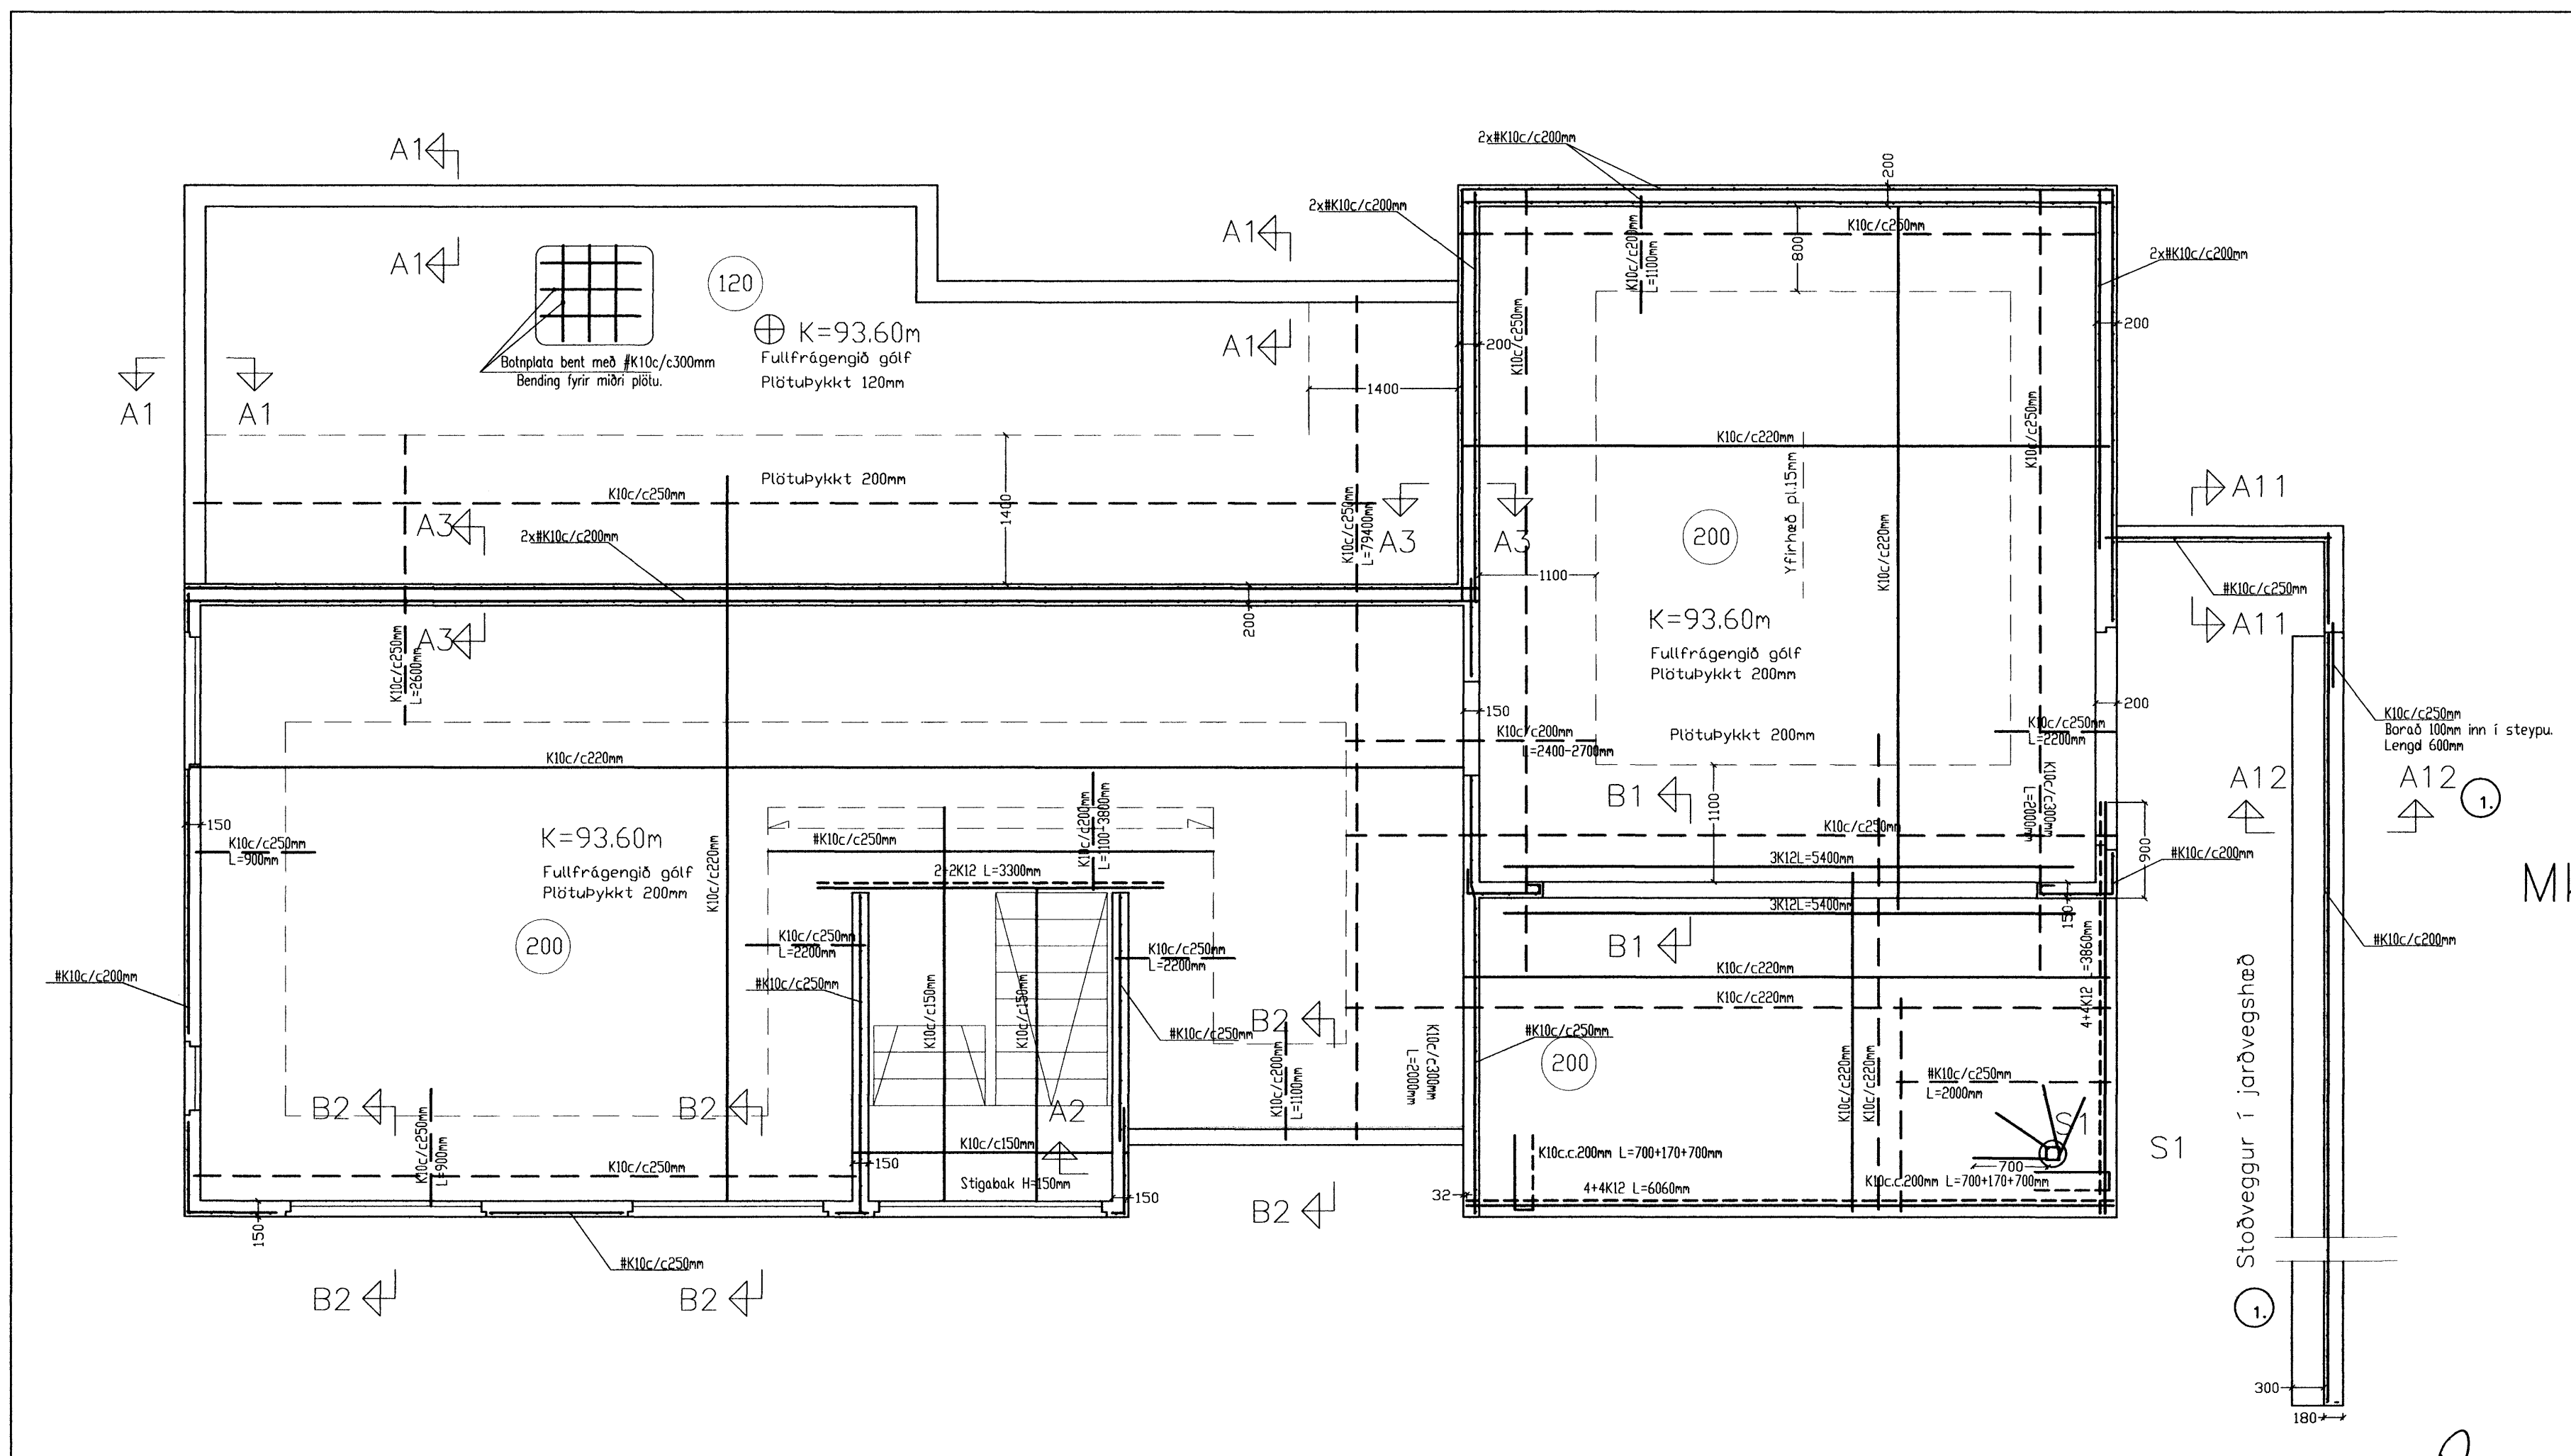

Mkv 1:50

Randi Gunn

Breytingar			Hlíðarás 24. Hafnarfirði.	
Nr.	Dags.	Nafn		
1.	2010.01.11	rgg	Tækniþjónusta Ragnars G Gunnarssonar ehf. Smájuvagi 11 s: 544 5350 ragnargg@aimnet.is	
			Mkv. 1:50	
			Nr. 3.	
			Dags. 2008.09.05	
			kt.:110947-2839	

Randi Gunn