


C:  
 B:  
 A: Suðvestur, gluggar 6 1. hæð. 30.04.2008  
 BREYTINGAR: DAGS:

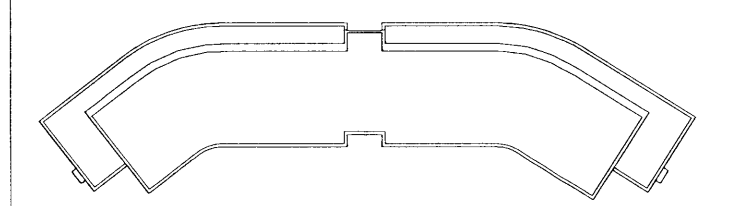

ADALUPPDRATTUR

Dalshraun 3, Hafnarfirði  
 Rís ehf. VERK: DALS 0608  
 KVARÐI: 1:100  
 DAGS: 31.10.2007  
 TEIKN: GPB  
 SKRÁ: 0608-grunnur.dwg

ÚTI INNI

ARKITEKTAR  
 ÞINGHOLTSSÍÐI 27 101 REYKJAVÍK  
 Símar 552 7660 & 562 7660 FAX 552 7661  
 Netfang: ut.inni@ul.is  
 VEFfang:  
 BALDUR Ó. SVAVARSSON ARKITEKTAR FAI  
 120357-5149  
 JÓN ÞÓR ÞÓRVALDSSON ARKITEKTAR FAI  
 021256-7579