




GRUNNMYND SORPGEYMSLU/
FLÓTTASTIGAHÚSS Á LÖÐ

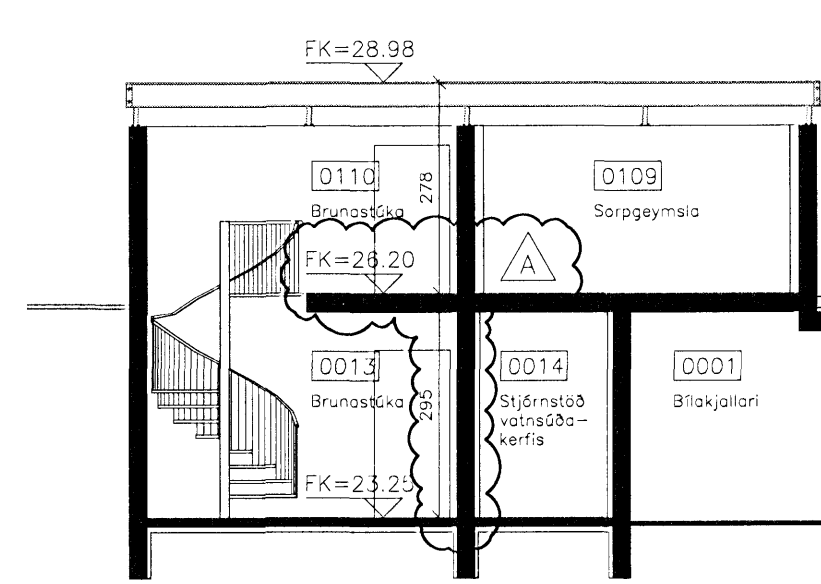



SNID D-D

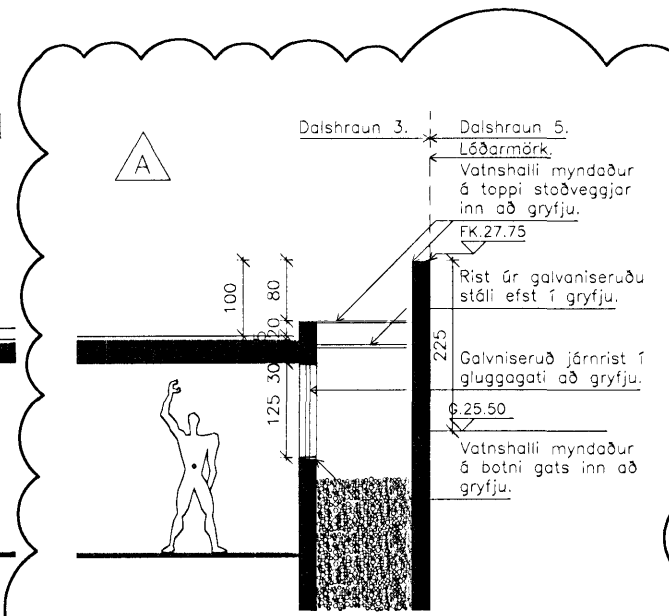



SNID E-E

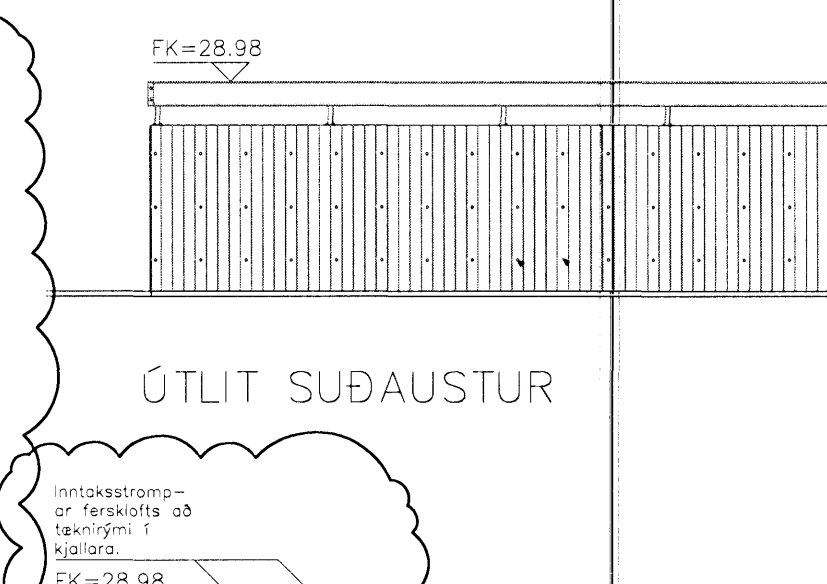

SNID E-E

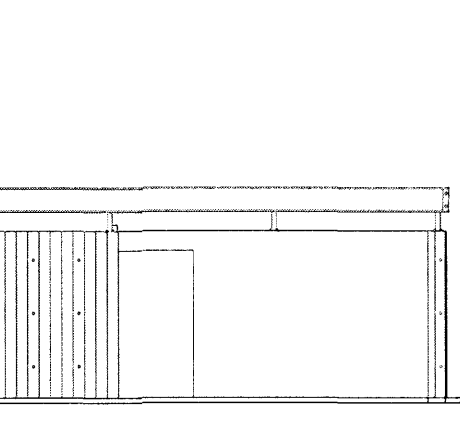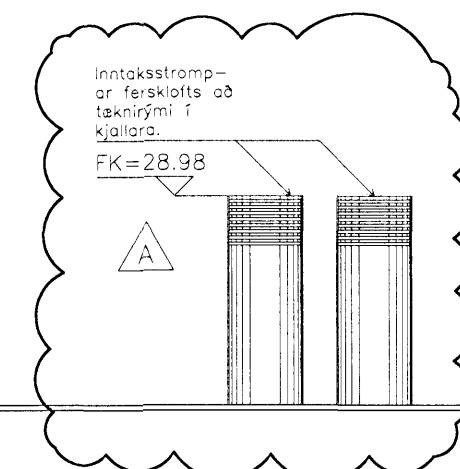


ÚTLIT NORÐVESTUR

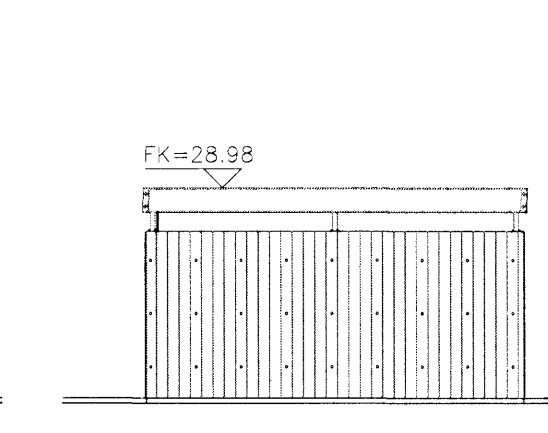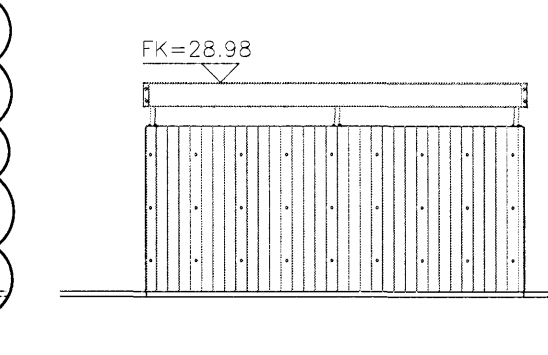

ÚTLIT SUÐVESTUR

D:
C:
B:
A: Höfðarkort snið D-D. Nýtt snið E-E. 30.04.2008
BREYTINGAR: DAGS:

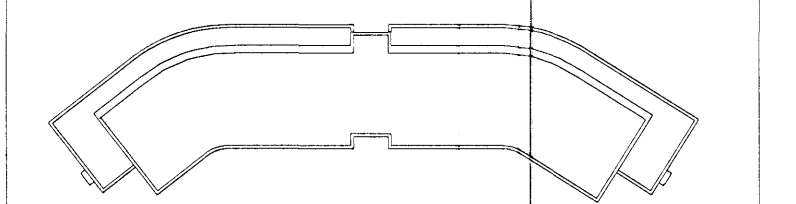

ADALUPPDRATTUR

Dalskraun 3, Hafnarfirði

VERK: DAL5 0608
KVARD: 1:100
DAGS: 31.10.2007
TEKNI: 08

SNID C-C, D-D og E-E SKRÁ: 0608-Grunnur.dwg

ÚTI INNI

ARKITEKTAR

ÞINGHOLTSTRÆTI 27 101 REYKJAVÍK
SÍMA: 5527660 & 5627660 FAX: 5527661
NETFANG: j@u.is
VEFFANG: http://www.u.is
BALDUR O. SVAVARSSON ARKITEKTAR FA
120357-5149
JÓN ÞÓR ÞÓRVALDSSON ARKITEKTAR FA
021256-7579

A
A-108