




ÚTLIT 1:100
Austur

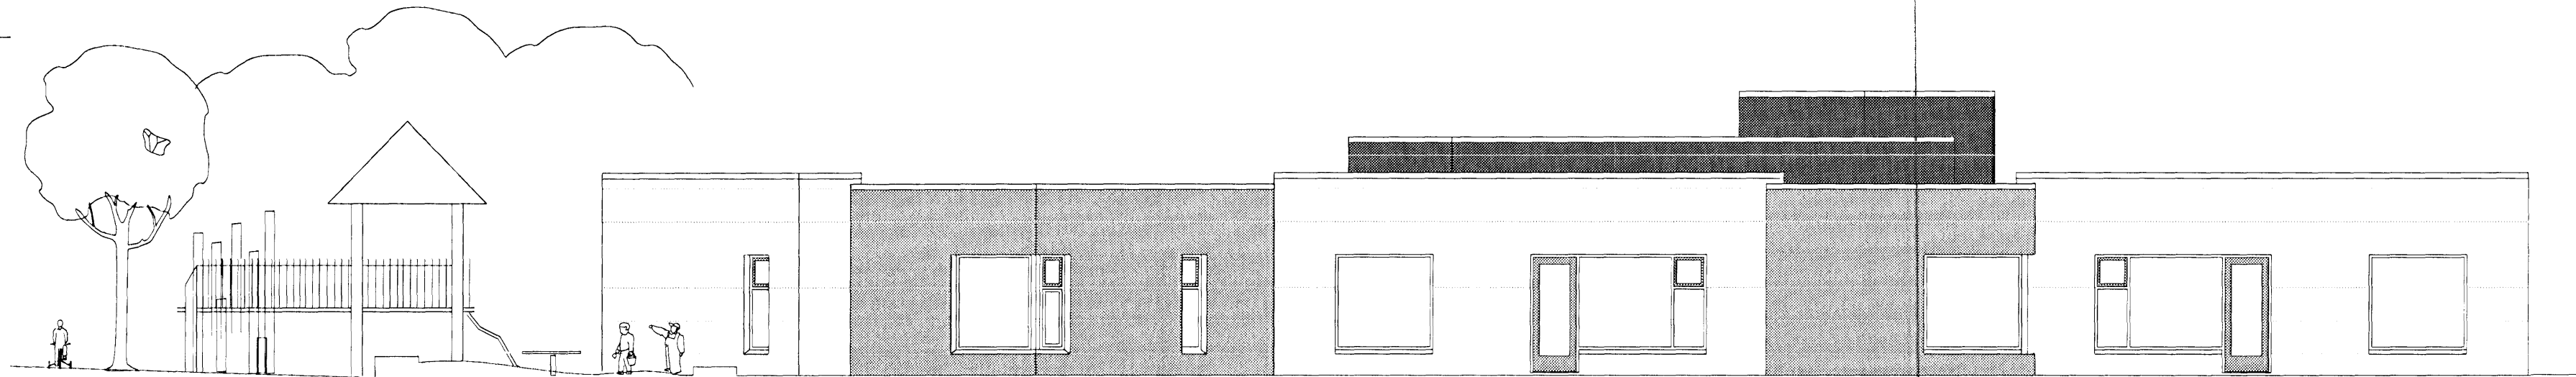

ÚTLIT 1:100
Suður

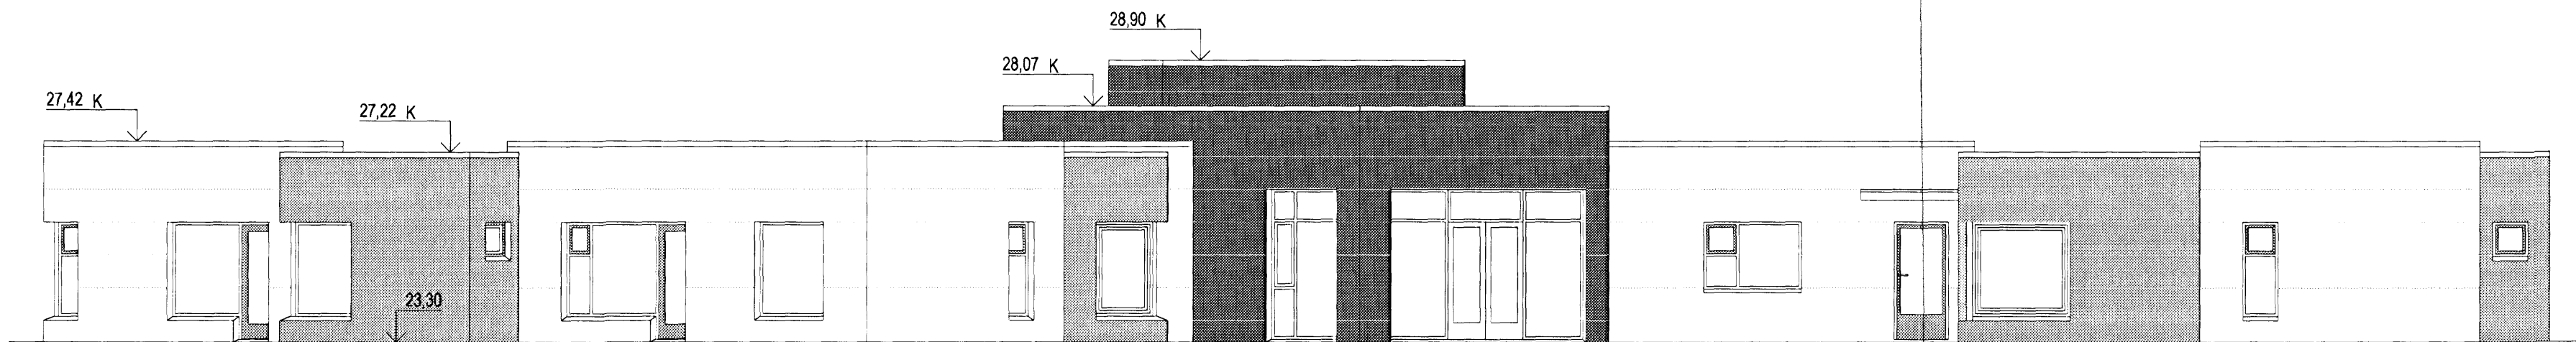

ÚTLIT 1:100
Vestur

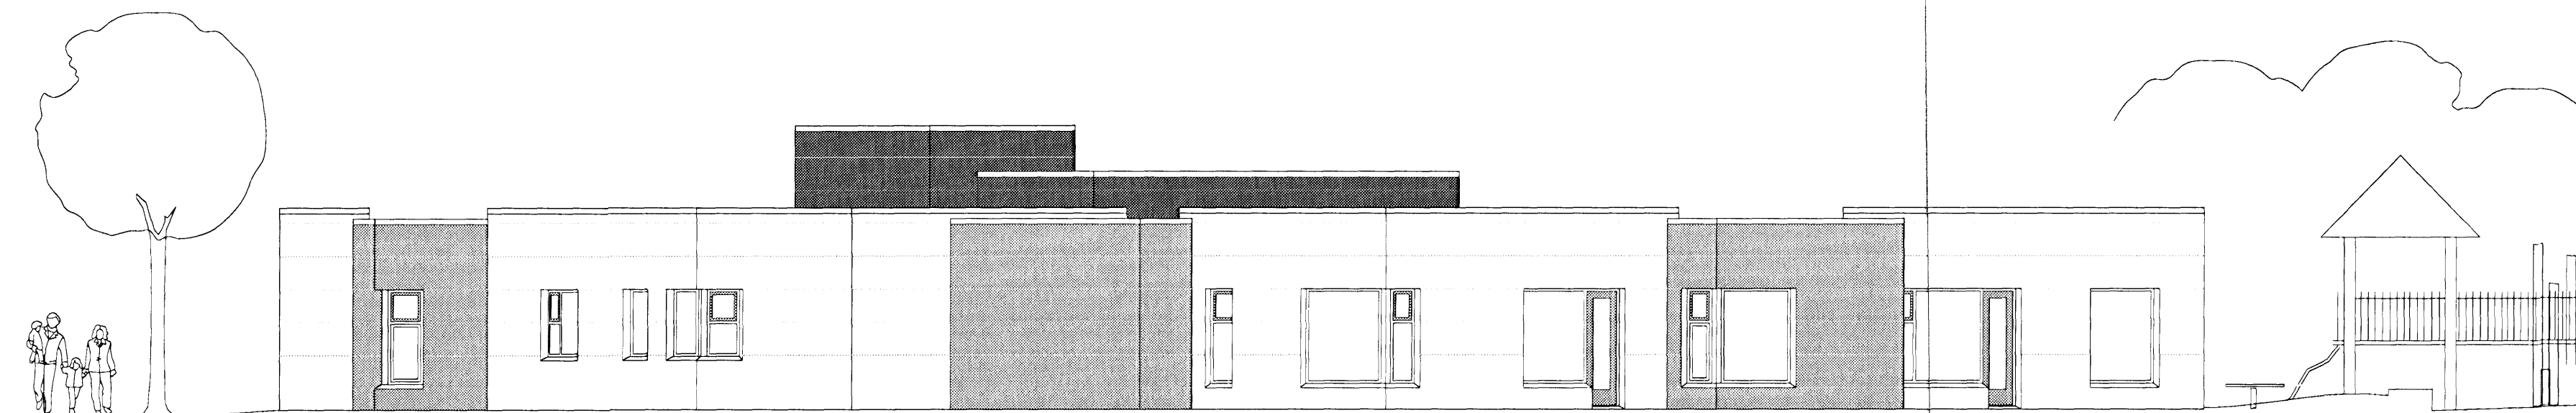

ÚTLIT 1:100
Norður

Sambykkt þann
11 JUN 2008
Byggingaálitunir Hafnarfirði
F.h. Jón Sigurðsson

A	SS	PG	02.06.2008
Tilfærsla á björgunarpum			
ÚTGÁFA	TEIKNAD	SAMBYKKT	DAGS
BREYTINGAR			



ASK Arkitektar
Geisgötu 9
101 Reykjavík
Sími 515 0300
Fax 515 0319
www.ask.is



Ártun aðalhönnuðar:
Páll Gunnlaugsson arkitekt F.A.I. 210552-2199

LEIKSKÓLINN HAMRAVELLIR Hvannavellir 1		ARKIV NÚM. 1:100
HEITI TEIKNINGAR		TEIKNAD HT
AÐALTEIKNINGAR		DAGS 21.05.07
Útlit		ÚTGÁFA A
VERK NR. 06105	NÚMÉR TEIKNINGAR 10-30	