


Sneiðing A-A  
mkv. 1:100




Ásýnd Suður  
mkv. 1:100

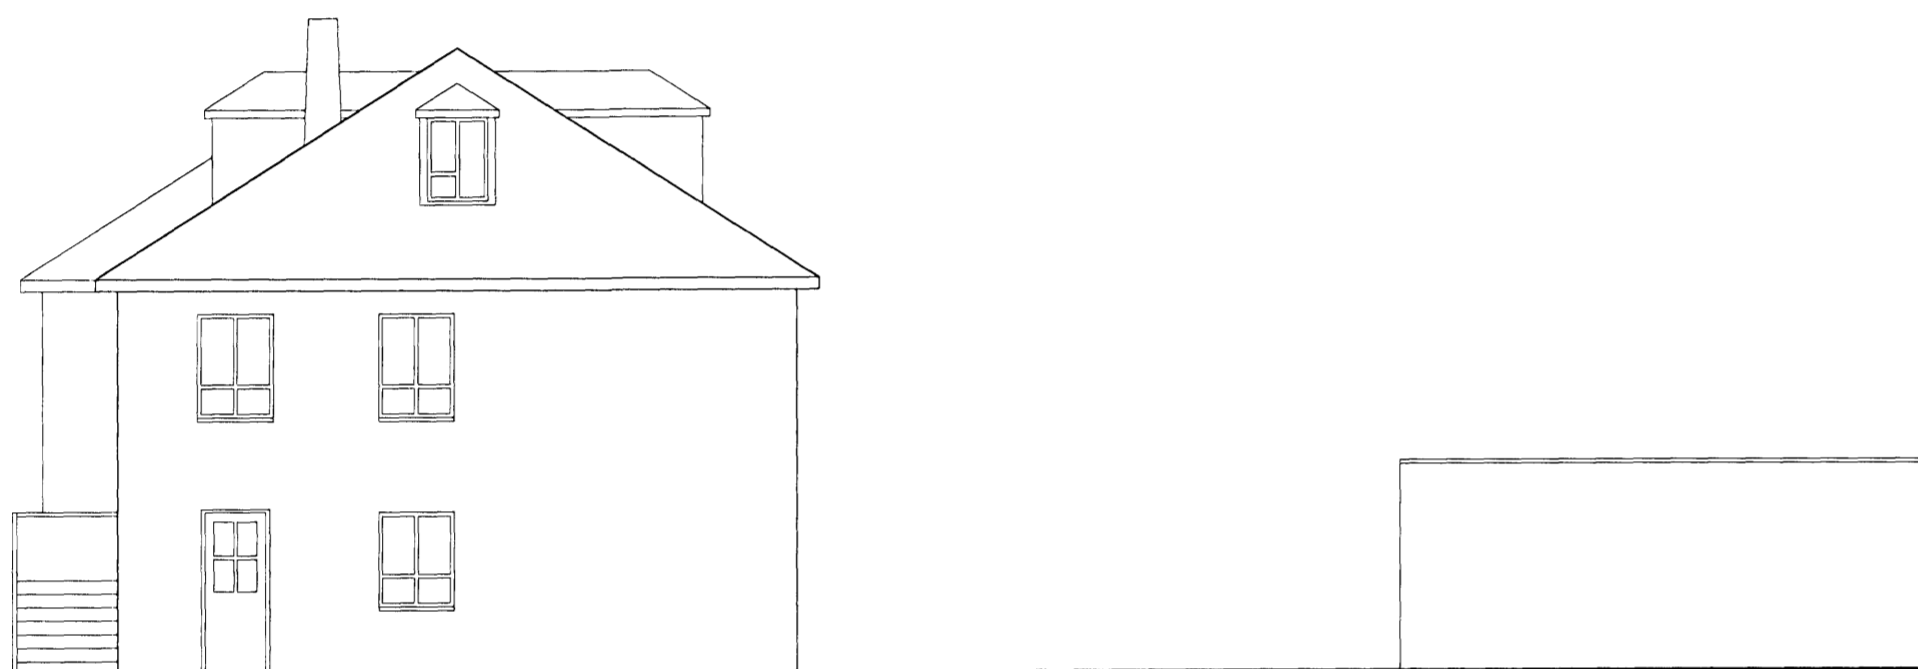

Ásýnd Vestur  
mkv. 1:100



Ásýnd Norður  
mkv. 1:100

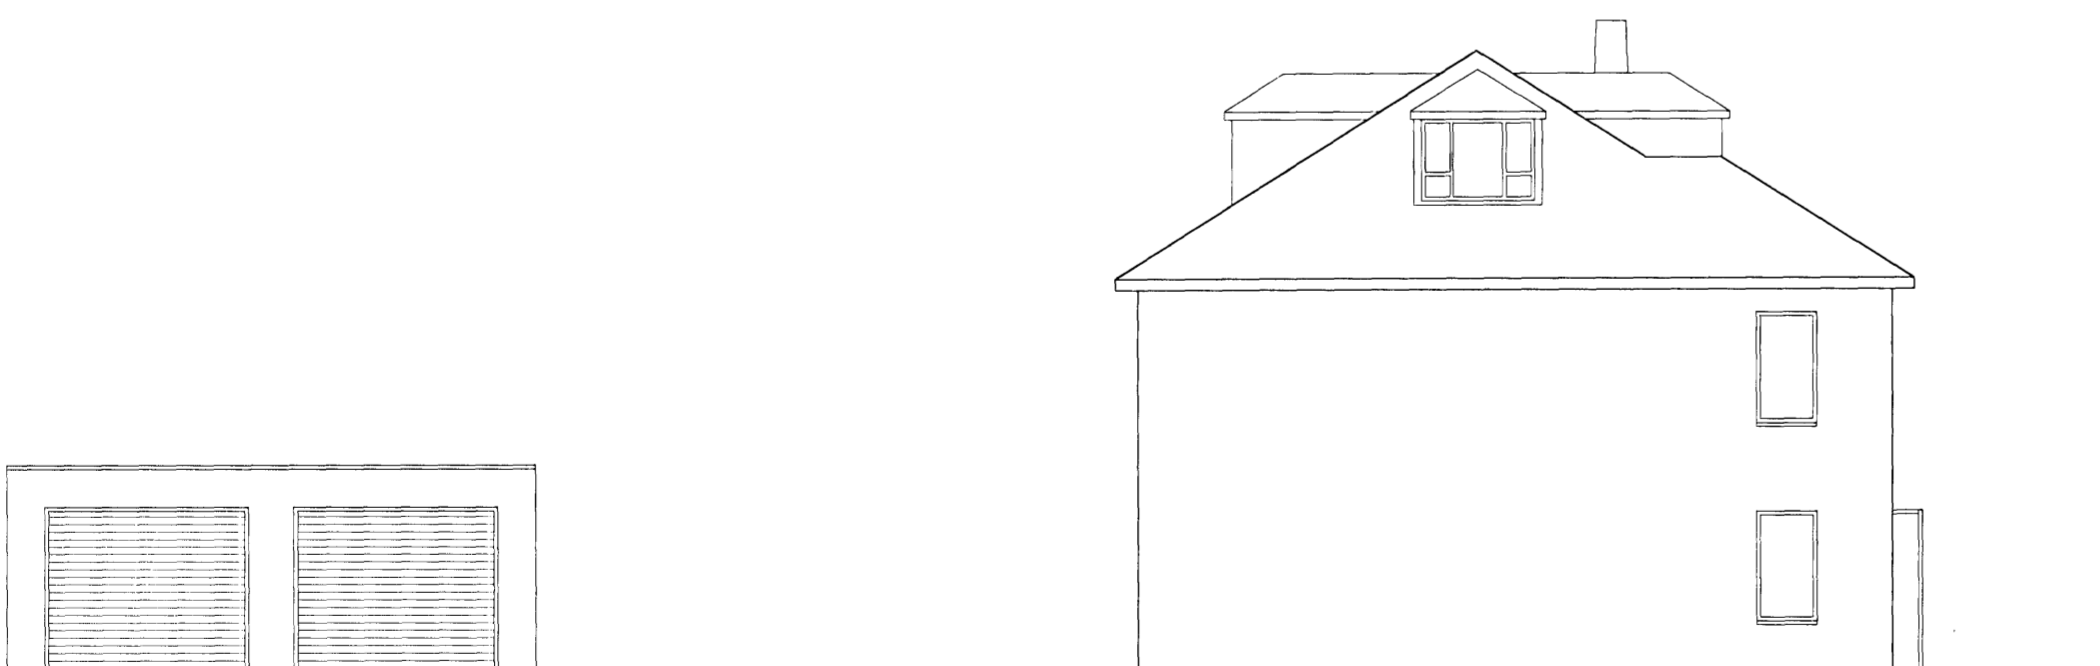

Ásýnd Austur  
mkv. 1:100

Samþykkt þann

5 DEC 2007

Byggingafræðingur  
F.h. Jón Sigurðsson



VERKSTÆÐI ARKITEKTA ehf. - Gunnarssundi 5 - 220 Hfj. - sími: 565 9779  
KÁRI EIRIKSSON arkitekt FAJ - kt: 070365-4059 - email: kari@aoki.is - www.aoki.is

verk  
Arnarhraun 8, Hafnarfjörður  
TVÍBÝLISHÚS

teikning  
Ásýndir

teikning nr.  
0614  
202

Sneiðing A-A

REYNDARTEIKNING

hannað  
KE

dags.  
1. ágúst 2007

mkv.  
1:100

tölvaskrá  
0614-202.dwg

prentað  
29. okt. 2007

bláastærð  
A2

Öll mál eru í millimetrum. Öll vafaatriði skal bera undir hönnuð.  
Mælið ekki af teikningum, öll mál athuglast á staðnum.  
Öll afnot og afritun teikningar, að hluta eða í heild,  
er háð skriflegu leyfi höfundar.

