
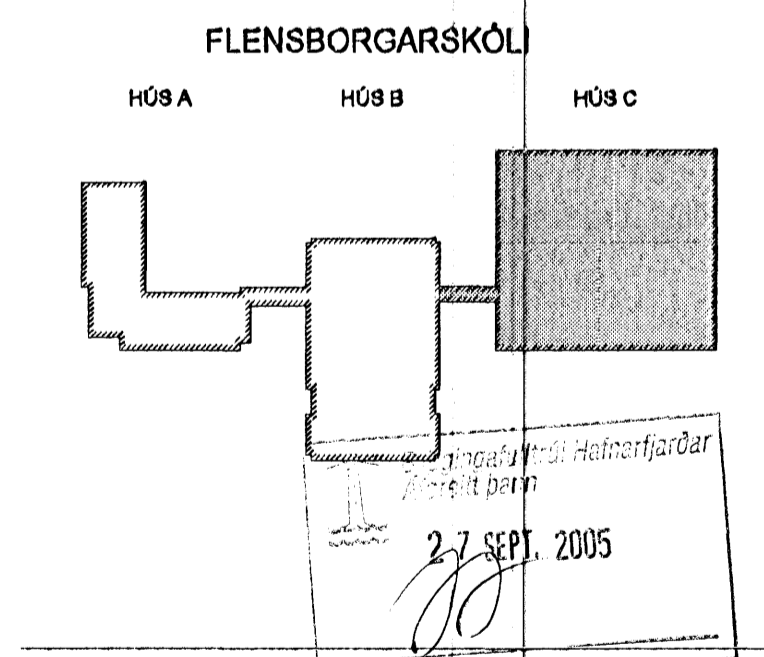
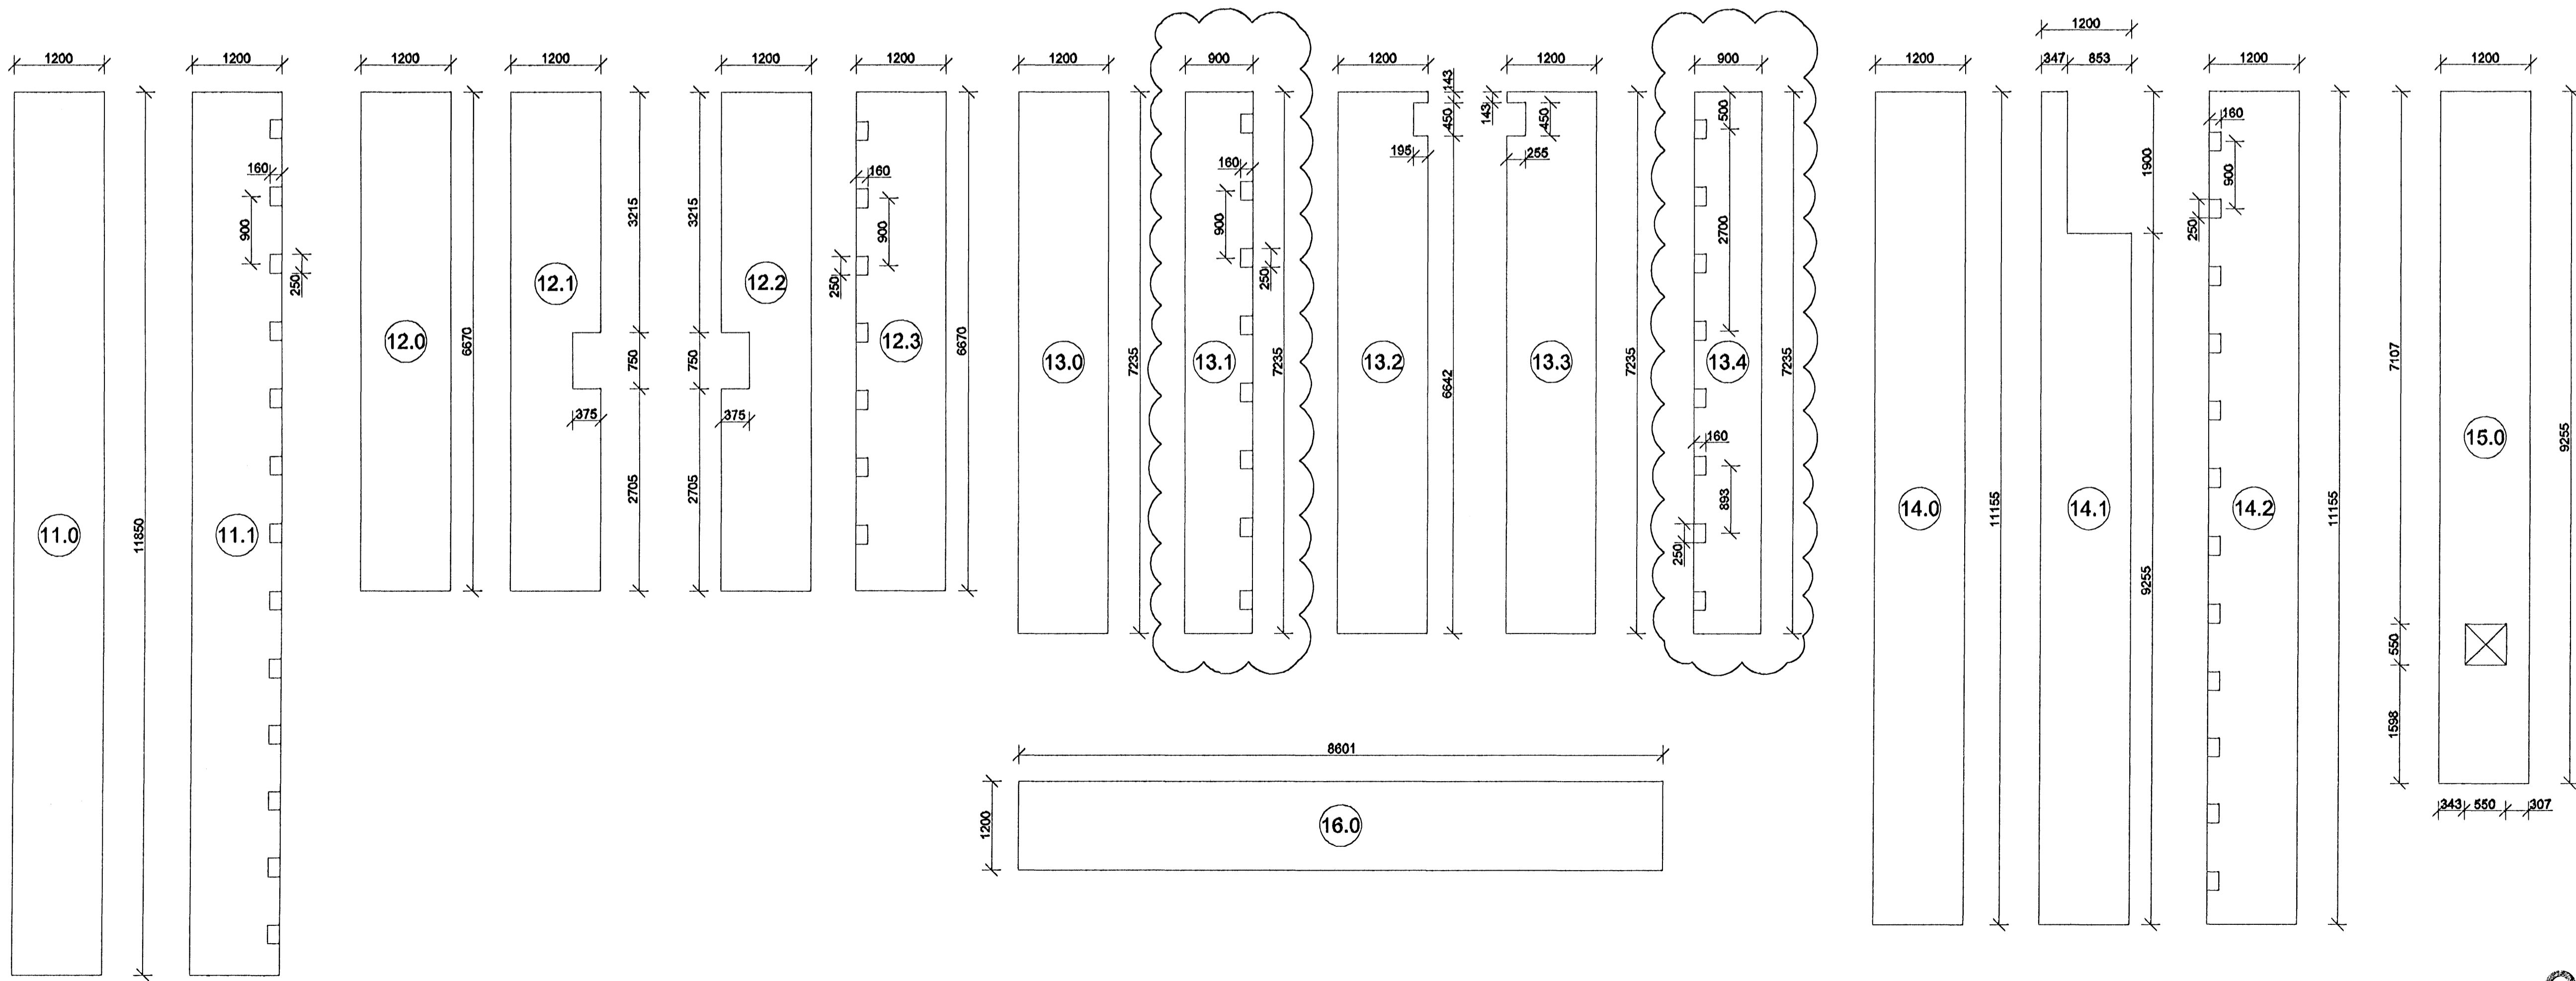


\\VSB\MASTER\VERK\046368\Project\046368\Stuðul\046368_C3-B3-SP-33.dwg

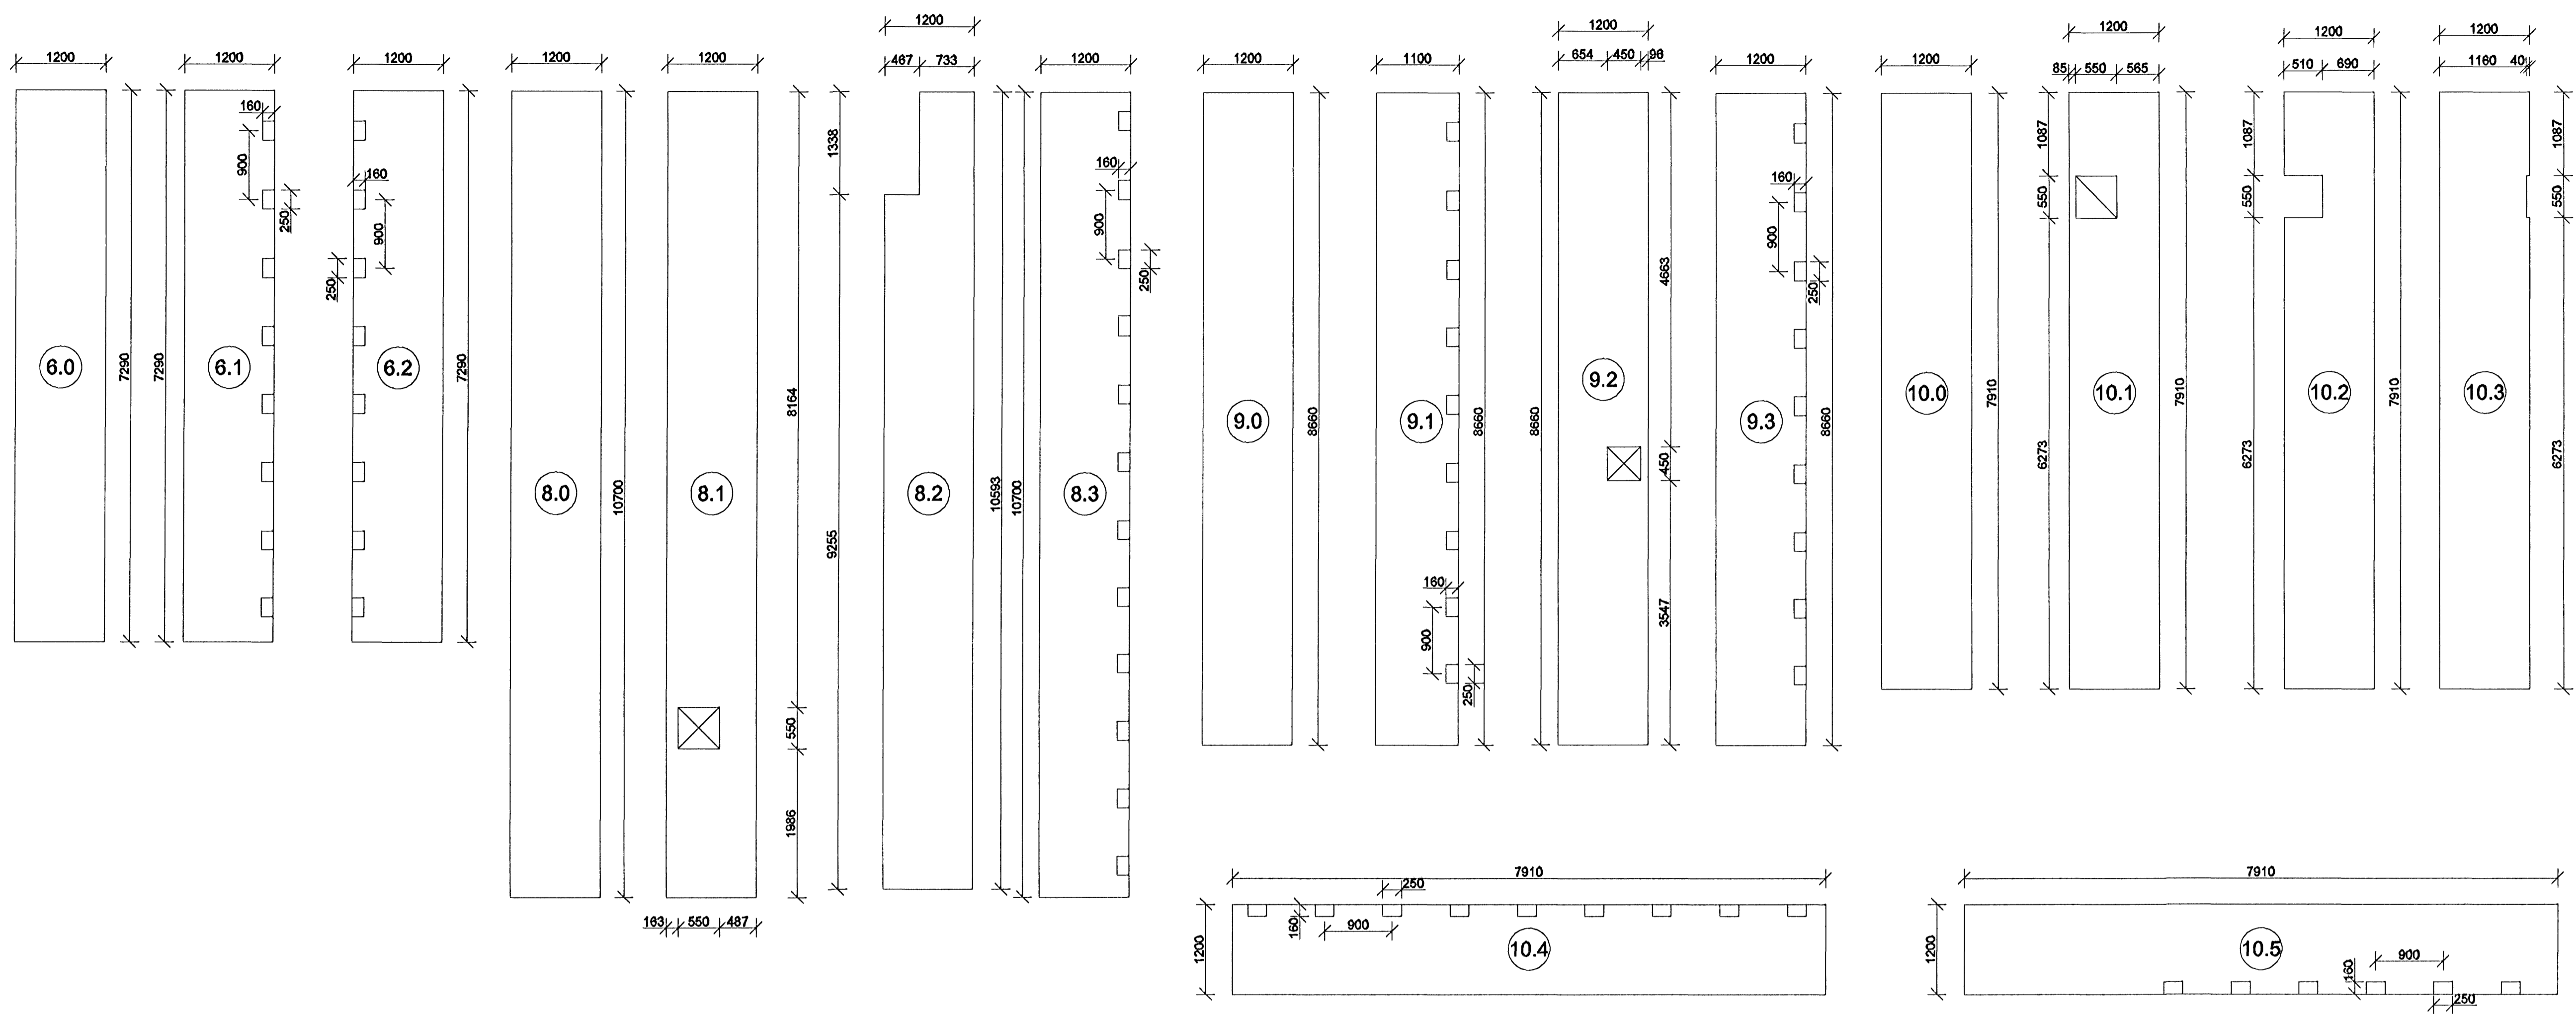

C	23.09.05	Breytingar á hollötum	JR/BG
B	18.08.05	Úttak fyrir langbendingu á hollötum	GD
A	01.07.05	Úrtök vegna lagna	GD/HJ
Úlg.	Daga	Skýring	Hanna Ö. Yfirfaró

VSB
VERKFRÆÐISTOFA

BÆJARHRAUNI 20 · 220 HAFNARFJÖRÐUR · KENNIT. 710798-2899

Artun sérhönnuðar
Björn Guðafasson, 180550-4889

Verkefni
**BREKKUGATA 19
HAFNARFJÖRÐUR**

Verkið
**BURÐARVIRKI
SÉRTEIKNING HOLPLATNA YFIR 3. HÆÐ**

Hanna Ö. HÖJ	Tekjad HÖJ	Yfirfaró	Kvartl 1:50 / A1	Siga
Daga 09.08.2005	Verkefni 04836	Tekning C3-B3-SP-33	Útgáfa C	

