



ARTUN SAMRÉINGARHÖNDUÐAR  
 TEIKNINGARFRAMAUFAR  
 2005

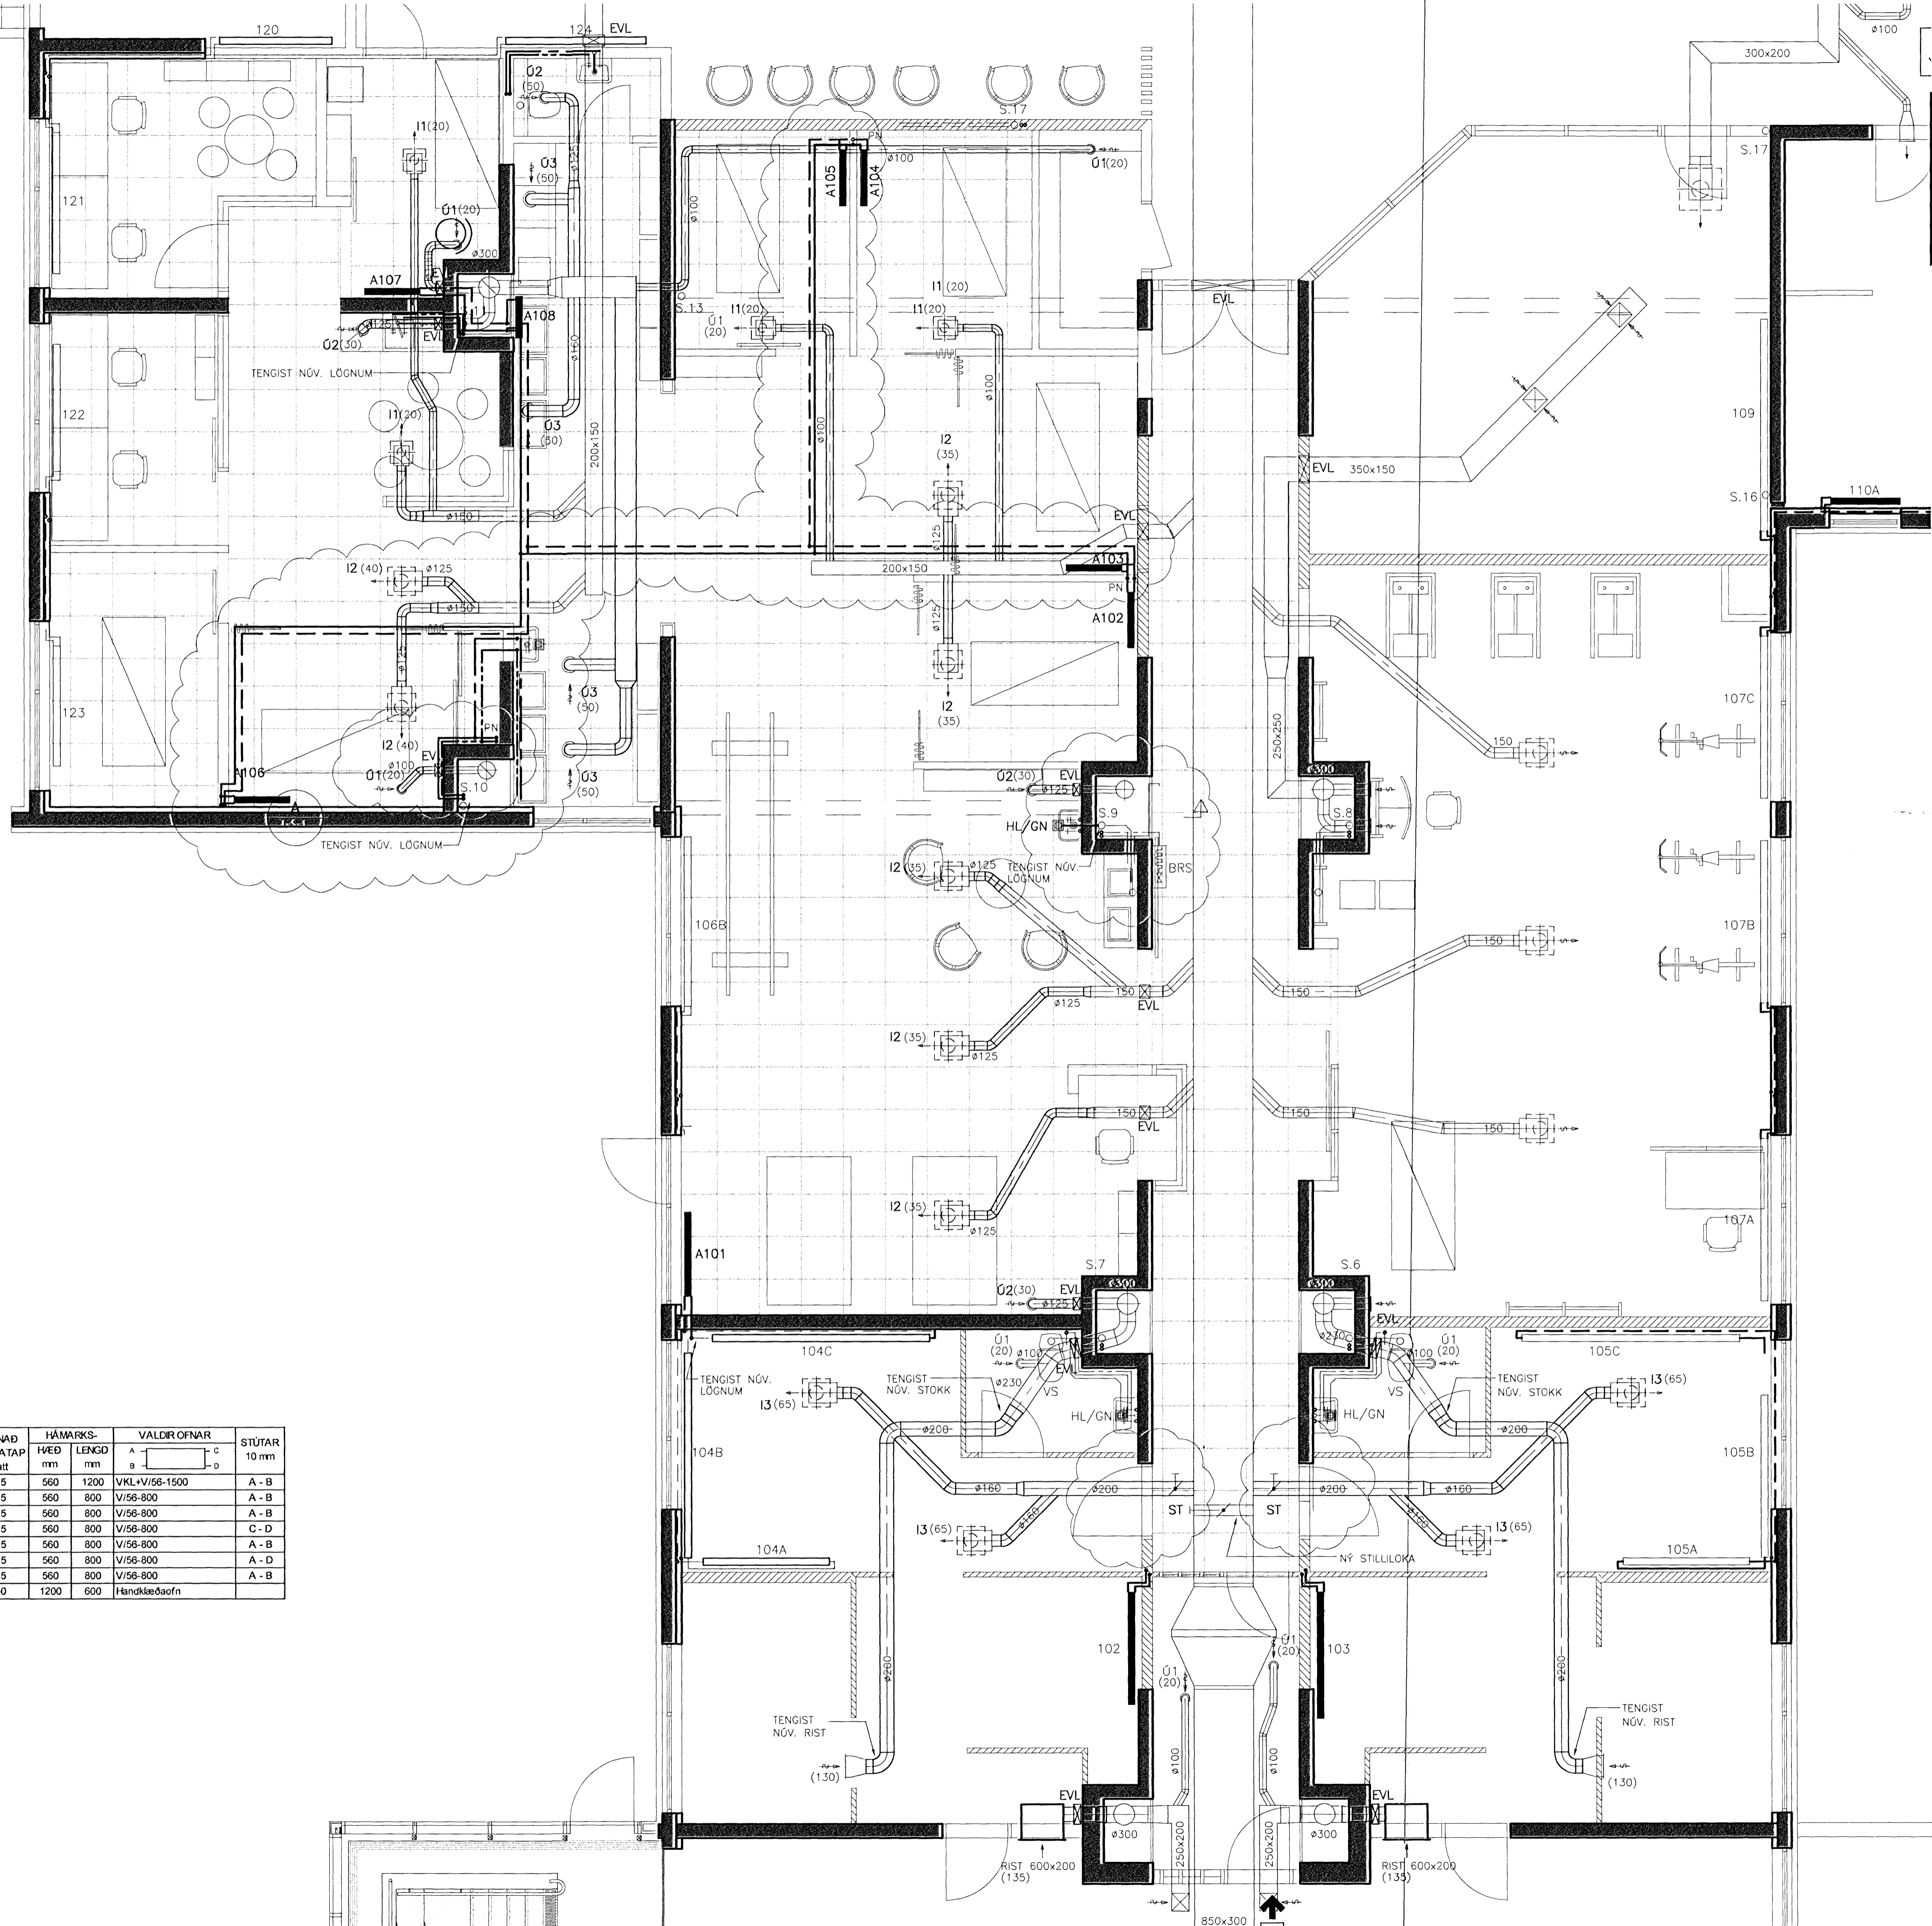

OFNASKRÁ

NR.	REKNAÐ VARMATAP Watt	HÁMARKS- HVÆÐ mm	LÉNGBD mm	VALDR OFNAR			STÚTAR 10 mm
				A	B	C	
A101	975	560	1200	VKL-VI/56-1500			A - B
A102	315	560	800	VI/56-800			A - B
A103	315	560	800	VI/56-800			A - B
A104	315	560	800	VI/56-800			C - D
A105	315	560	800	VI/56-800			A - B
A106	315	560	800	VI/56-800			A - D
A107	315	560	800	VI/56-800			A - B
A108	450	1200	600	Handklæðsöfn			

C	20.09.05	REYNDARTEIKNING	KH	BH
B	13.09.05	BRUNALOKUR Í NÓV. ÖTISOGSSTOKKA	KH	BH
A	01.09.05	LOFTFRÆSKERFI BREYTT Í BÖGNINGARSTÖÐU	KH	BH
BR.	DAGS.	BREYTING	REKNA.	TEKNA.

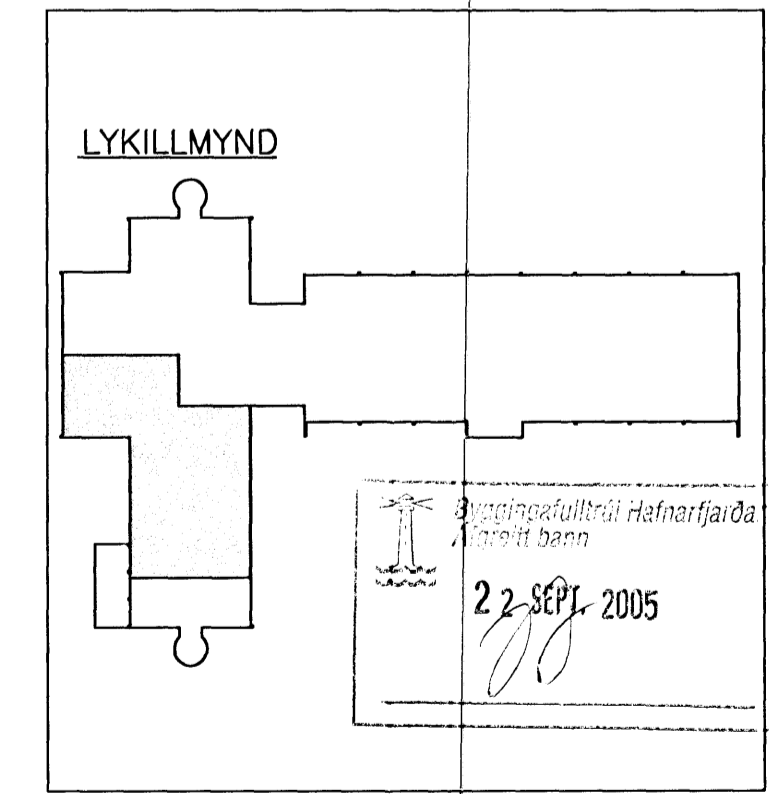

**VSÓ RÁÐGJÖF**  
 BORGARTOWN 20, 105 REYKJAVÍK, SÍM 585-9000, VÖRUBÉÐ 585-9010, NETfang vs@vso.is

**HRAFNISTA HAFNARFIRDI SJÓKRAPJÁLFUN**

PRIFA-, HITA OG LOFTFRÆSKERFI  
 1. HÆÐ  
 GRUNNMYND

MANND/TEKN. KH/BH  
 YFIRFAR. BH  
 SAMHYKKT. BH  
 KE. 23.087-3719  
 REYKJAVÍK 14.08.2005

KVARÐI 1:50  
 VERKNR. REYKJAVÍK NR. BR.

05120 L1-G1-1 C