



SUDJRHLID
 1:100

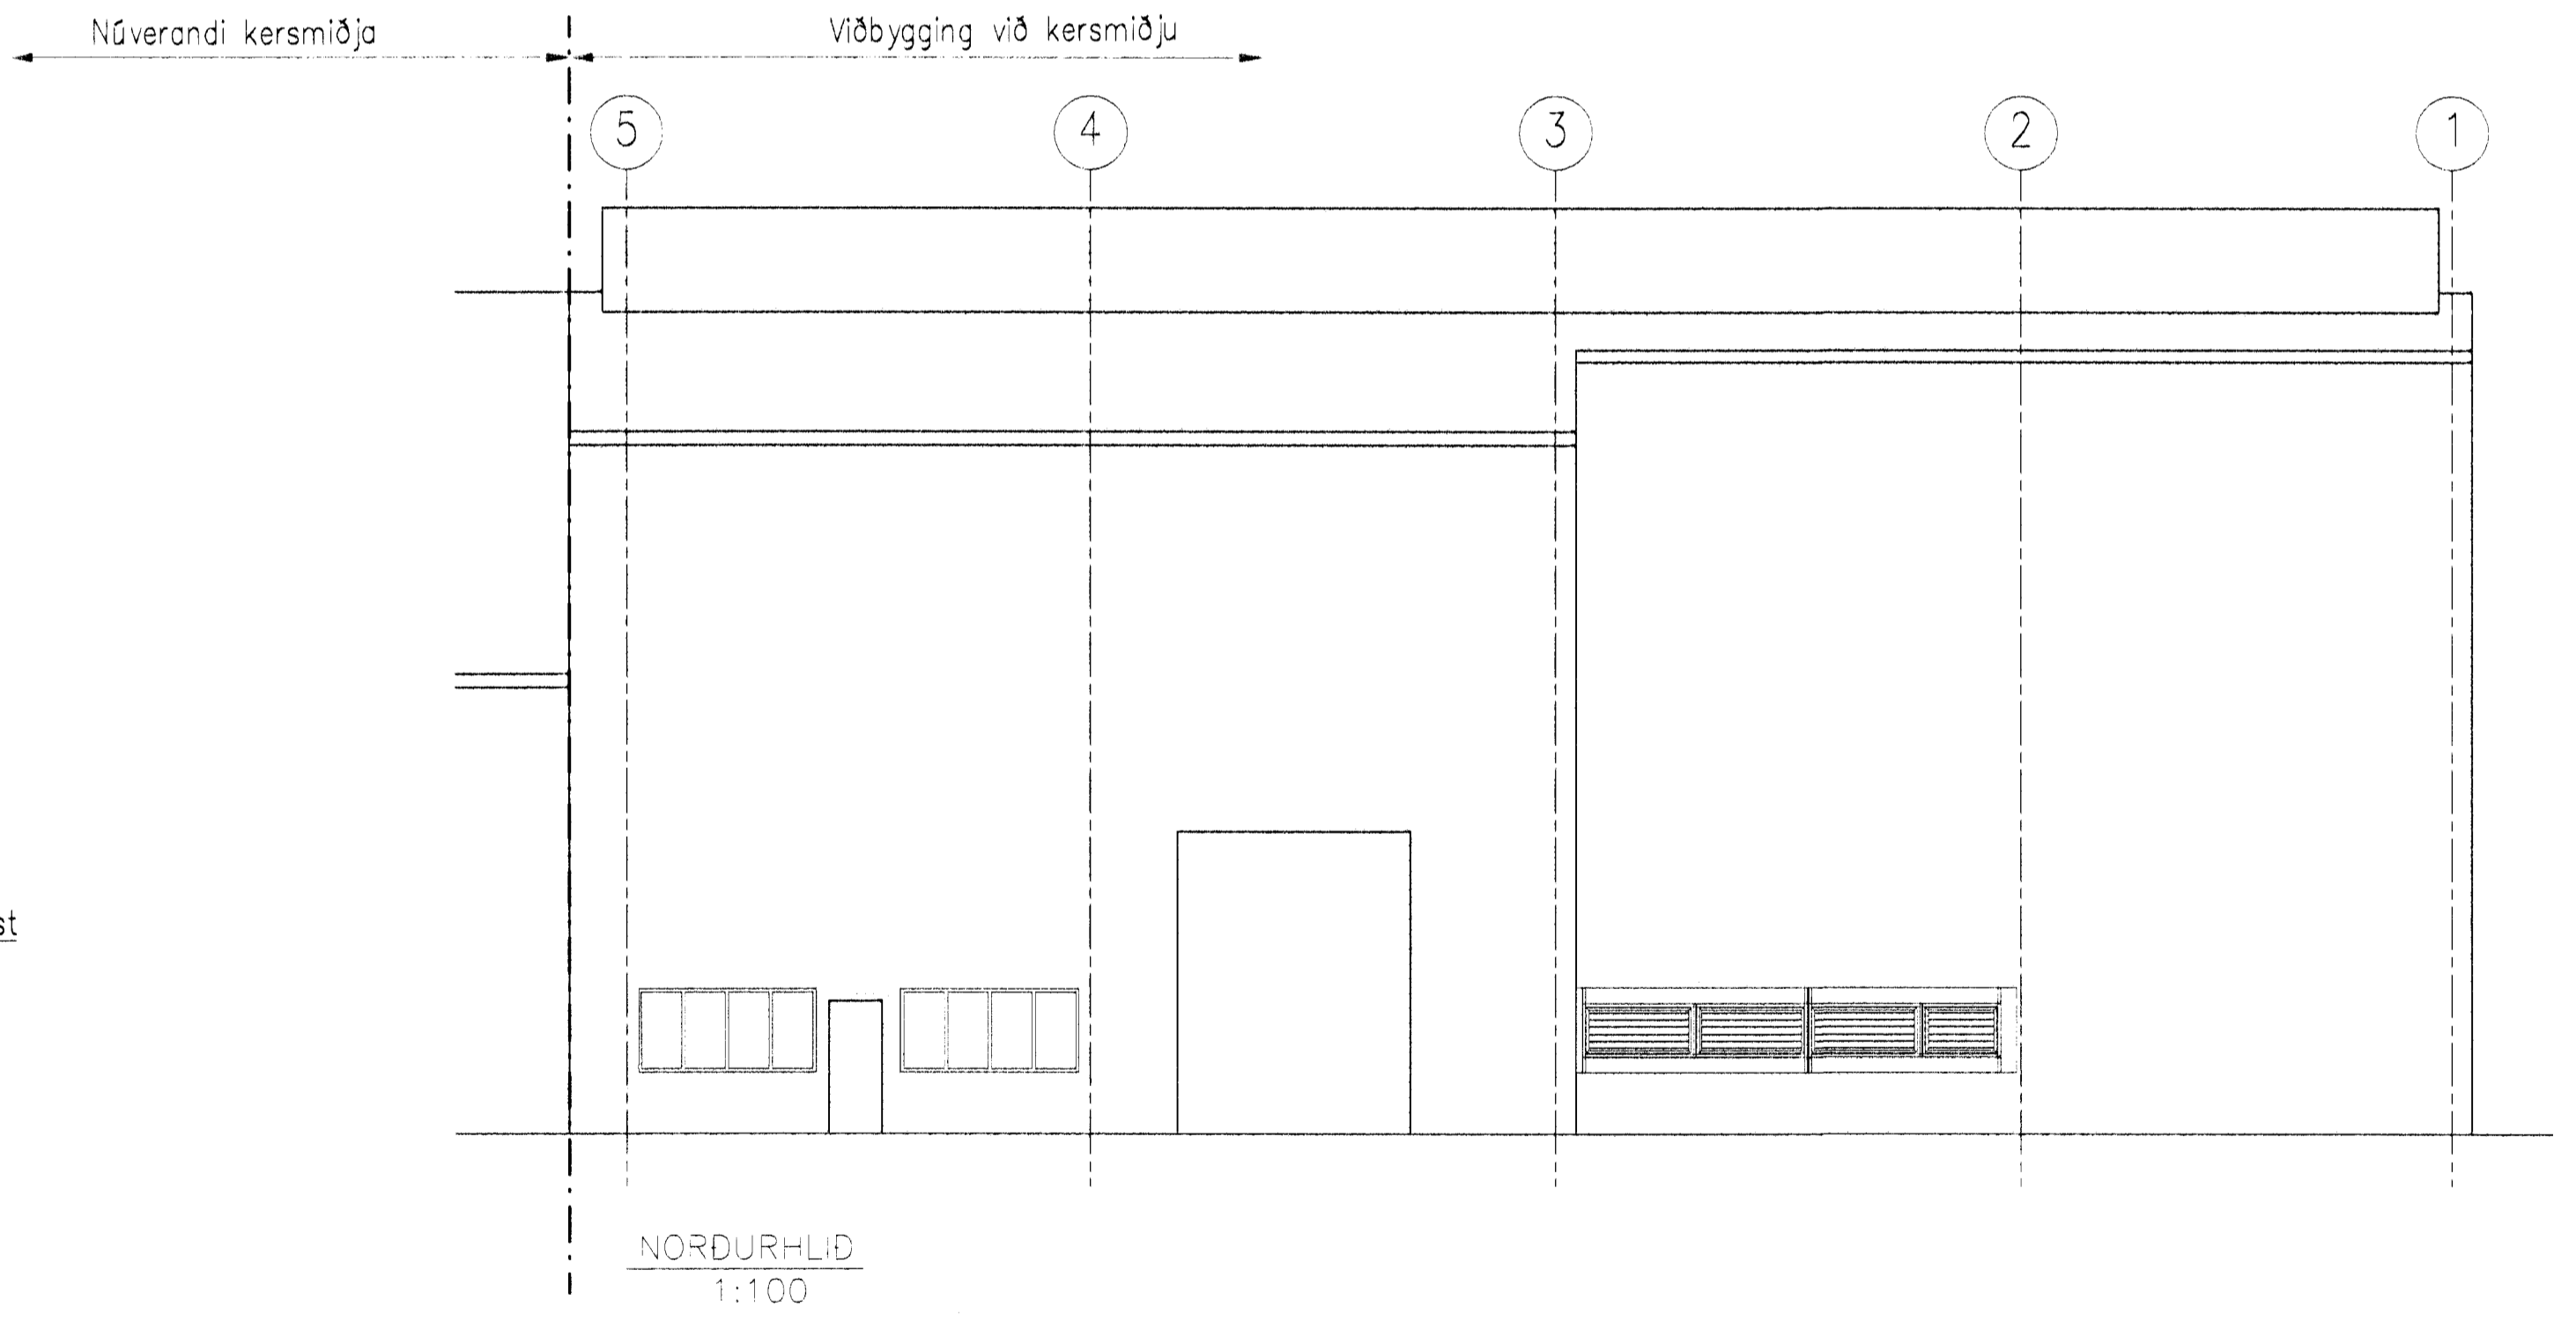

NORDURHLID
 1:100

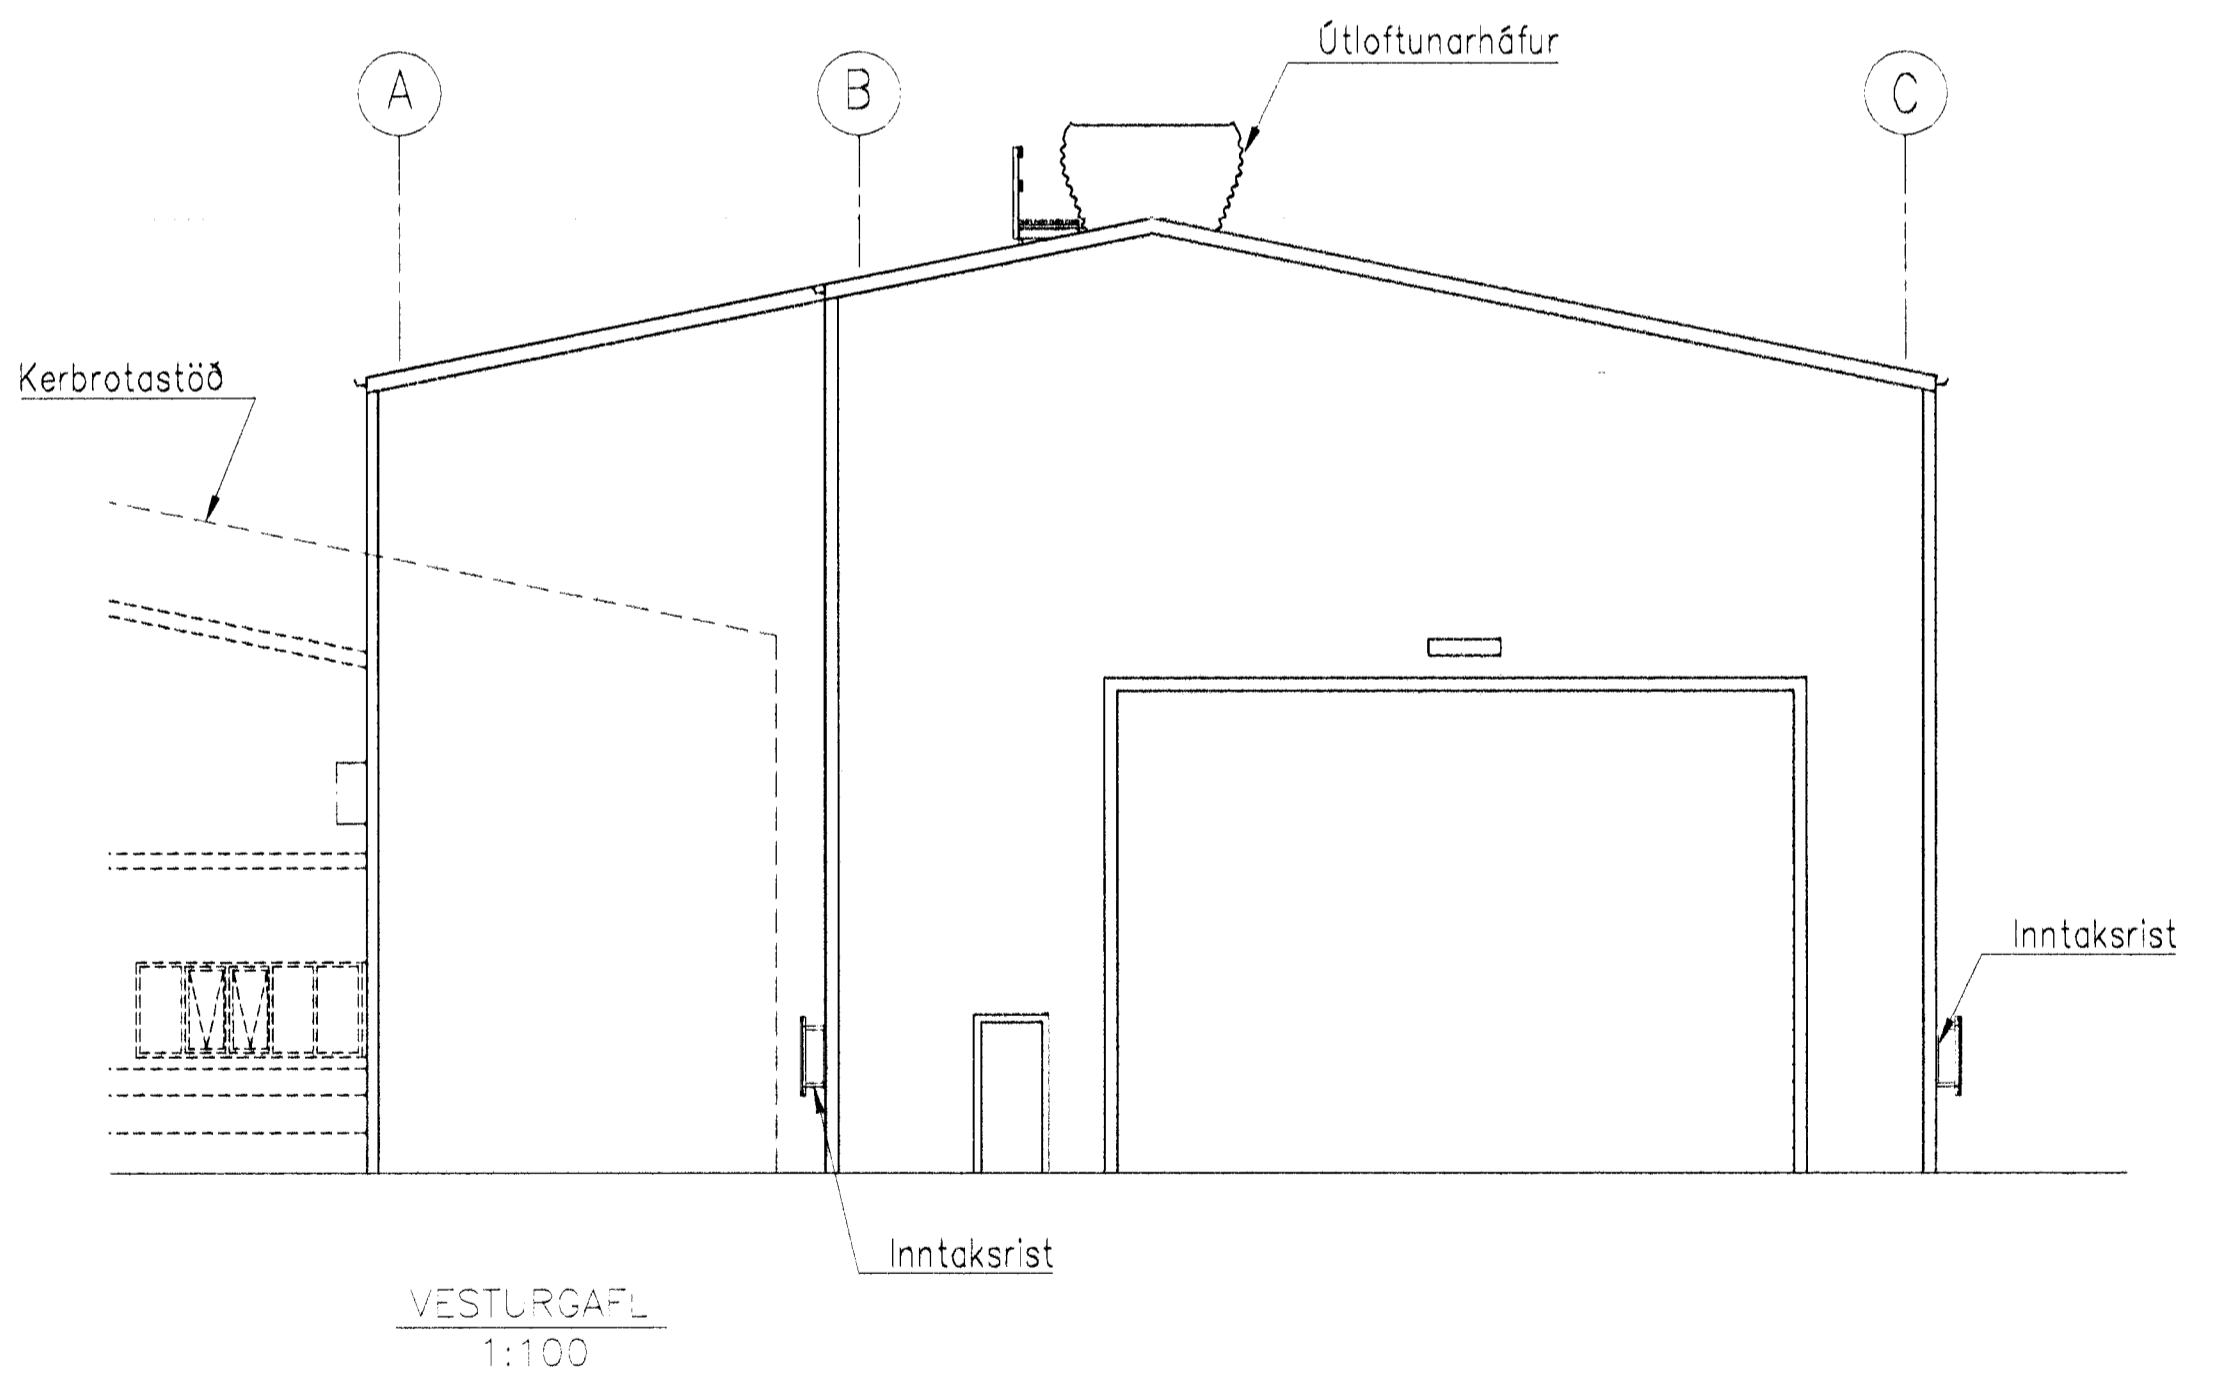

VESTURGAFL
 1:100

Ragn Þeirlaunsson 66.0602.48-3119

Skýringar:
 Explanations:



A		Reyndartekninga	28.12.2009	PRG		
Breyt.	Rev.	Breyting	Date	Samþ.	Valk. heiml.	Released
Tev. teikningar nr. SAL		Samsetn. teikningar nr. ISAL		Tolkn.		
Ref. drawing no. of SAL		Assembly drawing no. of SAL		Drawn		

This drawing is the property of the Alcan Iceland Ltd. and handed out for personal use only. It may neither be copied nor made available to others without permission of the Alcan Iceland Ltd. The receiver is liable for any misuse.

Fjöld. stykja	Hitur	Athöf.	Þf.	Þ. g.	Mál. / mál.	Athugasemdir
Number of pieces	Object	Item	Material	Weight	Scale	Remarks
IV	Kersmiðja				1:100	
	Viðbygging við kersmiðju				5110_01224	
	Útlit og snið				UK1	
Verk. / Super		VERKÍS			185302	
Teknað	AM	22.01.08	Höfundur	PRG	31.01.08	
Dragna			Dragna			
ALCAN PRIMARY METAL EUROPE		Straumsvík		Dragna af SAL / Tekning SAL		
ISAL		8-222 Hafnarfordur		185302		
Alcan Iceland Ltd				A		
Tolkn.		Höfundur og gætt		Tolkn.		
Drawn		Checked and signed		Released		