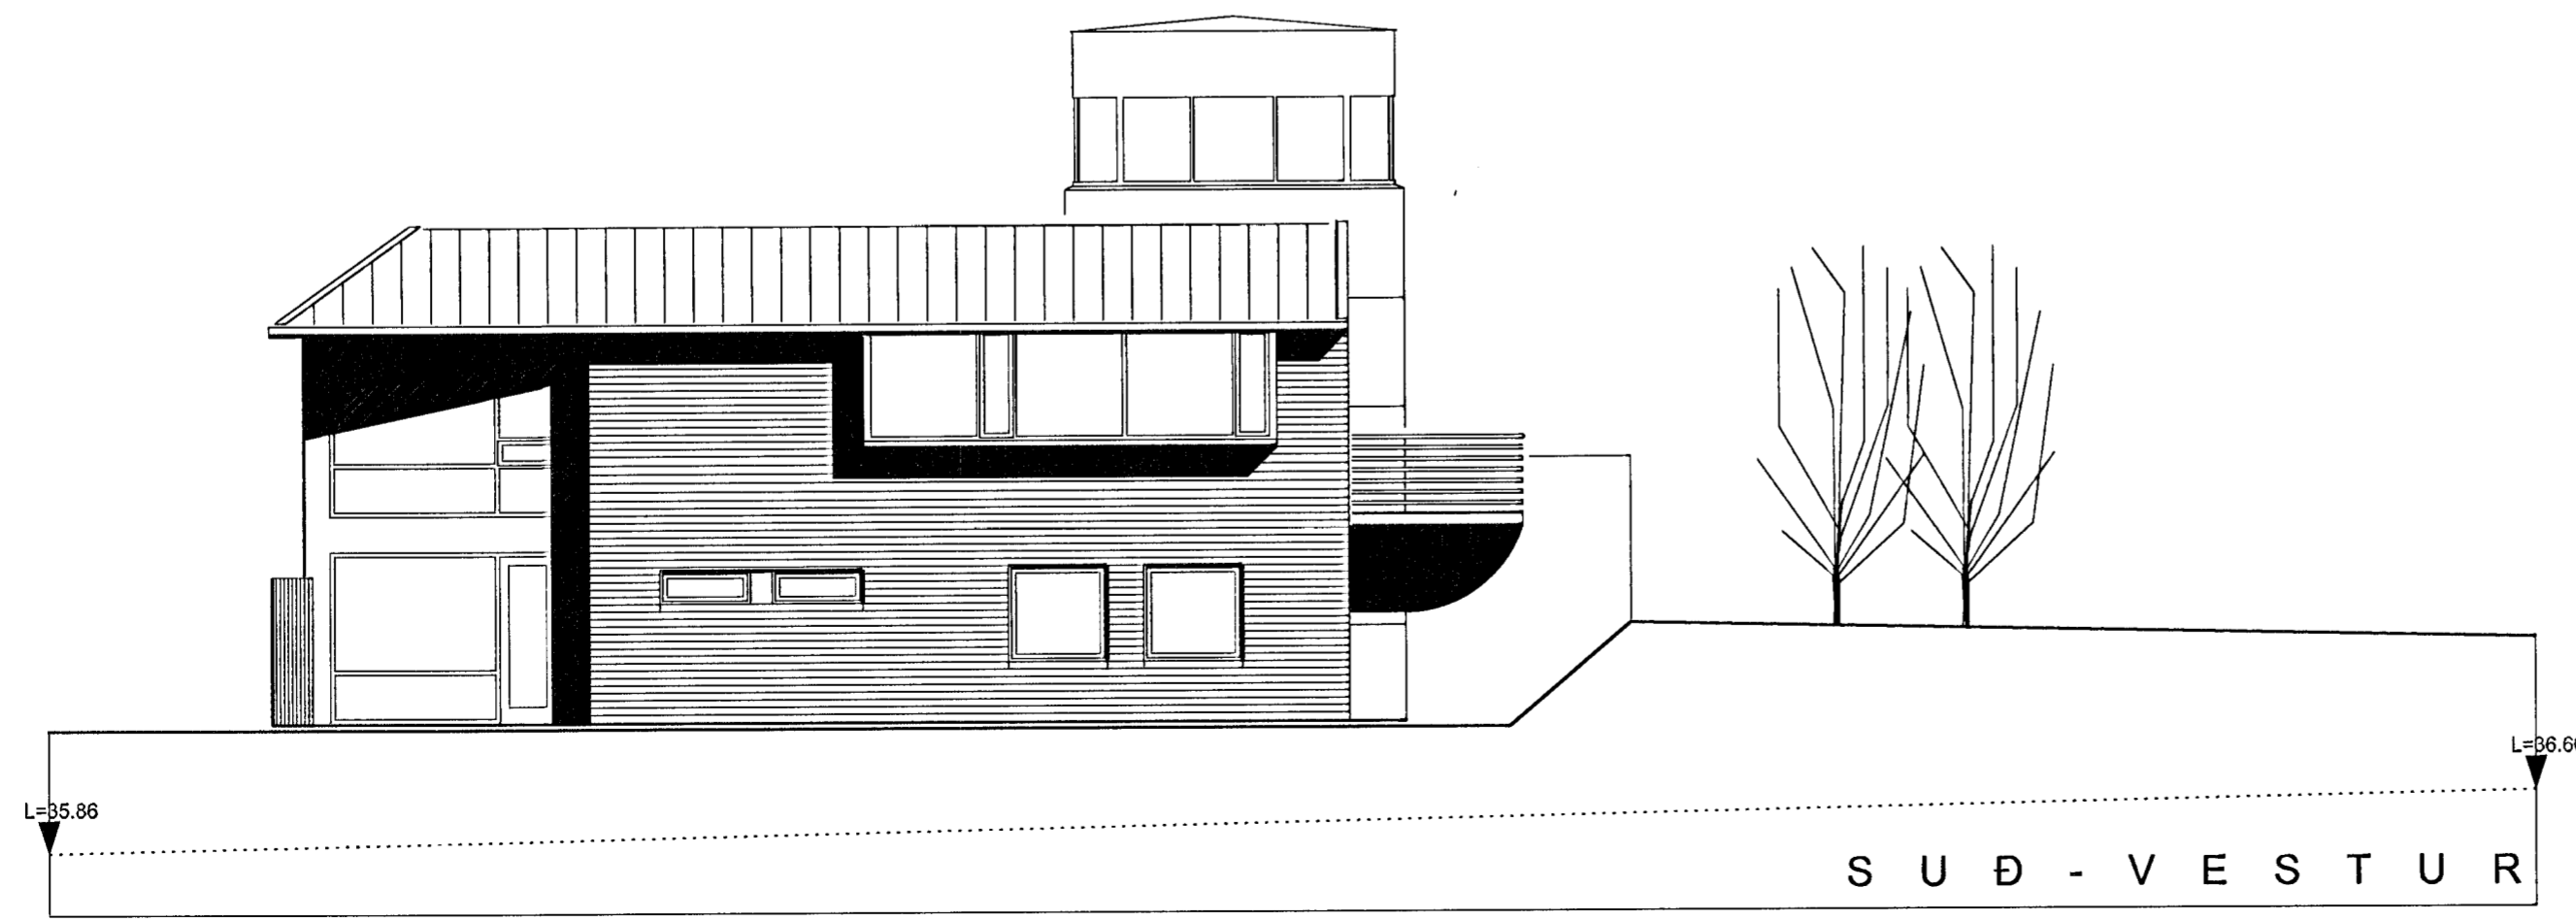
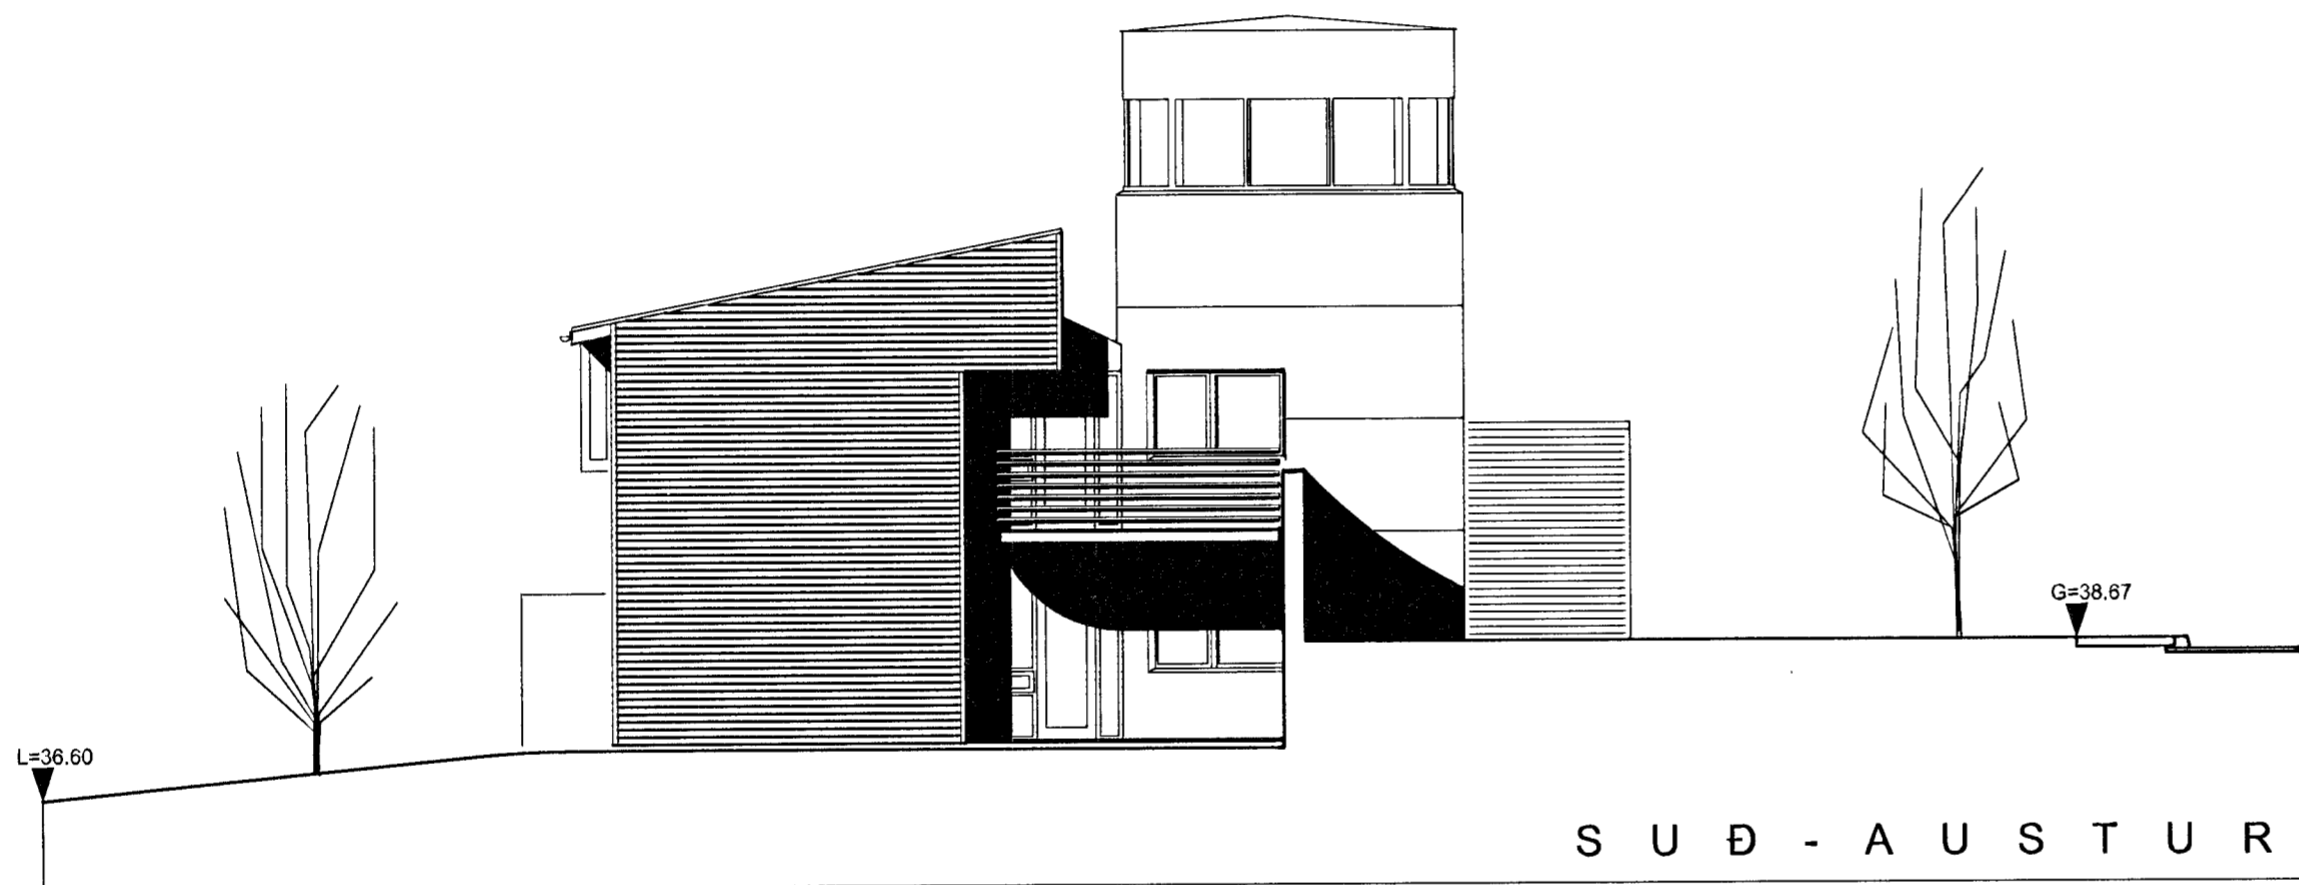
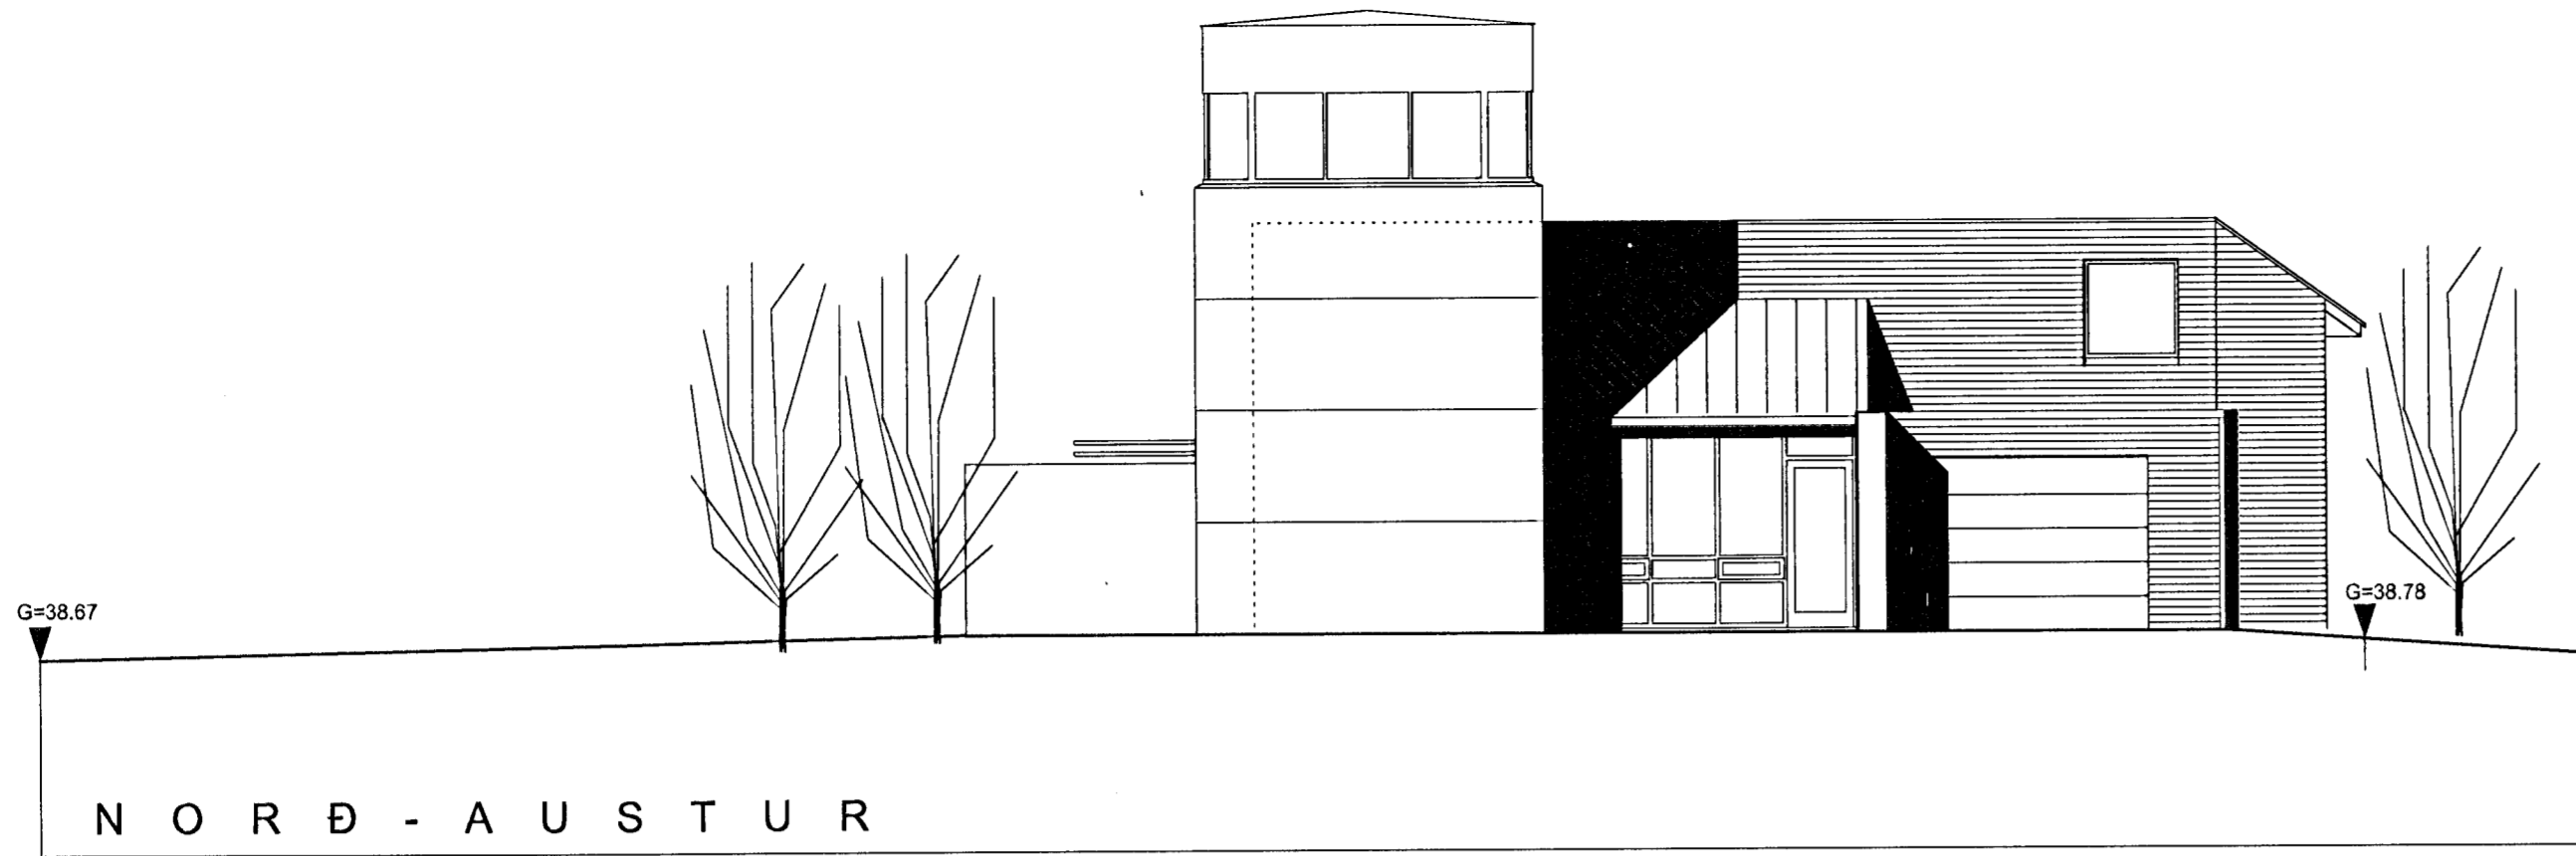

 Ólafur Ó. Axelsson
 12. AUG 2009



BREYTT : B : 07.07 2009 reyndarteikning
 BREYTT : A : 19.01 2003
 MKV : 1:100
 NÓVEMBER 2002
 HÖNNUN : Ó.A.

HÁBERG 31 HAFNARFIRÐI
 ÚTLITSMYNDIR



ÓLAFUR Ó. AXELSSON arkitekt FAÍ
 KJARTANSGÖTU 2 105 REYKJAVÍK
 sími 588 0412 farsími 663 5693
 kt 041251-3019 olafur@vaarkitektar.is

04