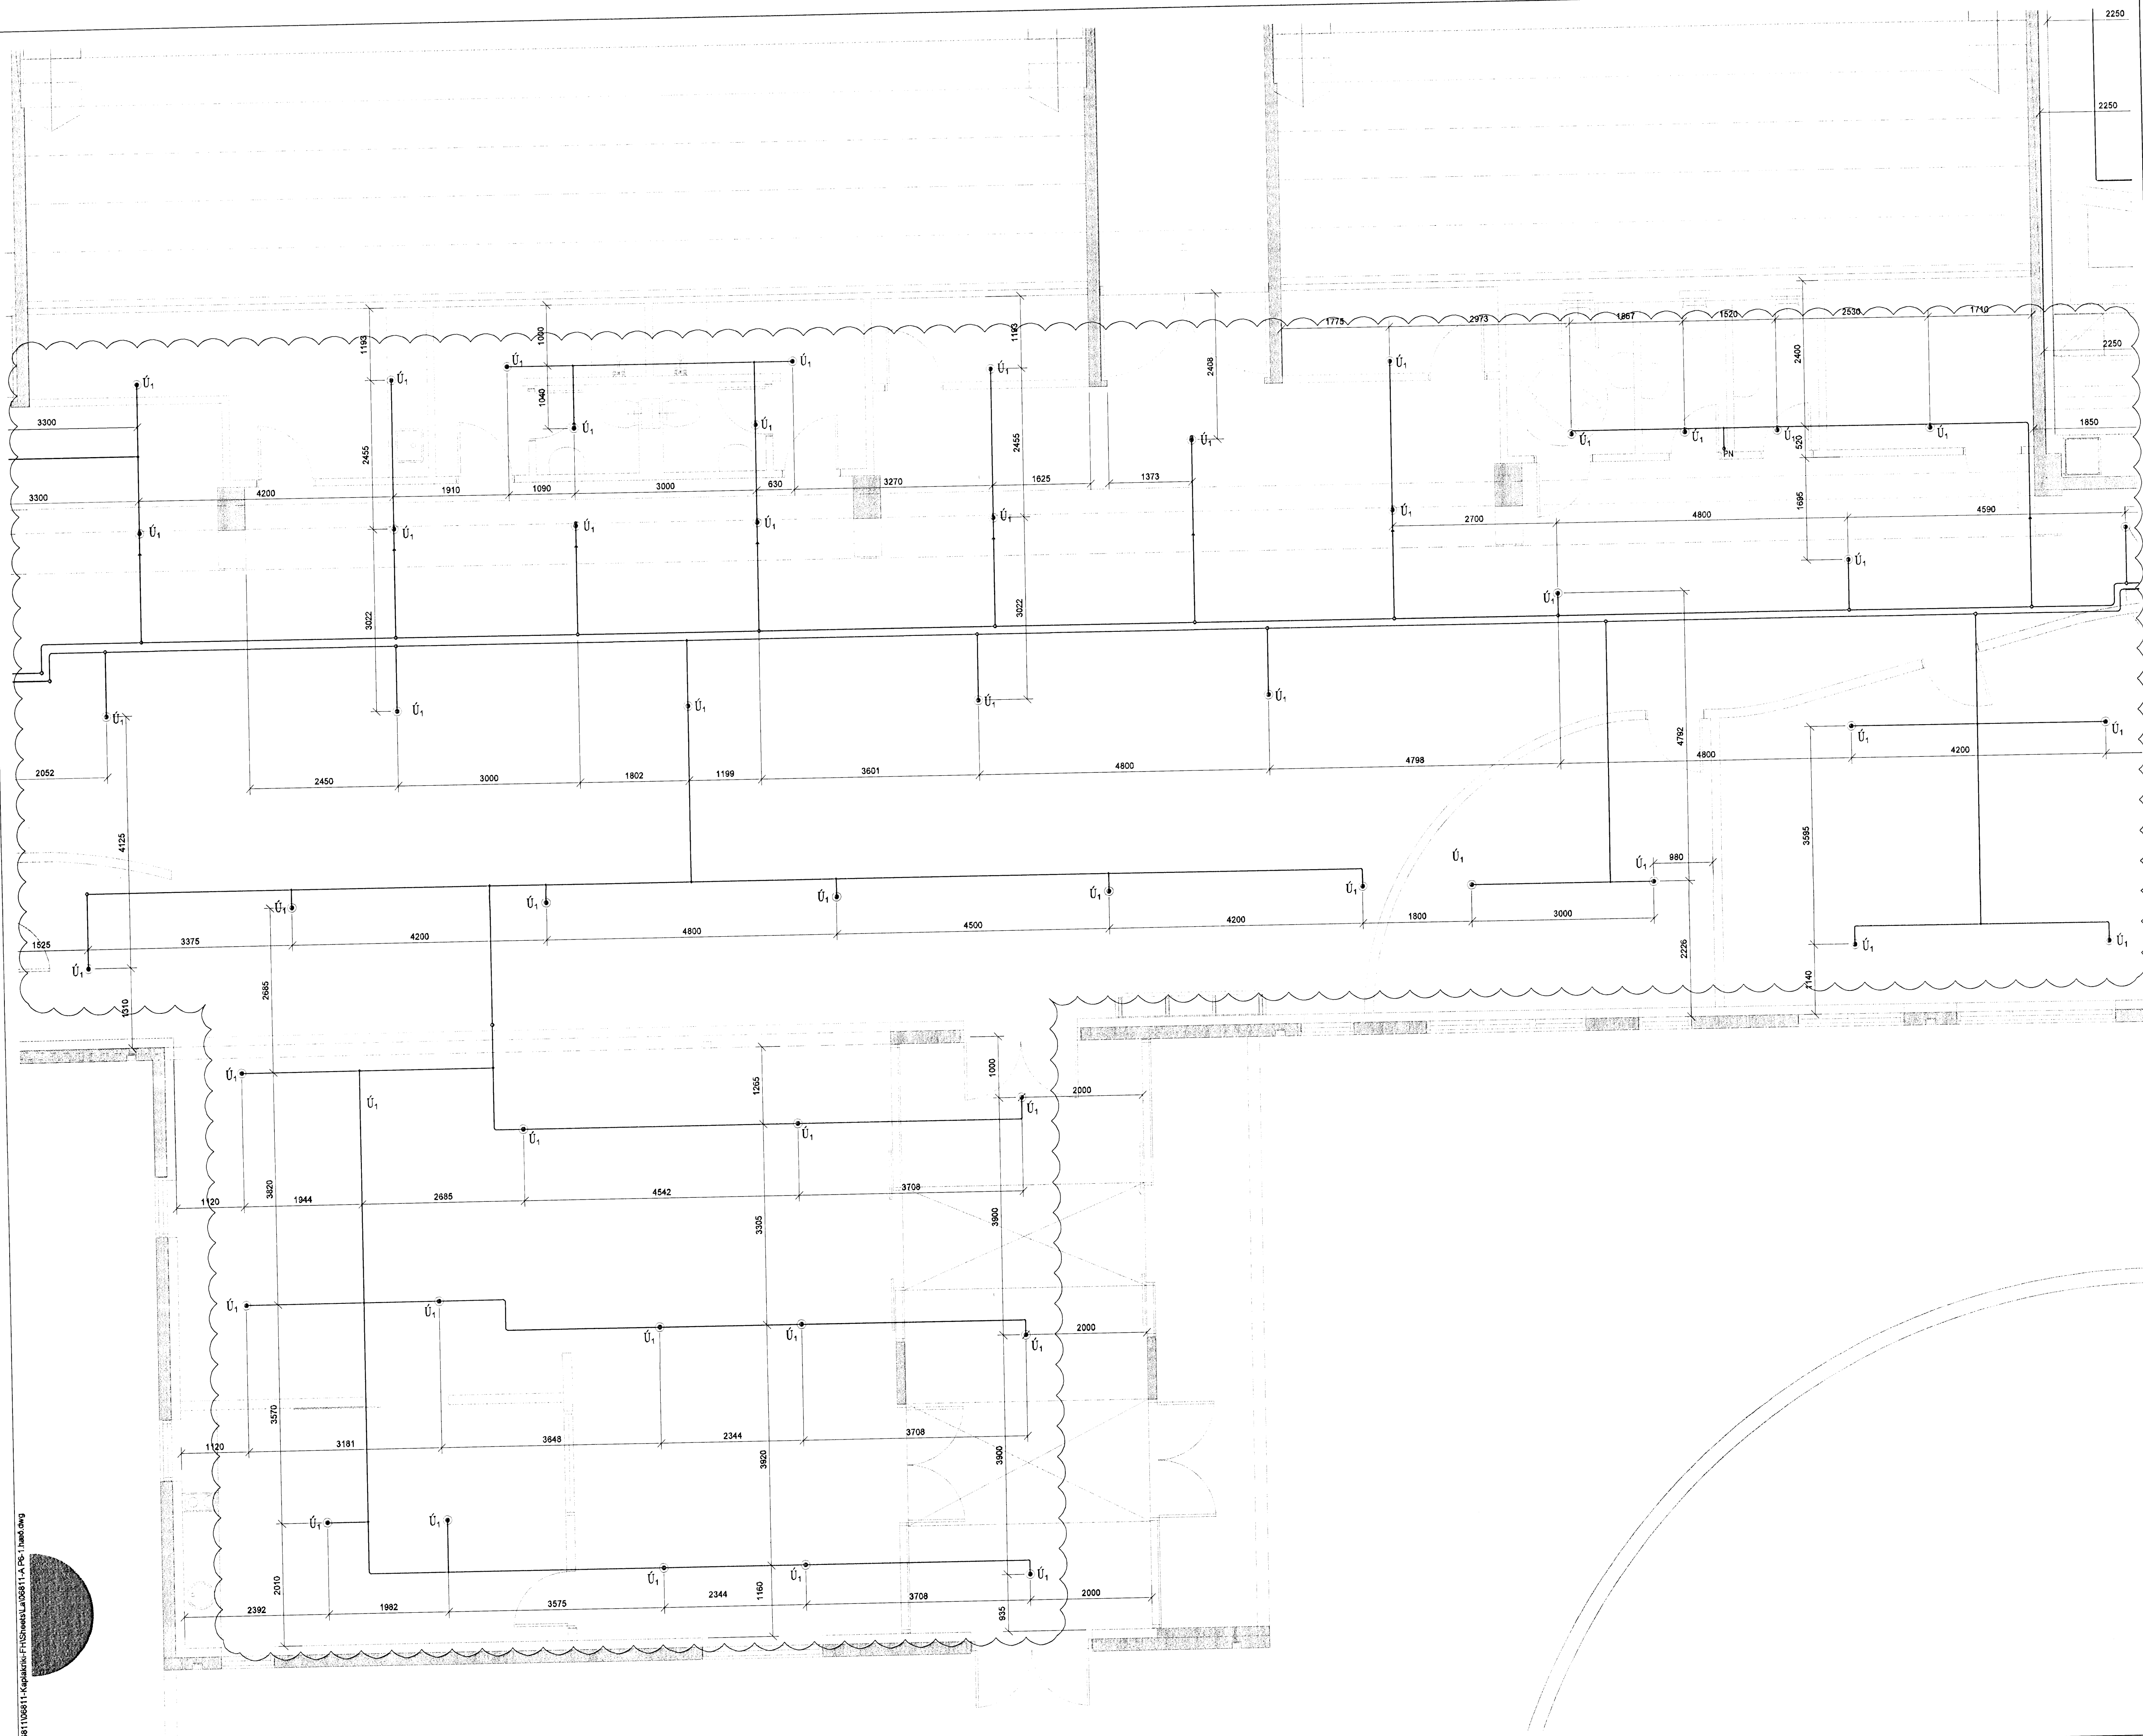
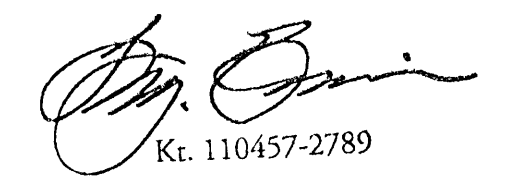

 F.h. Ljóður S. Gunnlaugsson


alt




 Kt. 110457-2789

BATTERIÐ
 HAFNARFIRÐI

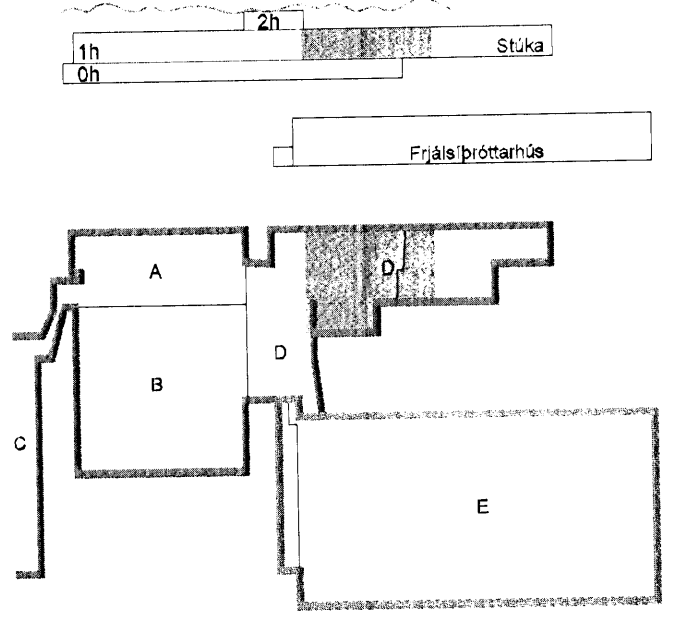KAPLAKRIKI



B. 11.07.08. Breyttar stærðir og lega lagna KMJ/SAS
 A. 23.11.07. Vertískning KMJ/SAS
 Dlg. Dags. Skýring Hannadýrfríland

VSB

VERKFRÆÐISTOFA

BÚEJARHRAUN 20 · 220 HAFNARFJÖRDUR · KENNIT. 710796-2899
 vsb@vsb.is · Sími 585 8600 · Fax 585 8610 · www.vsb.is

Ártun sérhönnuðar Sveinn Áki Sværissón Kt: 230855 5609
 Verkefni **KAPLAKRIKI HAFNARFIRÐI**

Verkefni				Lagnir	
Hannadýrfríland				Vatnsúðalagnir	
BS				Grunnmynd 1.hæðar	
Hannadýrfríland	Teiknað	Yfirfarð	SÁS	Kvarði	Síða
BS	BS	SÁS	1:50	/ A1	-
Dags.	Verkefni	Teikning		Útgáfa	
30.04.07	06811	A P613		B	

V:\2005\06811\06811-Kaplakriki-Firðir\06811-LA-PC-1\06811.dwg