
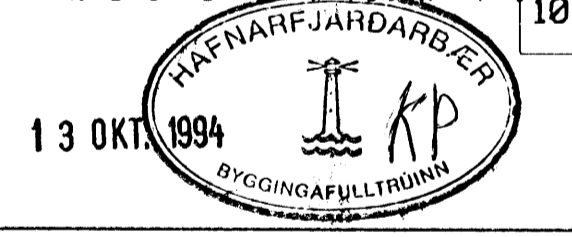
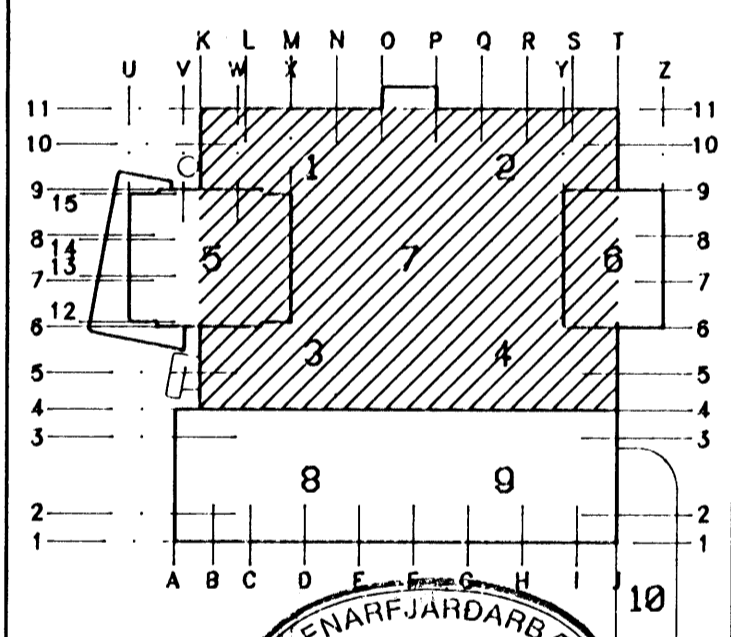


E	1	Nýjar tengingar við stofn 19.	19.09'94	04
D	4	Ný tenging og bréytt við stofn 17.	13.09'94	04
C	2	Stofni 17 og 18 bréytt.	21.08'94	04
B	4	Stofni 17 og 18 bréytt.	14.08'94	04
A	17	Stofni 17,18 og 19 bréytt.	24.04'94	04
NR FJÖLDI			BREYTINGAR	DAGS SAMP

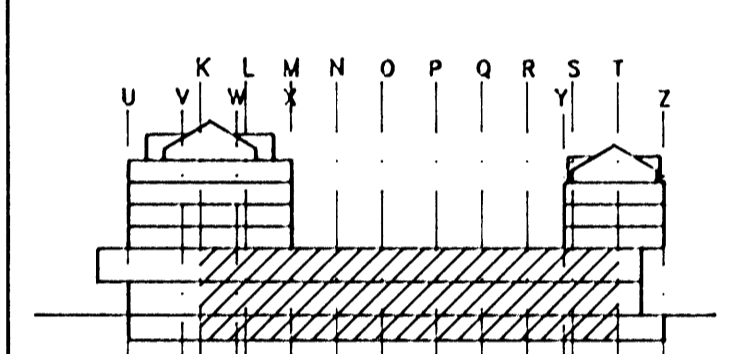

MIDBÆR
HAFNARFJARDAR
 FJARDARGATA 13-15

ALMENNA
VERKFRÆÐISTOFAN HF
 FELLSMÖLA 28 - 108 REYKJAVÍK
 Sími (01) 878100 FAX (01) 880284

FRÆNNISLAGNIR
 VESLANIR
 RÚMMYND 2

KAL: 1:50 / 1:20 / / / /

UNNAD: TEIKNAD: YFIRFARID: SAVD:

DAGS: 17/11 1993

TEIKNING NR: 1032-V-48 BREYTING NR: E

Skýringar
 Sjá skýringar fyrir frænnislagnum á teikningu nr. 1032-V-101.
 Sjá skýringar og tákni á teikningu nr. 1032-V-01.
 Sjá damigerðar sérmyndir á teikningu nr. 1032-V-03,
 og nr. 1032-V-04.

VM : Verkmörk
 FK : Kóti á frögengnu gólfi

