
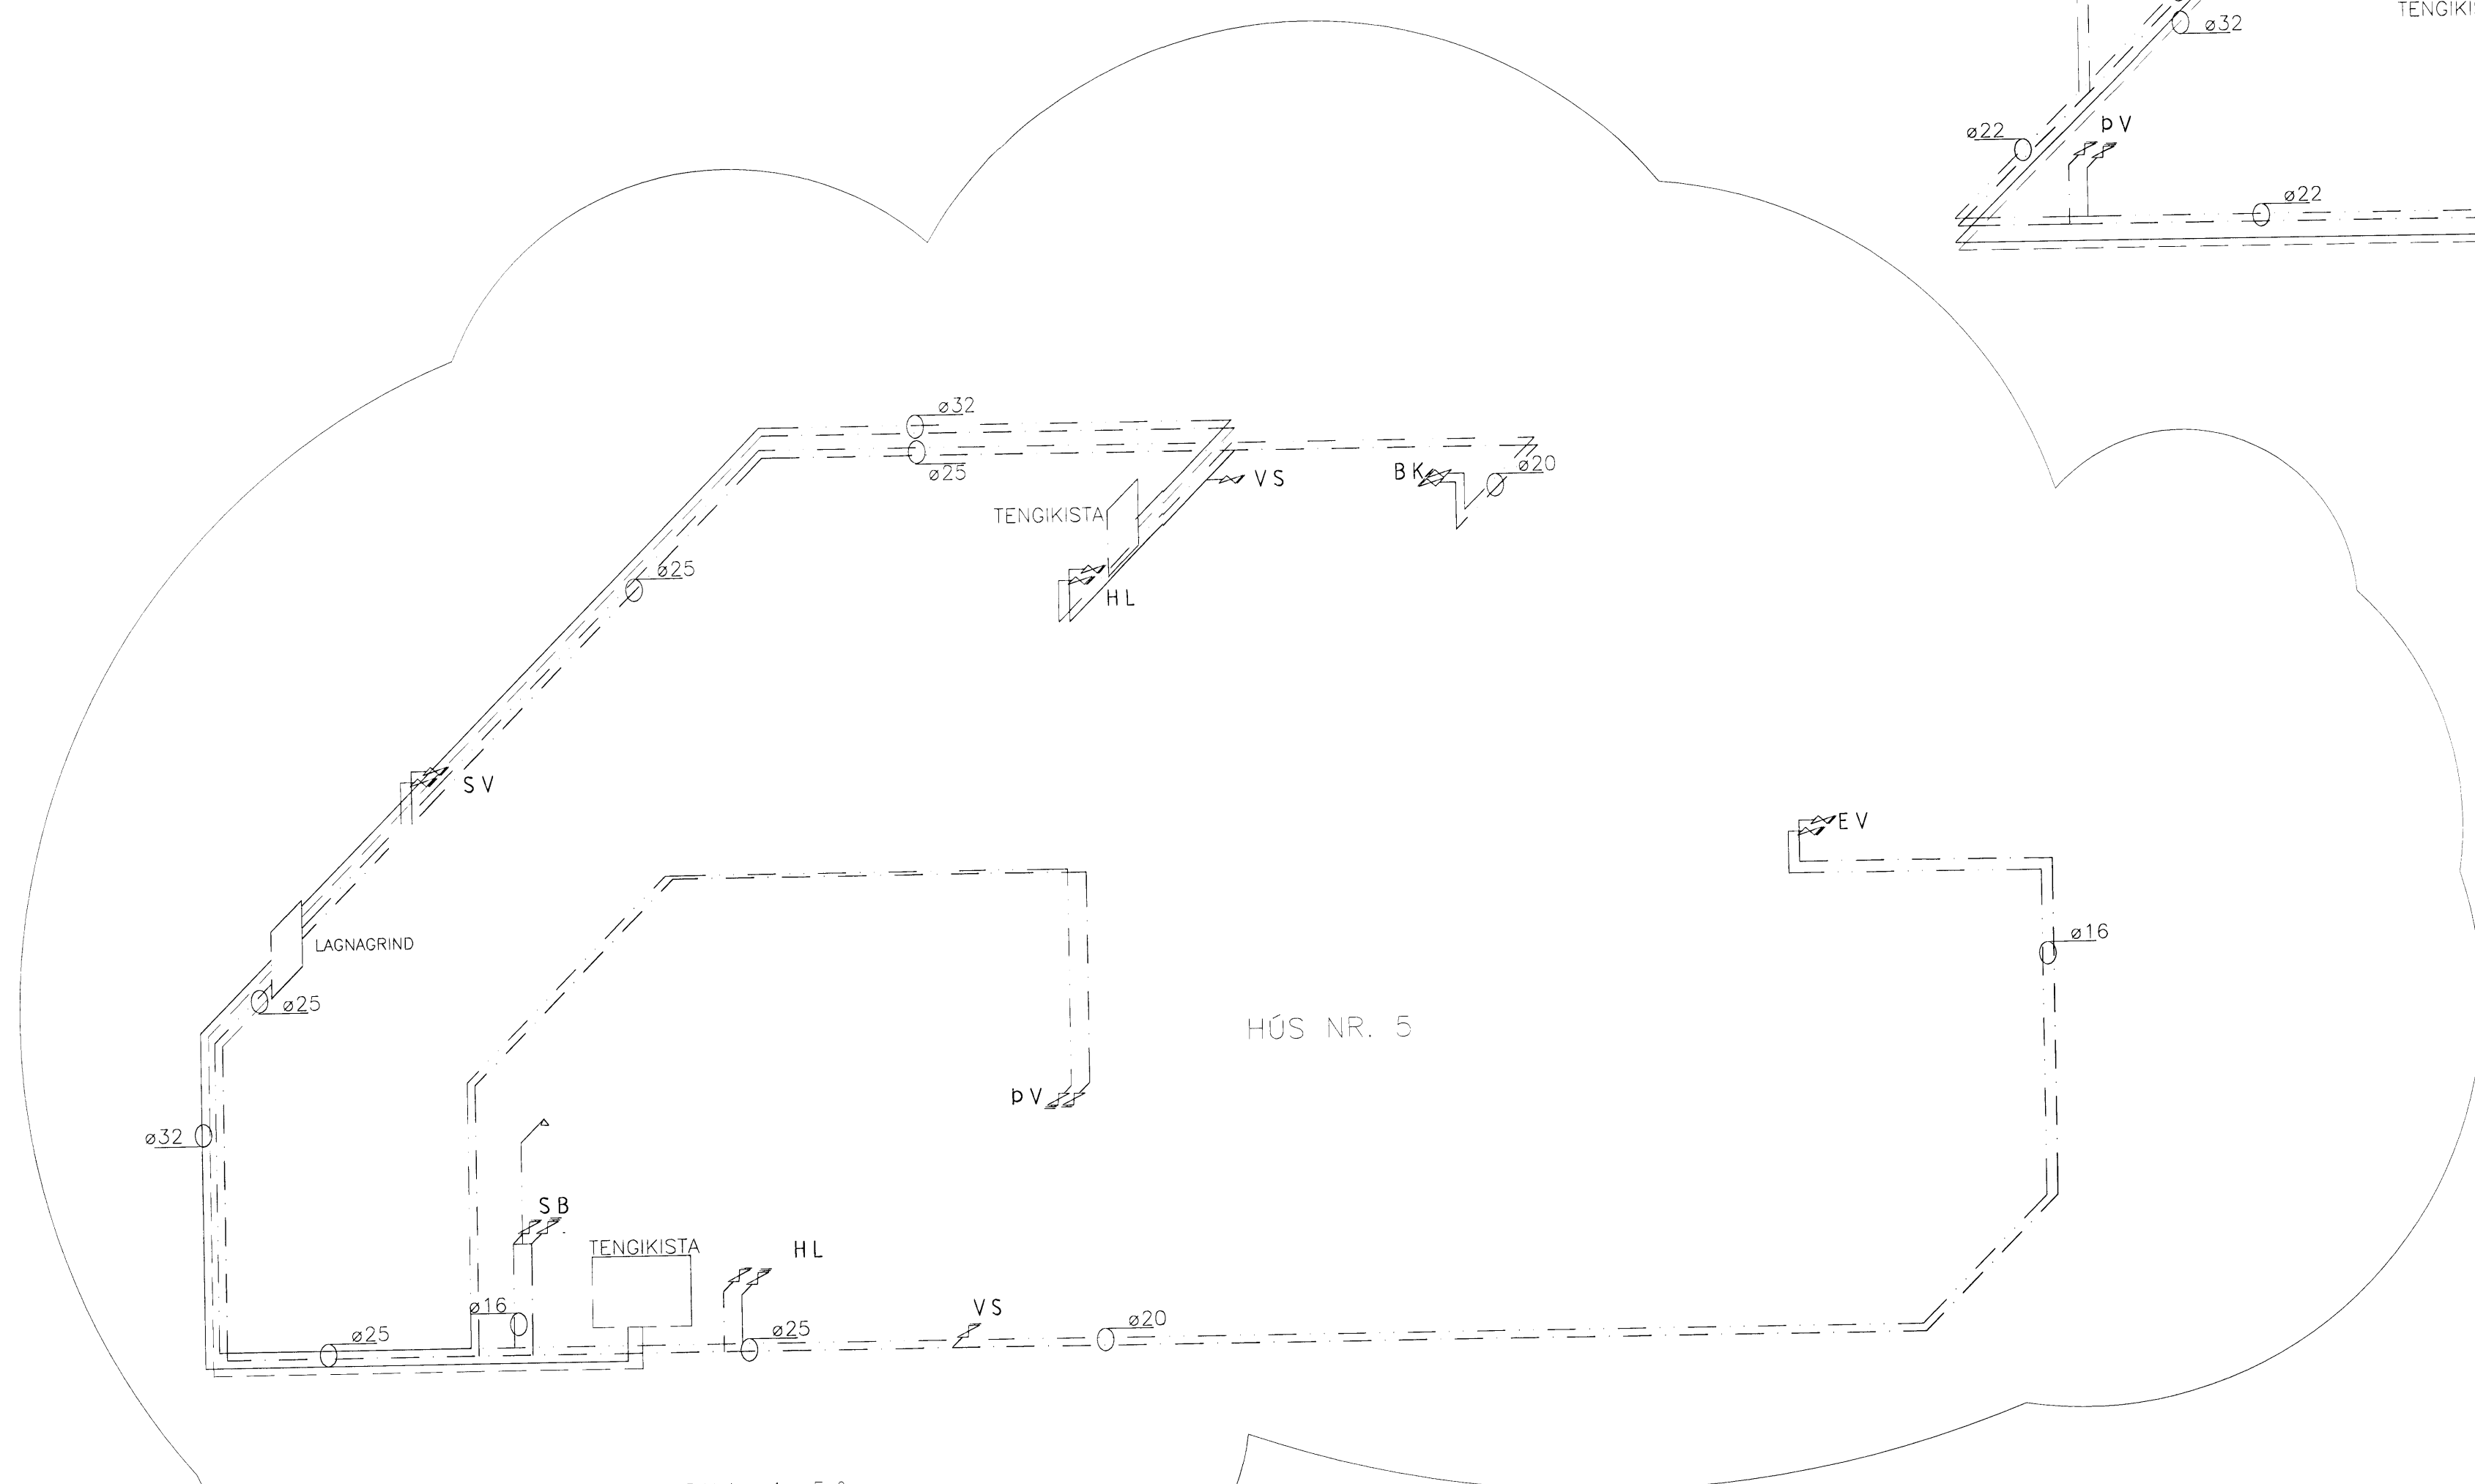


RÚMMYND NEYSLUVATNSLAGNA 1:50

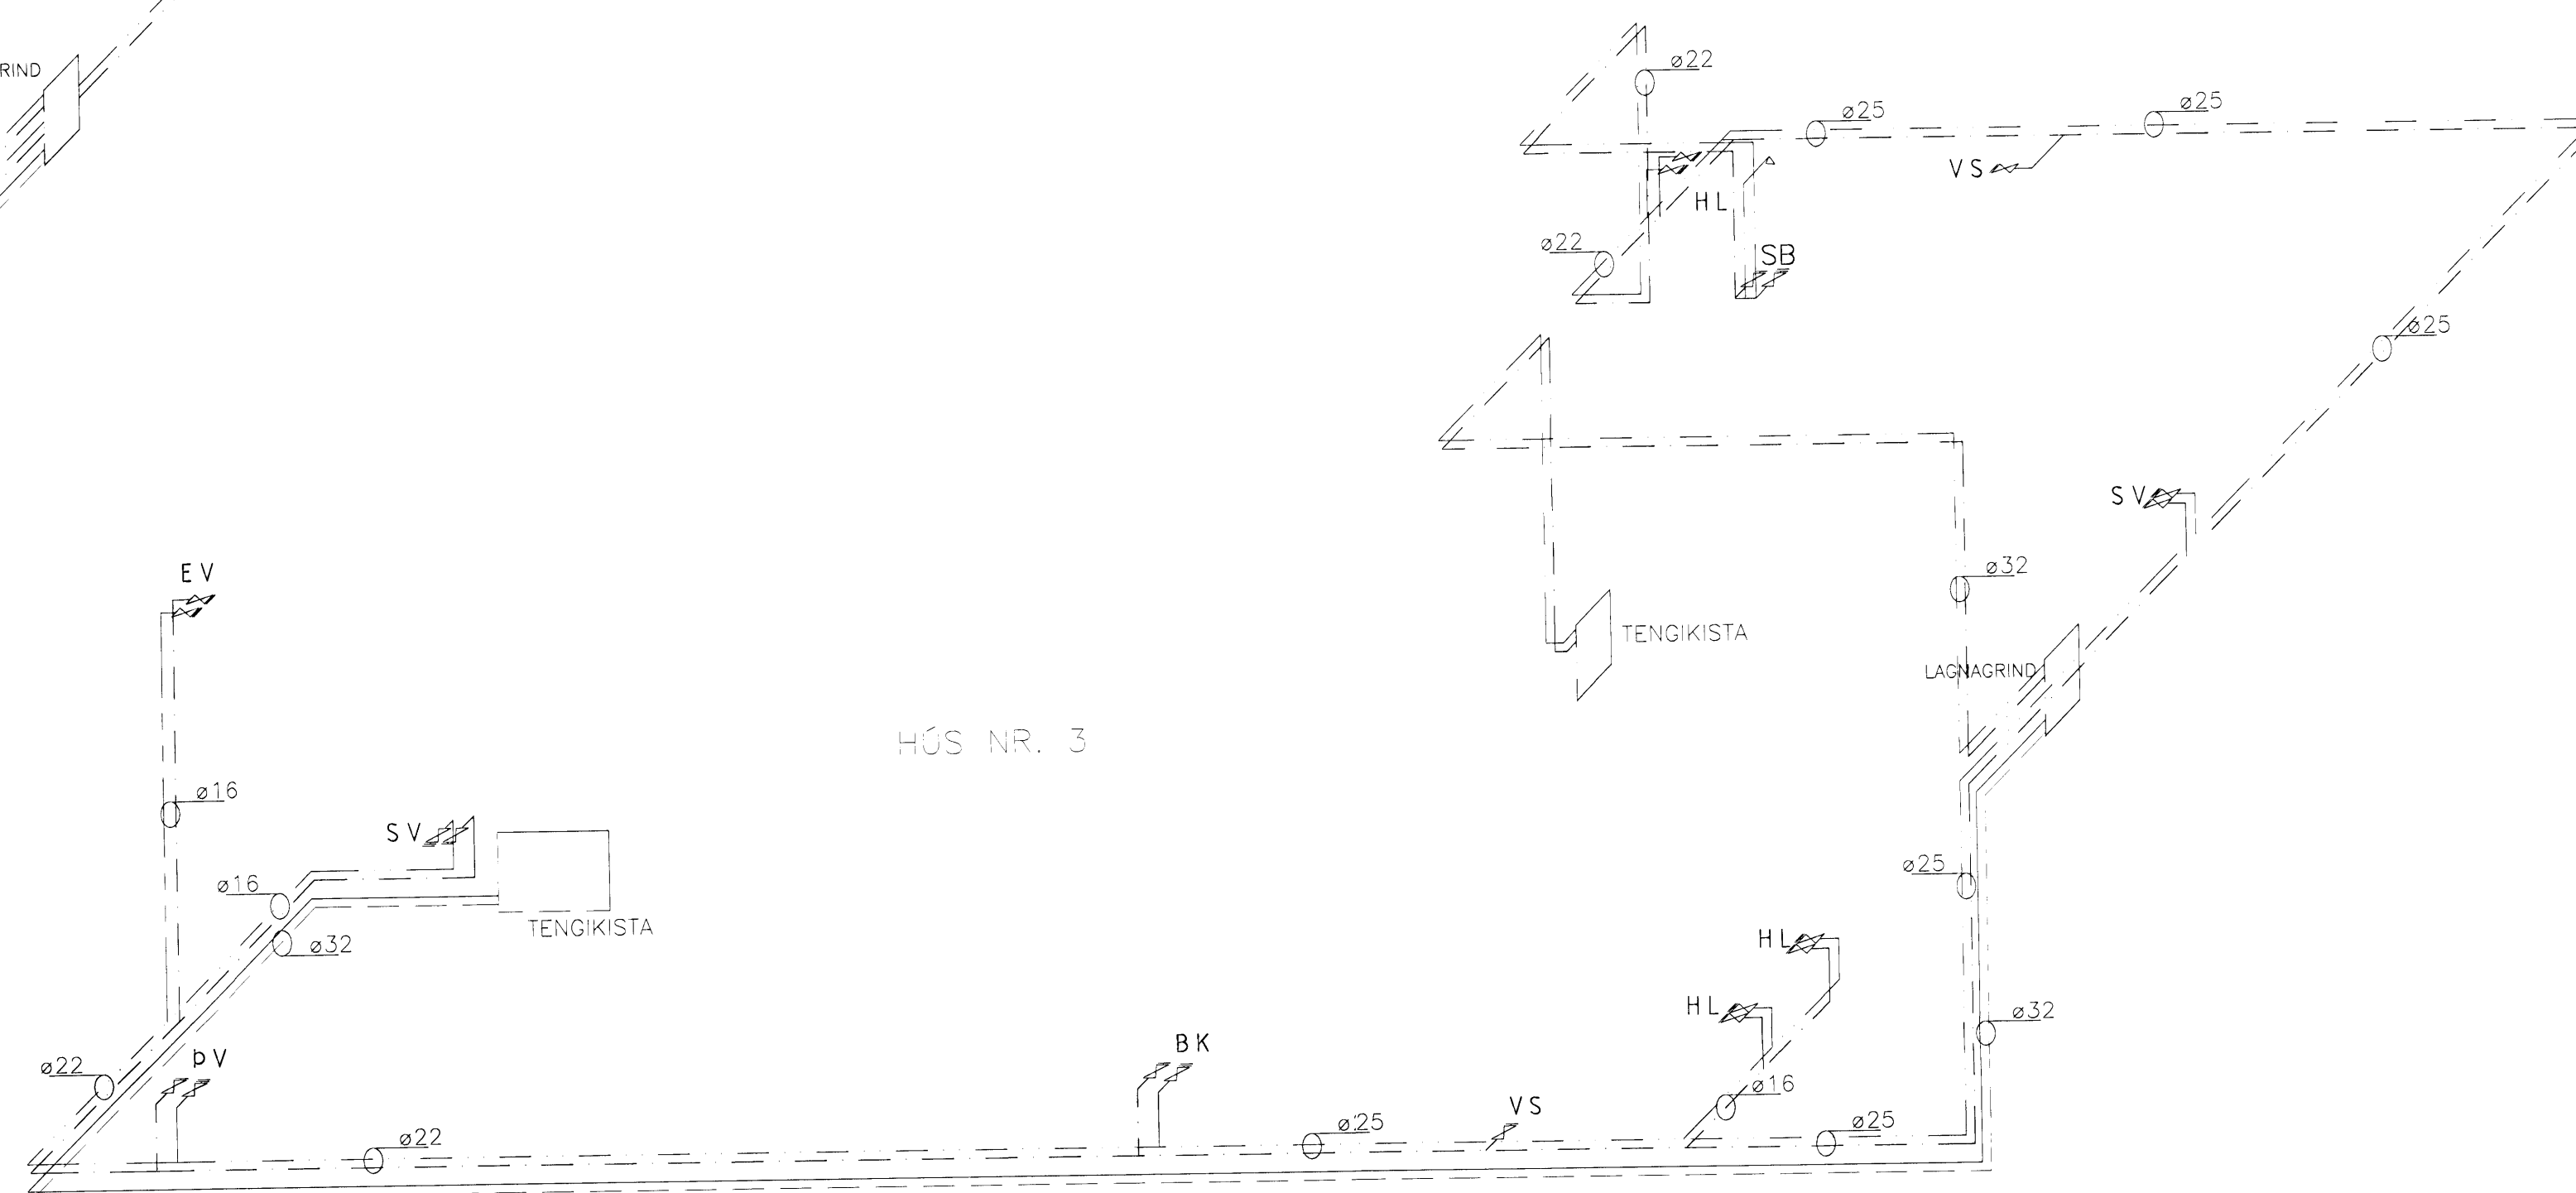

RÚMMYND NEYSLUVATNSLAGNA 1:50

Tilvísun: Helti teikningar:			
X			
8			
7			
6			
5			
4			
3			
2	6.6.08	V.J. V.J.	LÖGNUM Í HÚSI NR.5 BREYTT
1	6.3.08	V.J. V.J.	LÖGNUM Í HÚSI NR.1 BREYTT
Br.	Dags.:	Af. Sam.	Breyting:
<i>Margrjet Lauraco 60572-5769</i>			
Vignir Jónsson Byggingatæknifræðingur Skipasundi 47 104-Reykjavík Sími: 564-0224 e-mail: vignir1@solark.is			
HLÍÐARÁS 1-5			
HAFNAFJÖRÐUR			
LAGNIR			
RÚMMYND NEYSLUVATNSLAGNA			
VERK NR.	004	KVARDI	
TEIKN NR	0025	1:50	BL NR P8
ÚTVEF V.J.	ÚTVEF V.J.	ÚTVEF V.J.	ÚTVEF V.J.
27.07.2007			<i>Vignir Jónsson</i>
020561-4759			