



Samþykkt bann

22 DEC 2008

Byggingafulltrúinn í Hafnarfirði
F.h. Hrölfur S. Gunnlaugsson

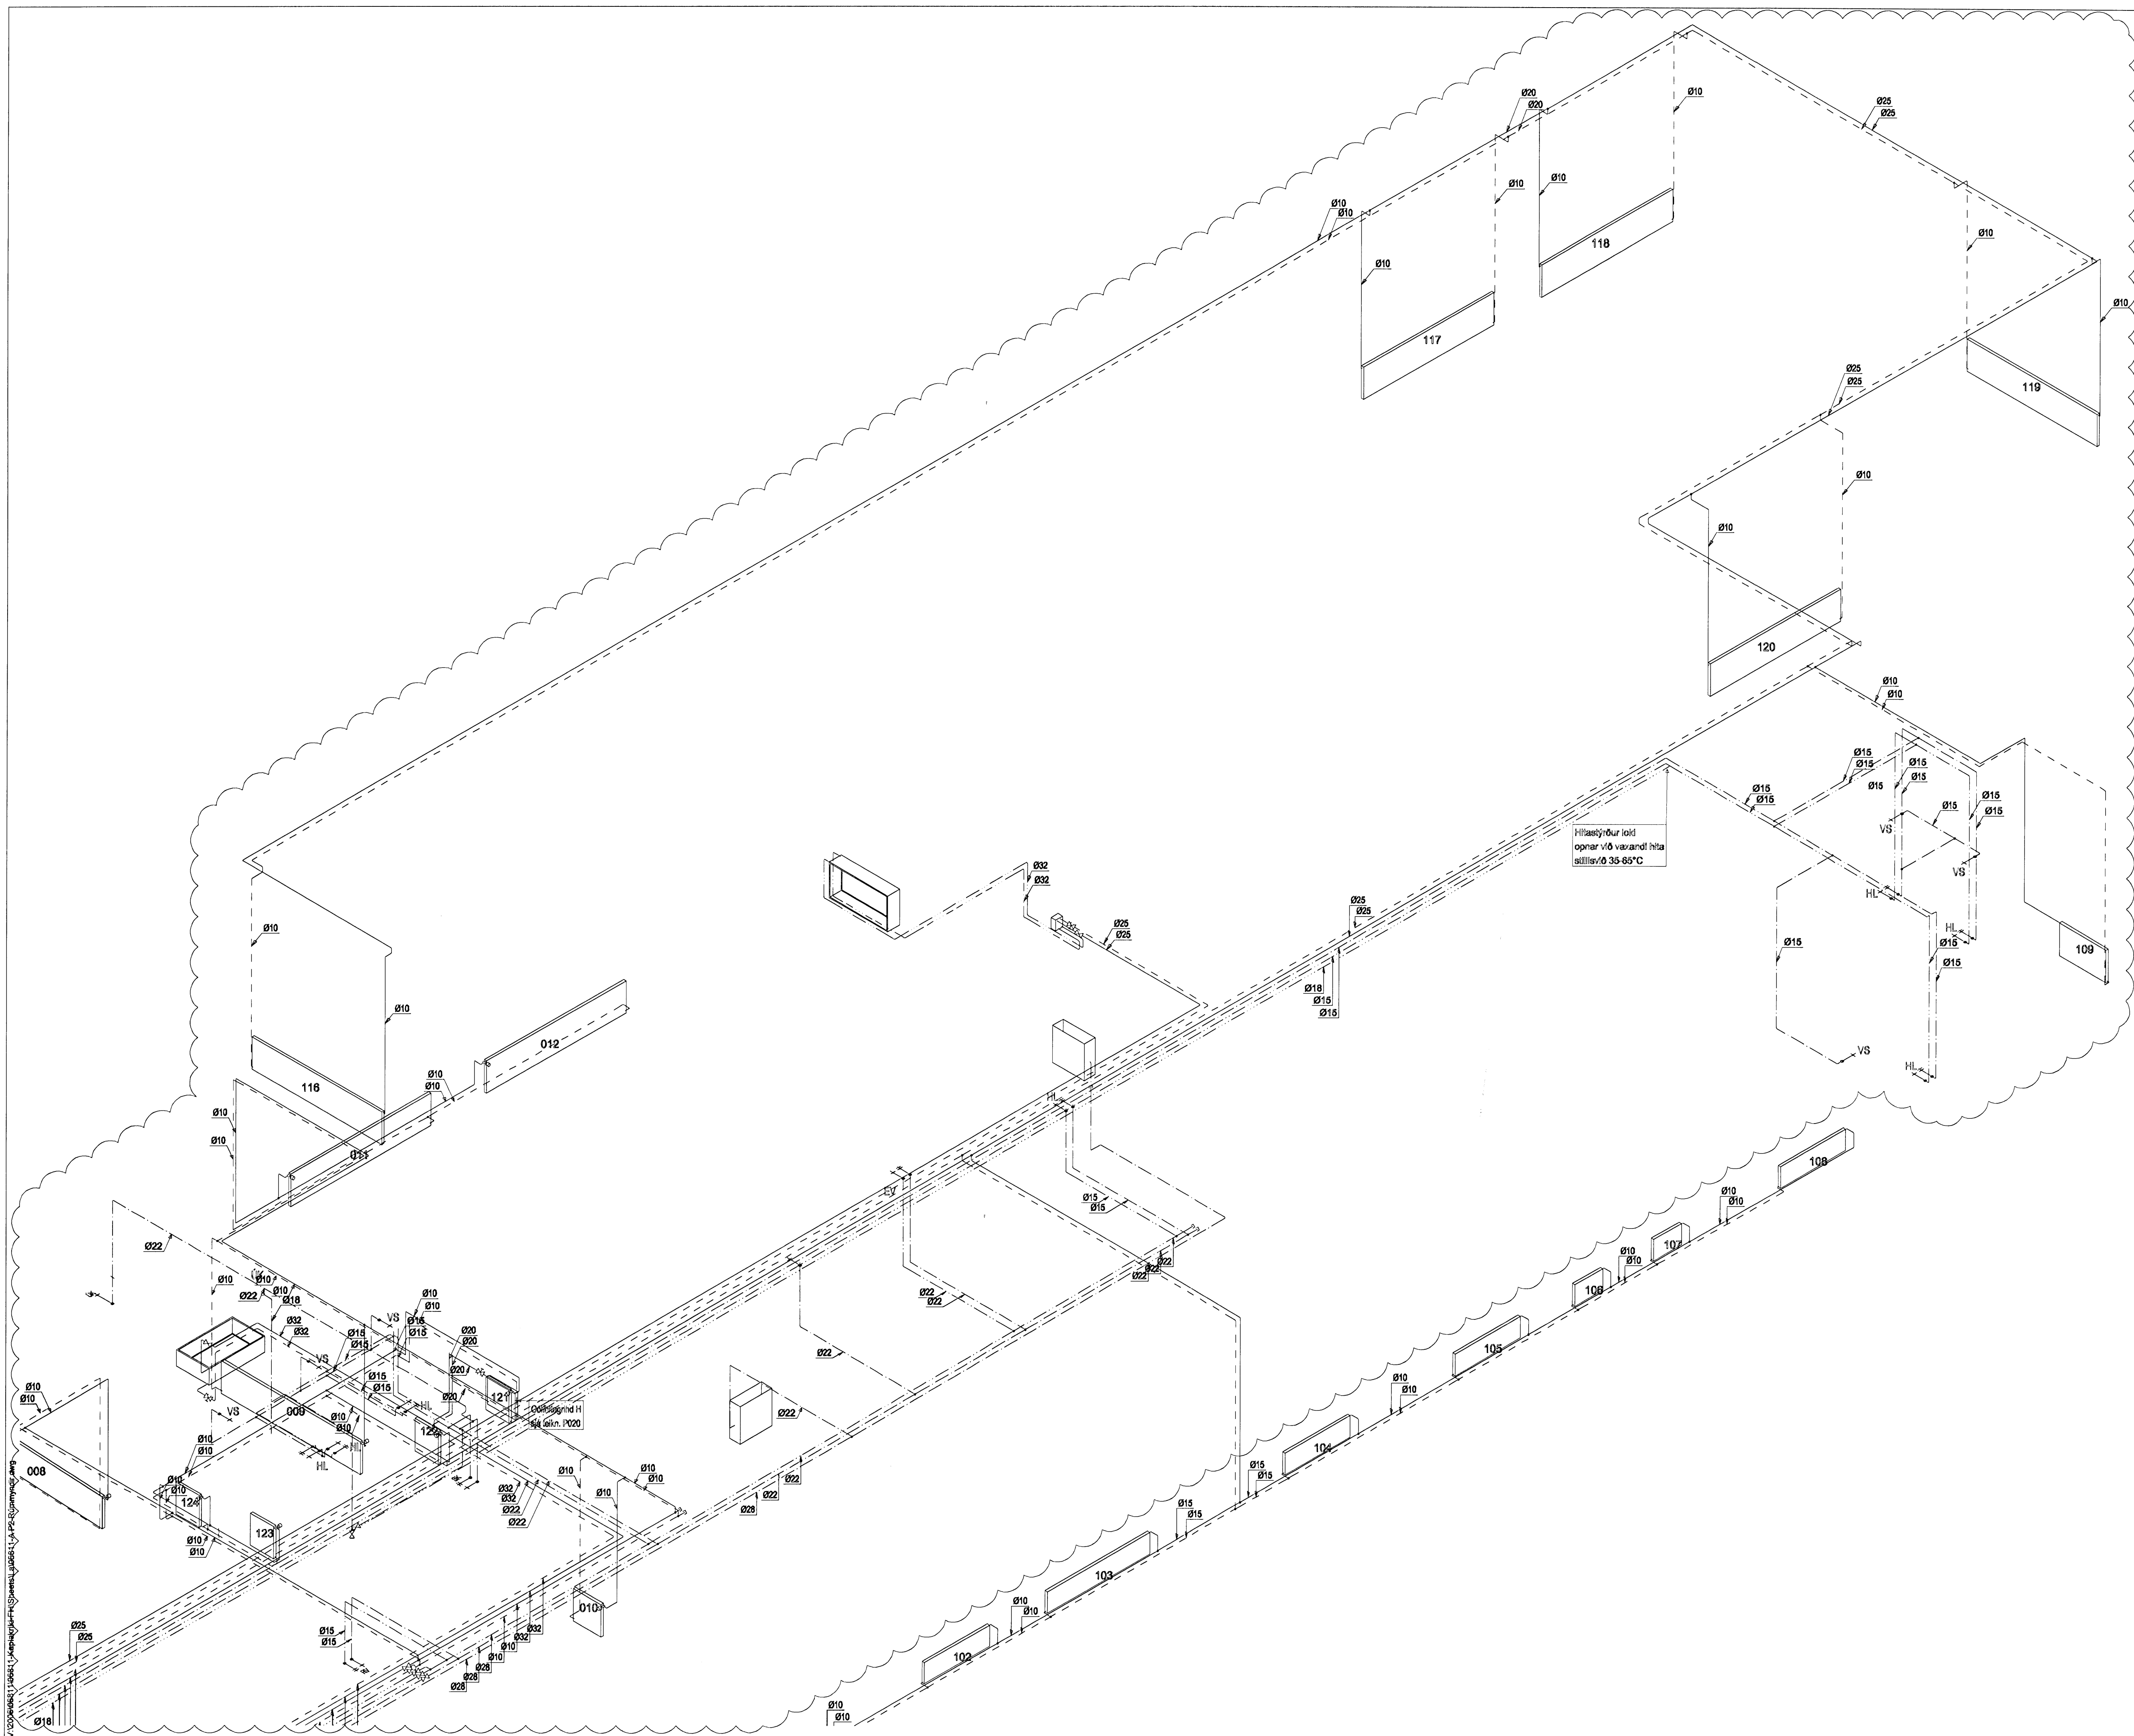

KAPLAKRIKI

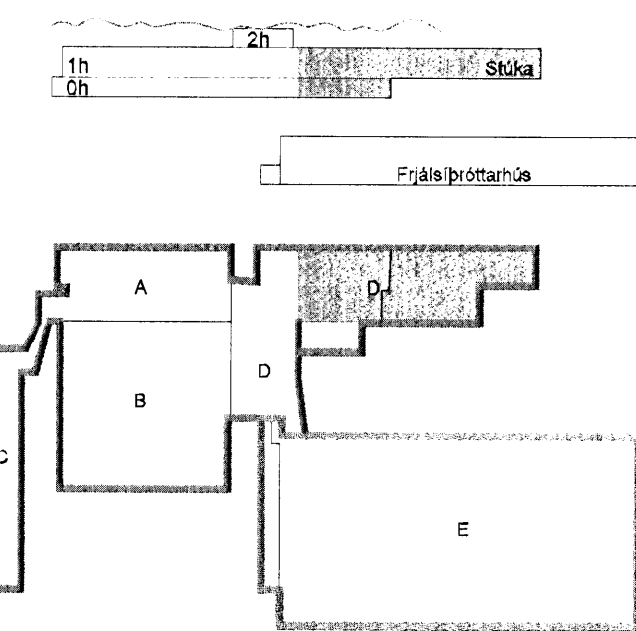

E	09.12.08	Breyting öna og lagna	KMJSAS
D	03.11.08	Breytt laga lagna	KMJSAS
C	07.07.08	Breyting á öllum neyslúvatns- og hitalagnum	KMJSAS
B	03.03.08	Öfnum bætt á teikningu	BS / SAS
A	23.11.07	Verkefning	KMJSAS
Útg.	Dags.	Skýring	Hannad/Yfirfarad



VERKFRÆÐISTOFA

BÆJARHRAUN 20 • 220 HAFNARJÖRÐUR • KENNIT. 710796-2899
vsb@vsb.is • Sími 595 8600 • Fax 585 8610 • www.vsb.is

Aritun sérhönnuðar Sveinn Aki Sverrisson Kt. 230855-5800			
Verkefni: KAPLAKRIKI HAFNARFIRÐI			
Verkefni: Lagnir Neyslúvatns- og hitalagnir Rúmmynd			
Hannad	Teiknað	Yfirfarad	Kvarði
BS	BS	SAS	/ A1
Dags:	Verkefni	Teikning	Útgáfa
16.10.2007	06811	A P294	E