


5.65
G = 5.58

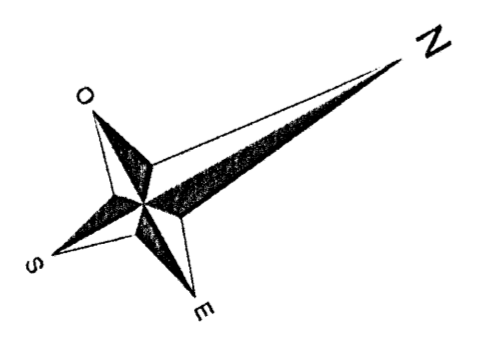

DAGS	Breytingar
09.2006	Sútnavegg málsstafta 72, 73, 74, 15 og geymslur 15A-16 og gólfniðurtöl
19.05.2008	Húðbrotabaki
19.06.2008	<i>[Signature]</i>

