


L = 5.2

L = 6.00

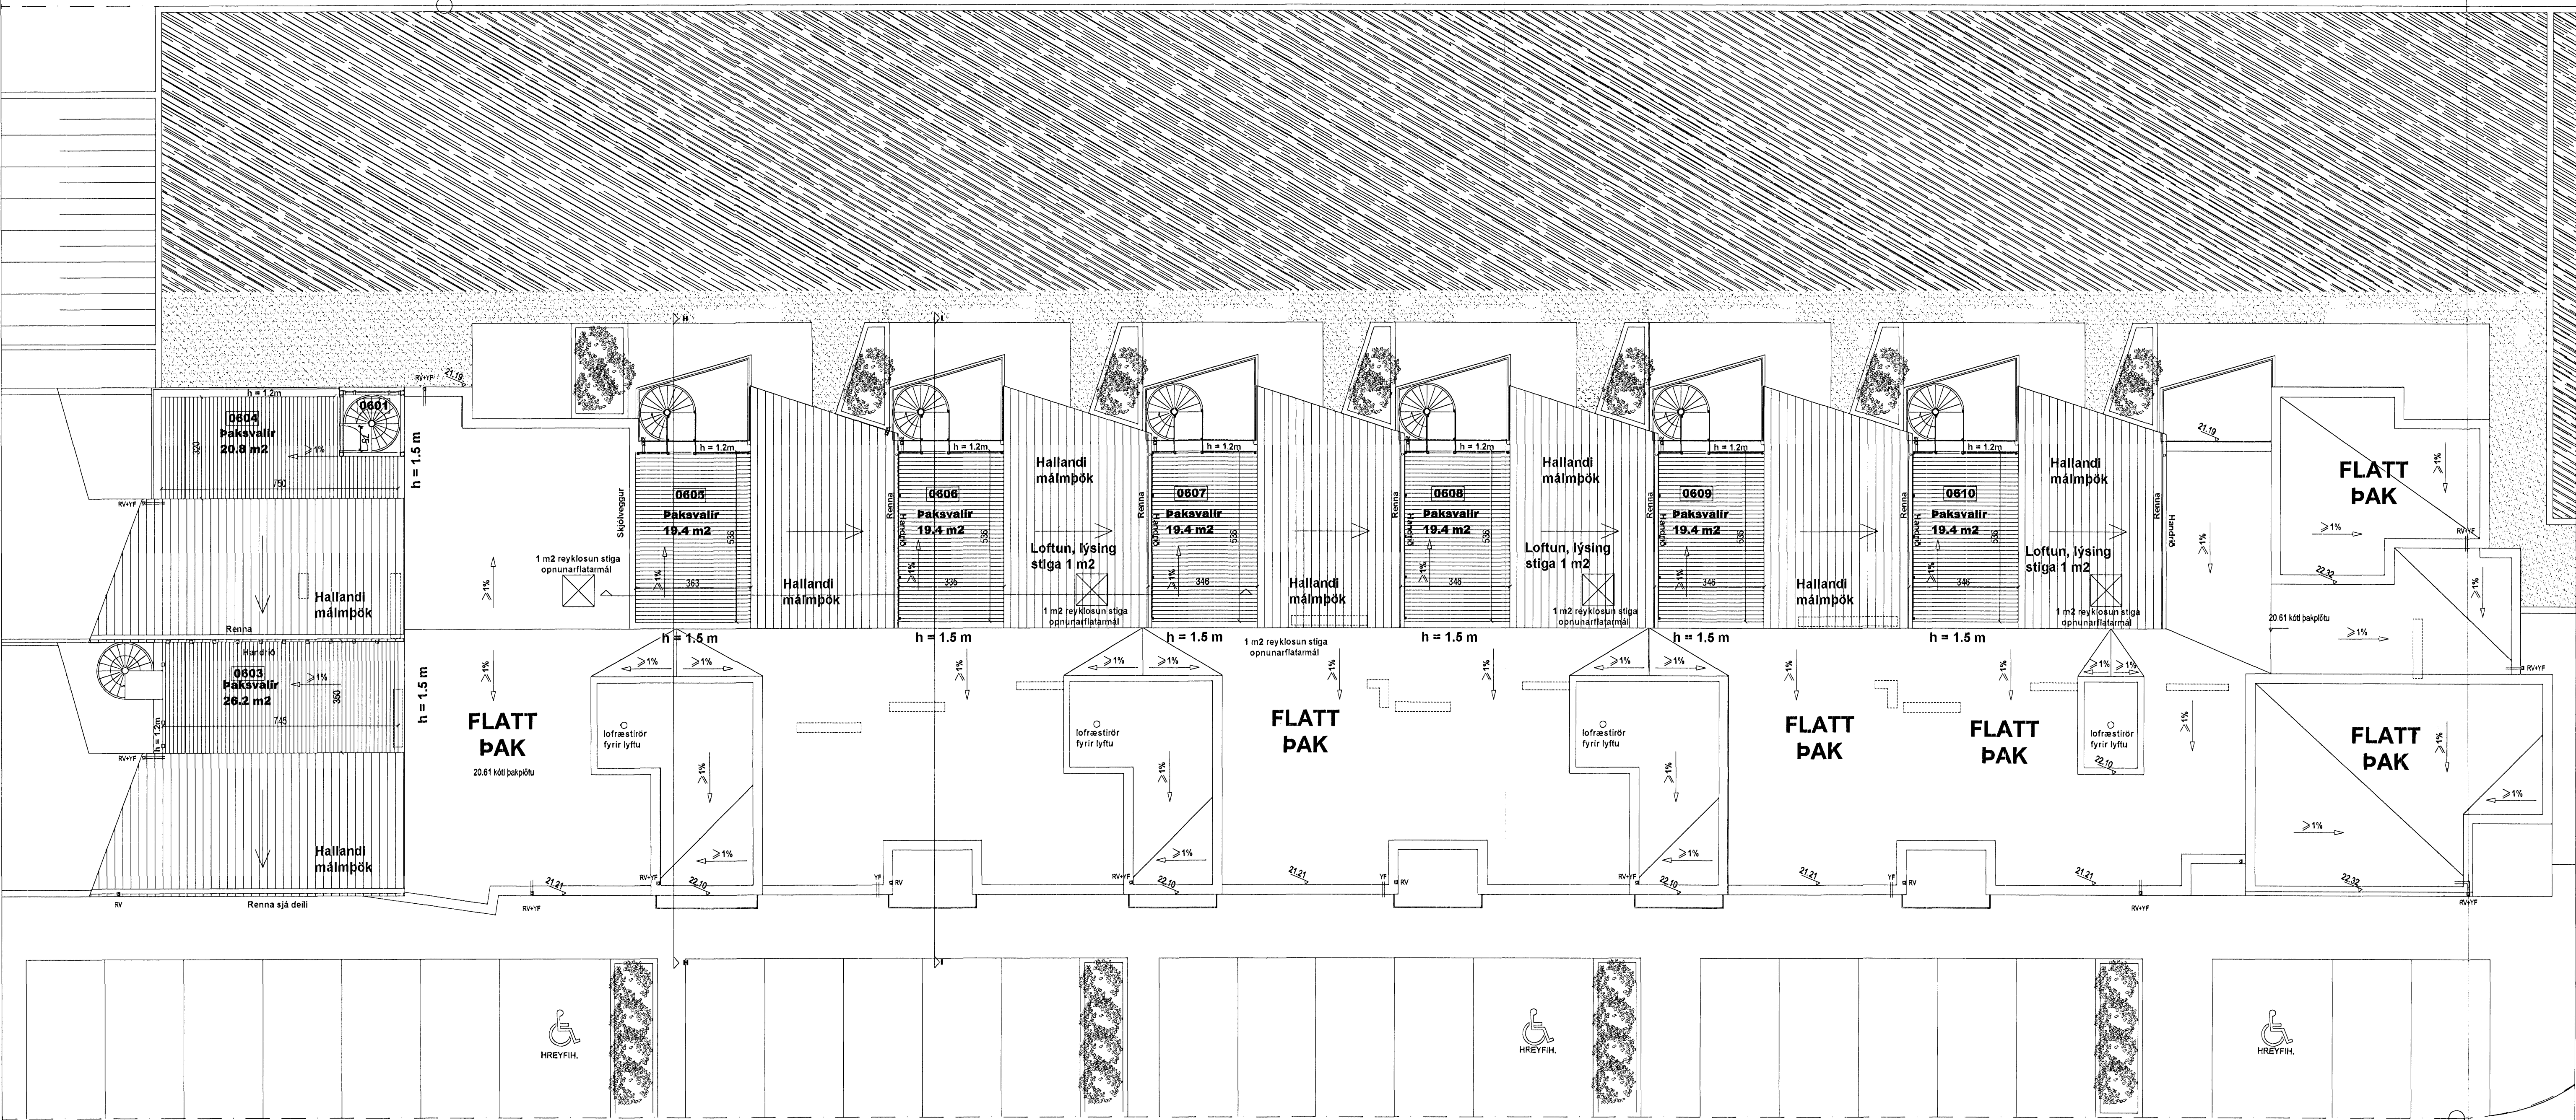

L = 4.80

L = 5.18

L = 5.27

DAGS	Breytingar
09.2006	Útseta subaunandi Vatnhallir, Nórúðil, Stigi 106.04
19.05.2008	Lofræstirör fyrir lyftu <i>Blaup</i>