


GRUNNMYND KJALLARA A-ÁLMA  
 1:100

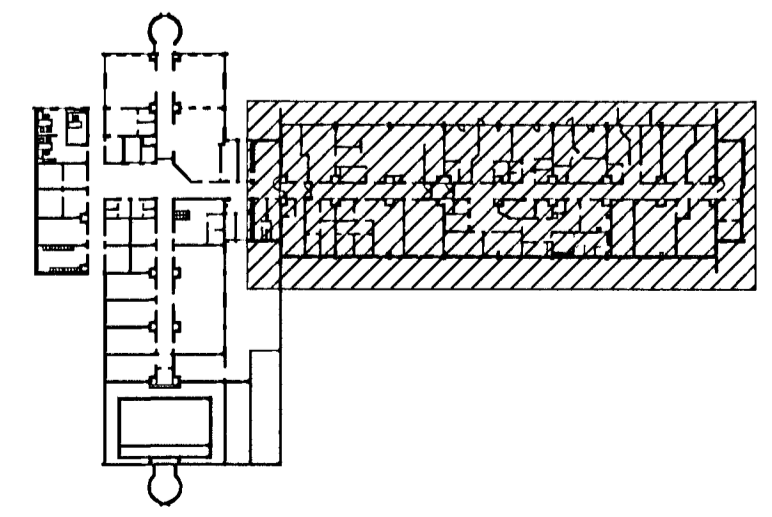

breytingar

Hrafnista Hafnarfrófi  
 Hraunvangi 7  
 Gunnmynd jarðhæðar  
 A-álma breytt skráning

31.12.2008 1:100  
 dags. mál. breyting 05-00-A  
 tek.

TEKNIÞÓFA HALLODRB GUÐMUNDSSONAR FAJ  
 PÓSKAFEN 9 • 103 REKJAVÍK • Sími: 545 1800  
 FAKI: 545 1810 THB@THB.IS WWW.THB.IS