


Matshluti 1

Matshluti 1

GRUNNMYND 4.HÆÐAR A-ÁLMA  
 1:100

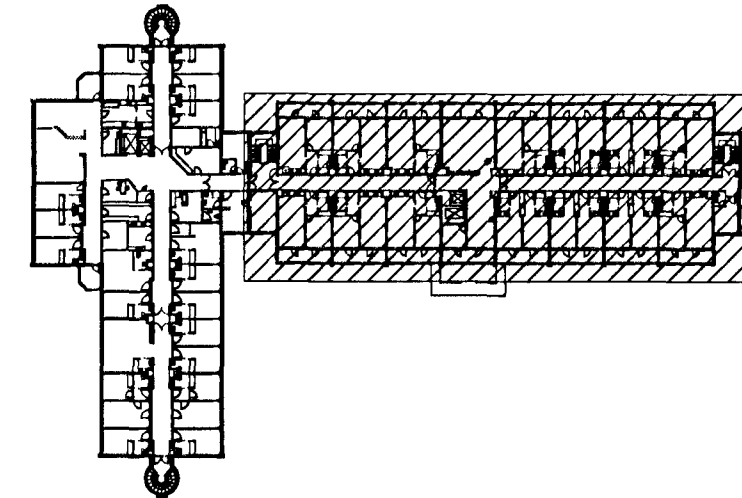

breytingar

Hrafnista Hafnarfirði  
 Hraunvangi 7  
 Gunmynd 4.hæðar  
 A-álma breytt skráning

31.12.2008 1:100  
 dag mál breyting tekm. 05-04-A

TEKNISTOFA HALDÓRS GUÐMUNDSSONAR FAI  
 FAXAFEN 9 • 105 REYKJAVÍK • Sími: 545 1600  
 FAX: 545 1610 THO@THO.IS WWW.THG.IS