


GRUNNMYND KJALLARA B-ÁLMA
 1:100

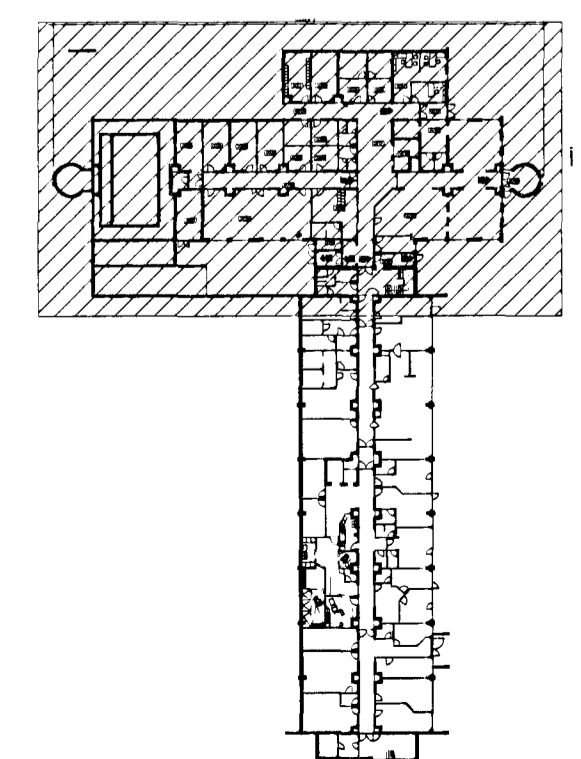

breytingar

Hrafnista Hafnarfróði
 Hraunvangi 7
 Gunnumynd jarðhæðar
 B-álma - Breytt skráning

31.12.2008 1:100
 0923
 breyting 05-00-B
 íbú.

THG ARCHITECTAR
 FAXAFEN 9 - 105 REYKJAVÍK - Sími: 545 1500
 FAX: 545 1515 THG@THG.IS WWW.THG.IS