
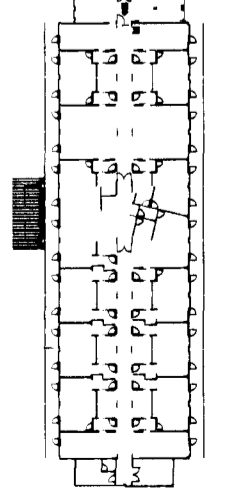


GRUNNMYND 2. HÆÐ B-ÁLMA  
 1:100

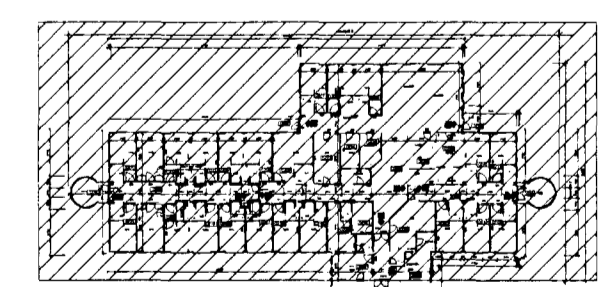

breytingar

Hrafnista Hafnarfirði  
 Hraunvangi 7  
 Gunnmynd 2. hæð  
 B-álma - Breytt skráning

31.12.2008 1:100  
 dagi  
 140713-256

breyting 05-02-B  
 tekn.

THIS ARCHITECTAR  
 FAKAFENI 9 · 105 REYKJAVÍK · Sími: 545 1600  
 Faxi: 545 1616 THS@THS.IS WWW.THIS.IS

