


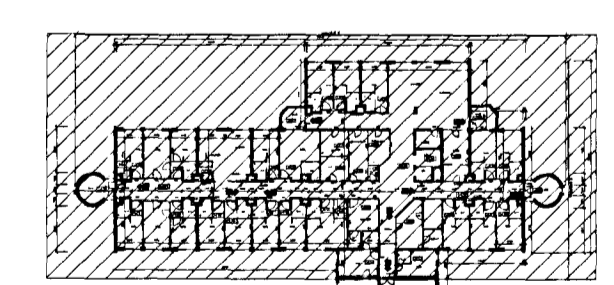

GRUNNMYND 4. HÆÐ B-HÆÐ  
 1:100



breytingar

Hrafnista Hafnarfrói  
 Hraunvangi 7  
 Gunnmynd 4. hæð  
 B-álmá - Breytt skráning

31.12.2008 1:100  
 dags. mál. breyting 05-04-B  
 tek.

*Stall*

KT-14073-250

THÖ ARCHITEKTAR  
 PÁKKAFA 9 - 103 REYKJAVÍK - Sími: 545 1600  
 FAX: 545 1610 THÖ@THÖ.IS WWW.THÖ.IS

