


ÓTGÁFUFRILL			
ÓTGÁFA:	DAGS:	SKYRINGAR:	BR. AF SAMP:
	Okt. 08	Reyndarteikningar	
DAGS. UNDIRSKRIFTAR: NAFN OG KT. SAMRÆMINGARHÖNNUÐAR:			
UNDIRSKRIFT SAMRÆMINGARHÖNNUÐAR: <i>[Signature]</i>			

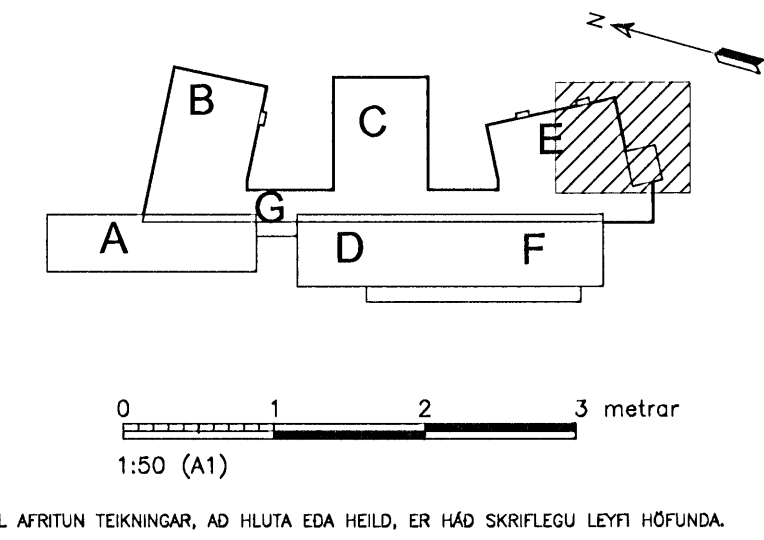

**Verkfræðistofa**  
**Jóhannas Indriássonar ehf**  
 Síðumúli 1, 108 Reykjavík  
 Sími 568 7319, Fax 568 6687, Netfang vj@vj.is, Veffang www.vj.is

HEITI VERKS:  
**HRAUNVALLASKÓLI**  
**DREKAVÖLLUM 9**  
**HAFNARFIRÐI**

HEITI TEIKNINGAR:  
**RAFLAGNIR** LÁGSPENNUTEIKNINGAR  
**TENGLAÖGN 3. OG 4. HÆÐ**  
**2.-3. ÁFANGI**

MKY: 1:50 A1	VERKNR: 5401	SKRÁNINGARNR: ODNS	ÓTGÁFA: Reynd.t.
1:100 A3	TEKNAD: IM	YERIFRARI: MK	
NAFN OG KT. SAMRÆMINGARHÖNNUÐAR: MAGNÚS KRISTBERGSSON 080257 3689			NR. TEIKNINGAR: E3-310
DAGS. UNDIRSKRIFTAR: <i>[Signature]</i>			BLAÐNÖMUR: 186