
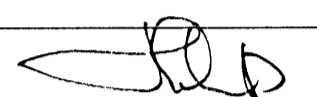


ÓTGÁFUERILL			
ÓTGÁFA:	DAGS:	SKYRINGAR:	BR. AF SAMD:
OKT.08		REYNDARTEIKNING	
DAGS. UNDIRSKRIFTAR: NAFN OG KT. SAMRÆMINGARIÖNNUDAR:			
UNDIRSKRIFT SAMRÆMINGARIÖNNUDAR: 			

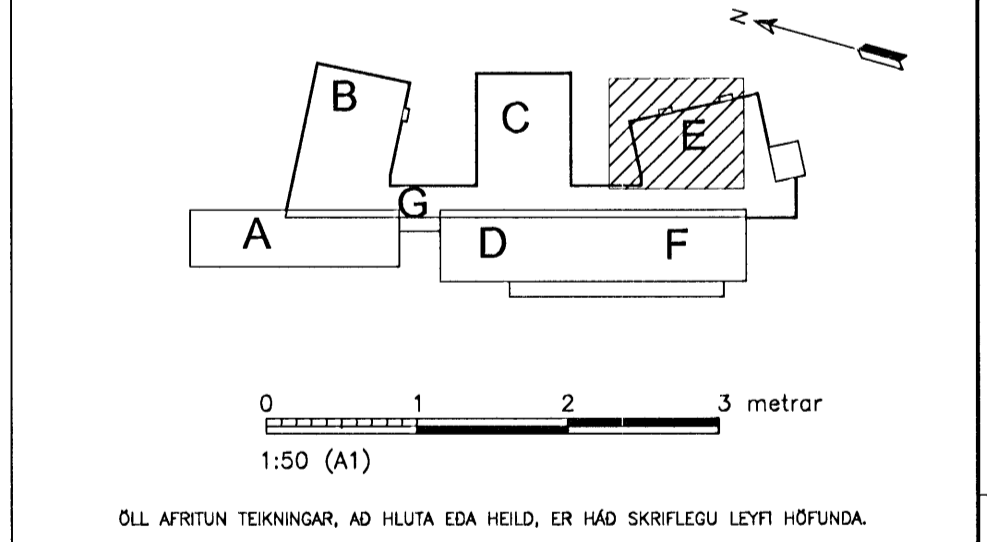

ÖLL AFRITUN TEIKNINGAR, AD HILUTA EDA HEILD, ER HÁÐ SKRIFLEGU LEYFTI HÖFUÐA.


Verkfræðistofa
Jóhanns Indriássonar ehf
 Síðumúli 1, 108 Reykjavík
 Sími 568 7319, Fax 568 8887, Netfang vj@vj.is, Vefang www.vj.is

HEITI VERKS:

HRAUNVALLASKÓLI
DREKAVÖLLUM 9
HAFNARFIRÐI

HEITI TEIKNINGAR:

RAFLAGNIR **LÁGSPENNUTEIKNINGAR**
LAMPA- OG RENNUPLAN 2. HÆÐ
2.-3. ÁFANGI

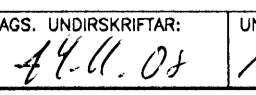MKV: 1:50 A1	VERKNR: 5401	SKRÁNINGARNR: ÖDNJ	ÓTGÁFA: REYND.T
HANNAÐ: 'OJS/SJ	TEIKNAD: IM	YFIRFARID: SJ	NR. TEIKNINGAR: E1-209
NAFN OG KT. SAMBYRGGJANDAR: MAGNÚS KRISTBERGSSON 080257 3689			BLAÐNÖMUR: 126
DAGS. UNDIRSKRIFTAR: 			UNDIRSKRIFT SAMBYRGGJANDAR: 