



DAGS	NR.	BREYTINGAR	SAÐP.
01.10.07		BLÁSARAR I BLÁGEYMSLU SETTIR A SÉRLOÐN	
01.10.07		LAGNASTÆÐUM BÆTT VÐ	

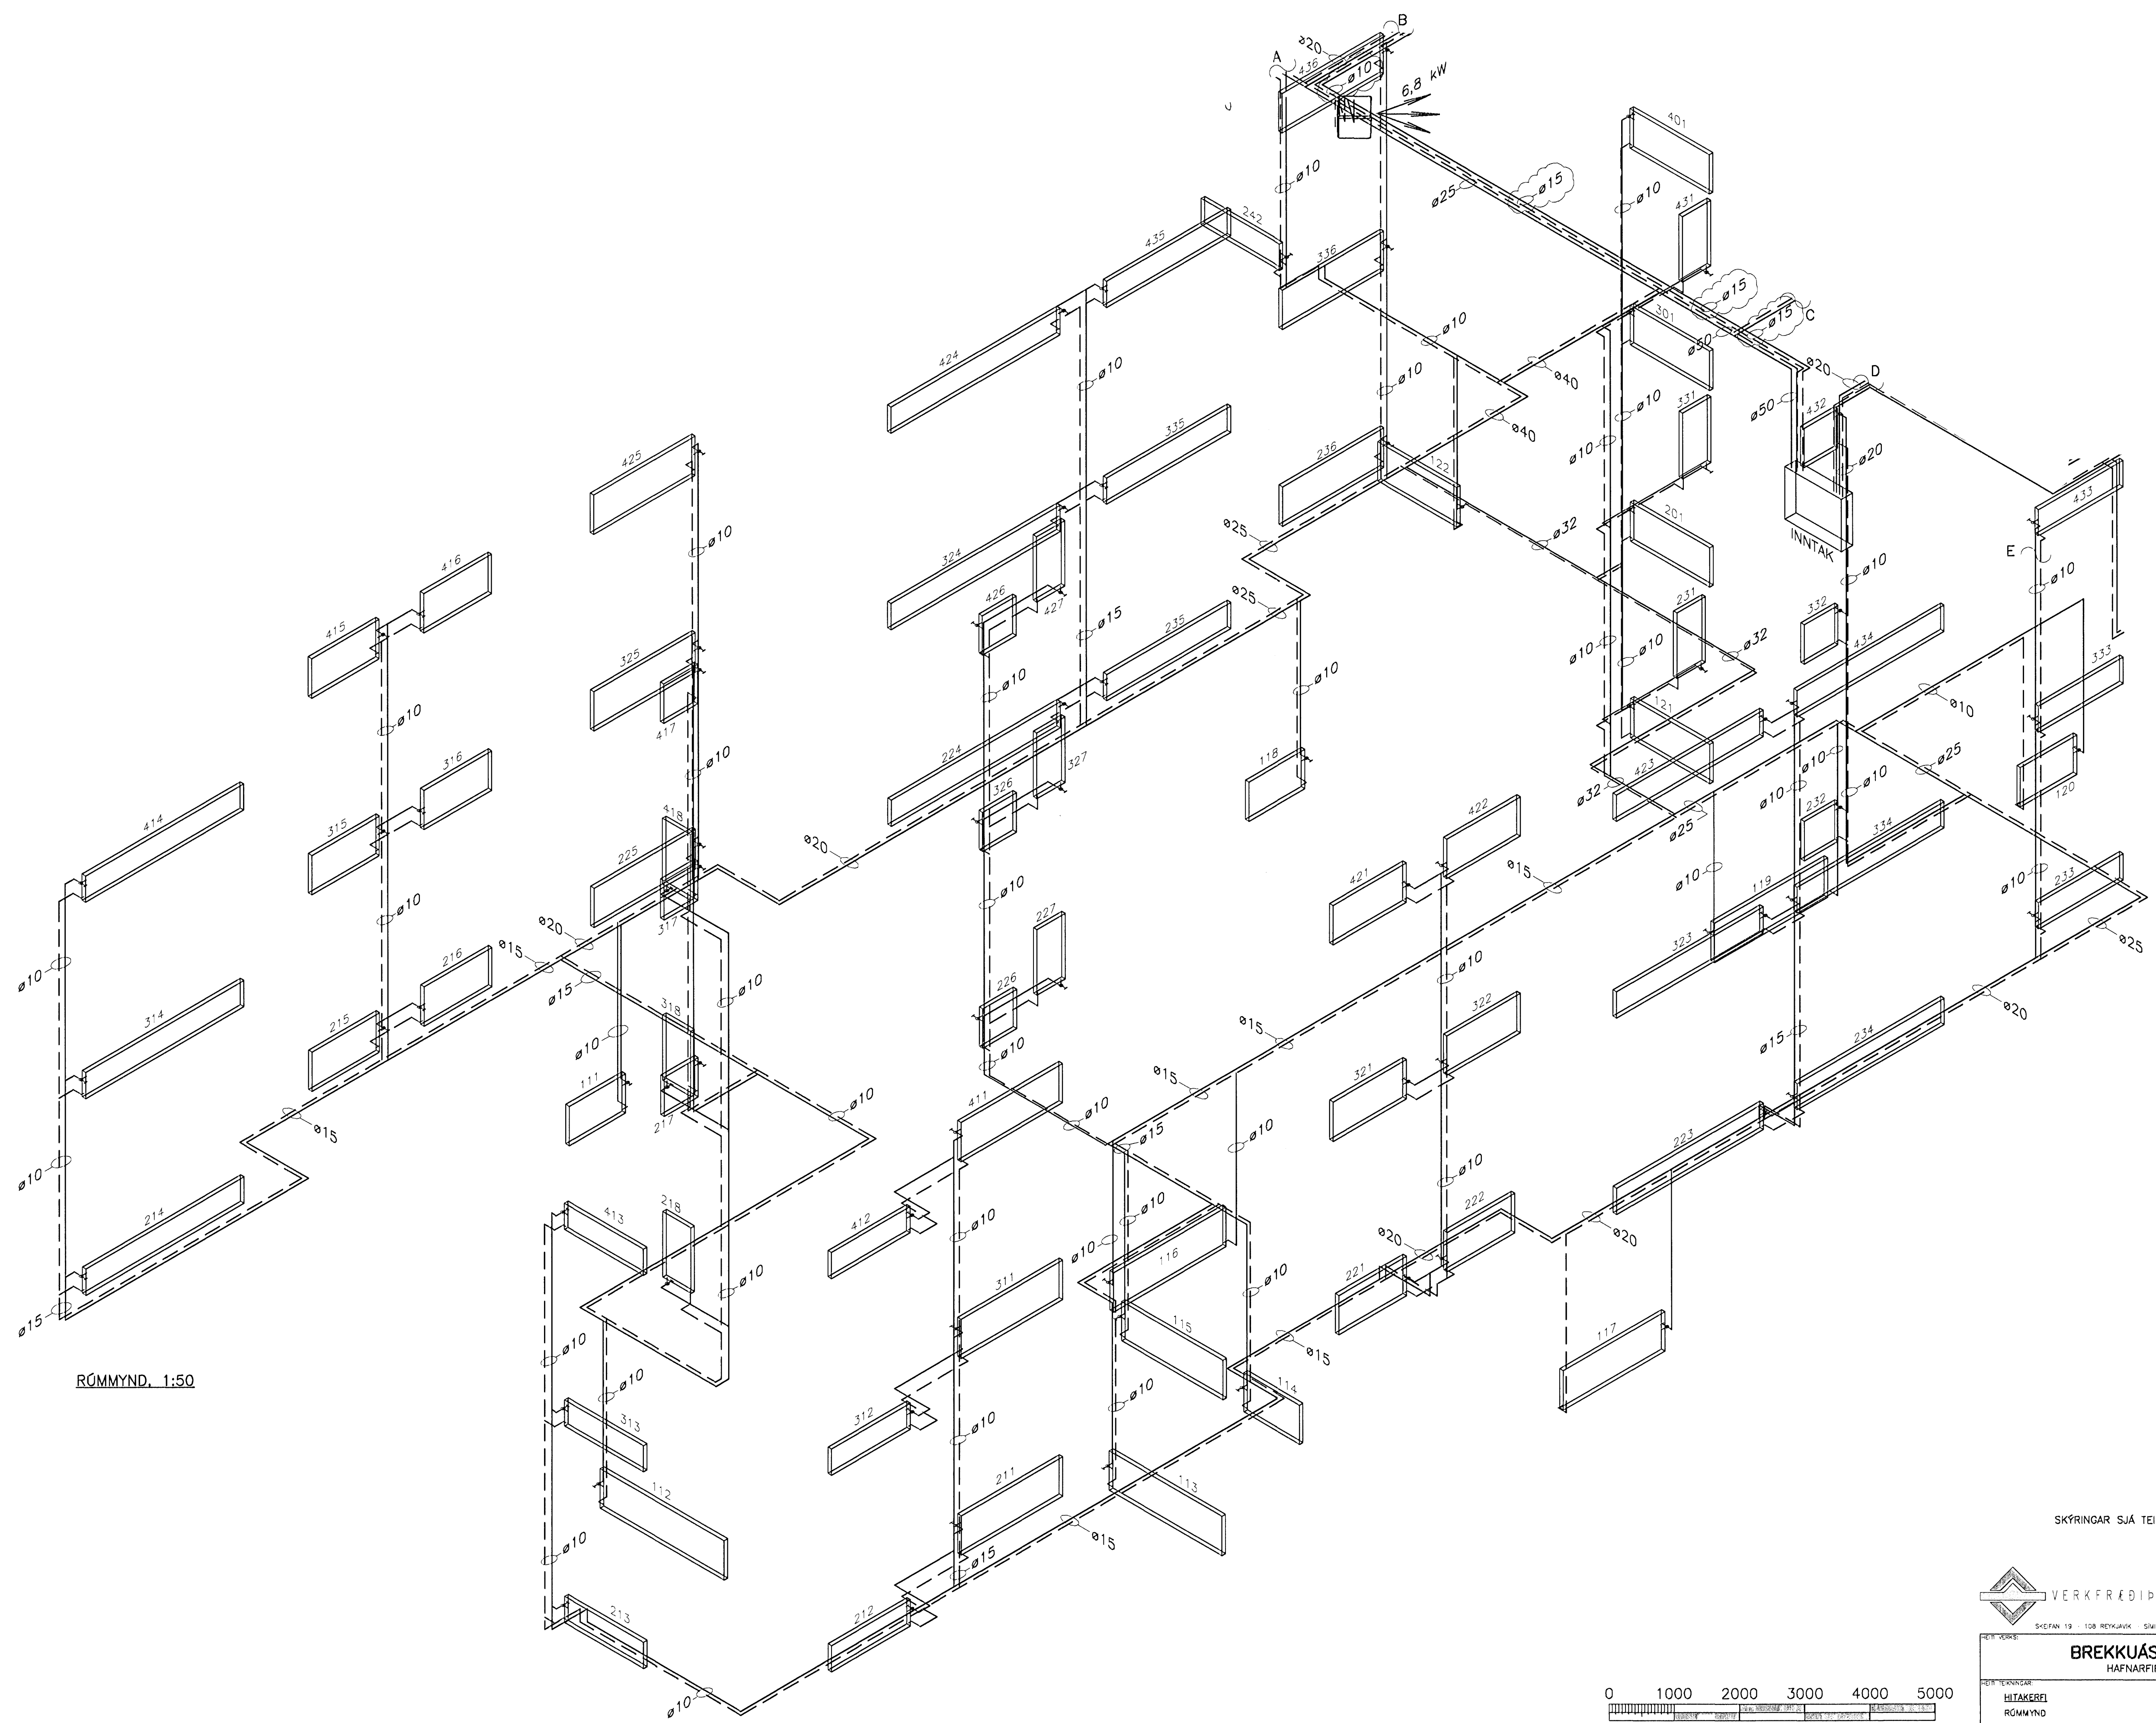

RÓMMYND, 1:50

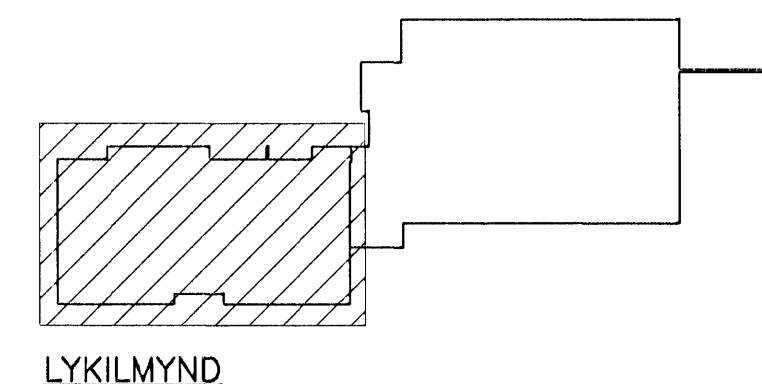


LYKILMYND

SKÝRINGAR SJÁ TEIKN. NR. 510

Móttaki: ISK  
Samb.: 14.2.08

VERKFRÉÐIÐJÓUSTAN EHF

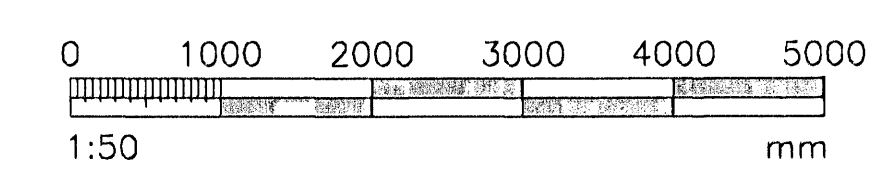

<b>BREKKUÁS 1-3</b>		HAFNARFIRÐI		
TEIKNINGAR	HITAKERFI	RÓMMYND		
PROF. GH	TEIKN. RR	VALD.	PROF. JG	
PROJEKTUR	07.01	DRÖG	30.03.07	
