
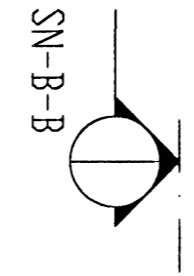
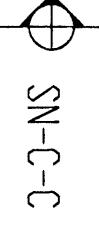
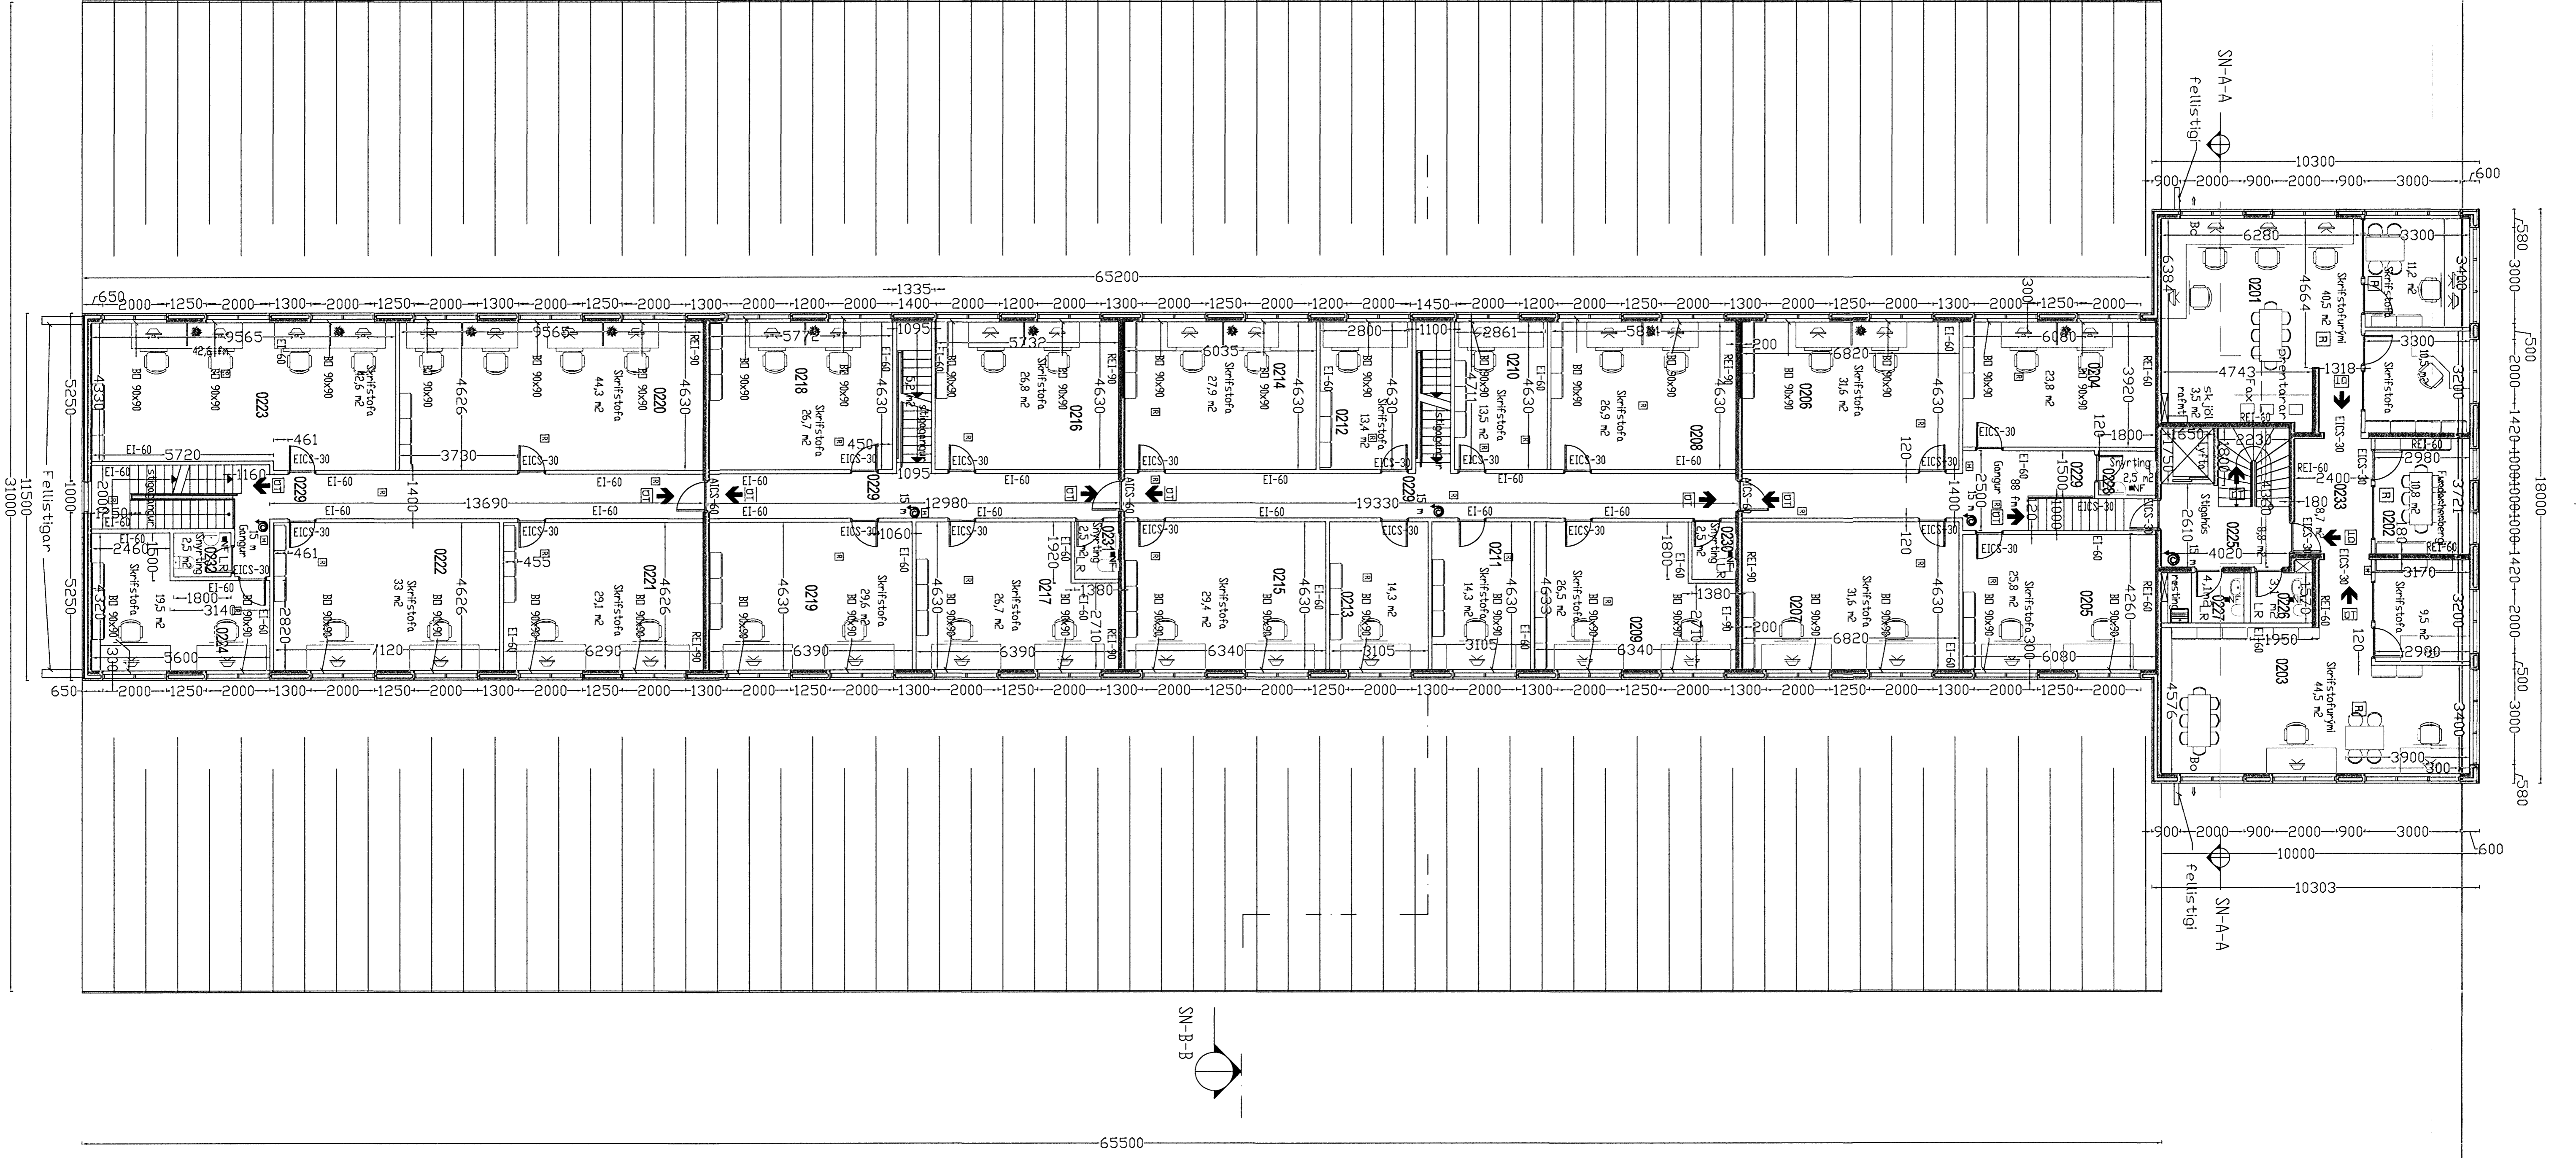


Samþykkt þann  
 12 FEB 2008  
 Pn. Jón Sigurðsson

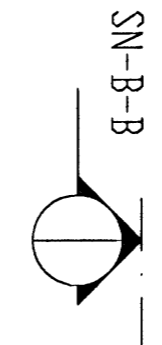

Sigurbjartur Halldórsson Lavakvæli 35, 110 Reykjavík	Klettar ehf Kl. 230658-3479 S. 8788022	Cuxhavengata 1, Hafnarfirdi	310108 1:100 Gísli Hermannsson	Reyndarteikningar Grunnmynd 2 hæð B104 05-1
---	--	-----------------------------	--------------------------------------	--