
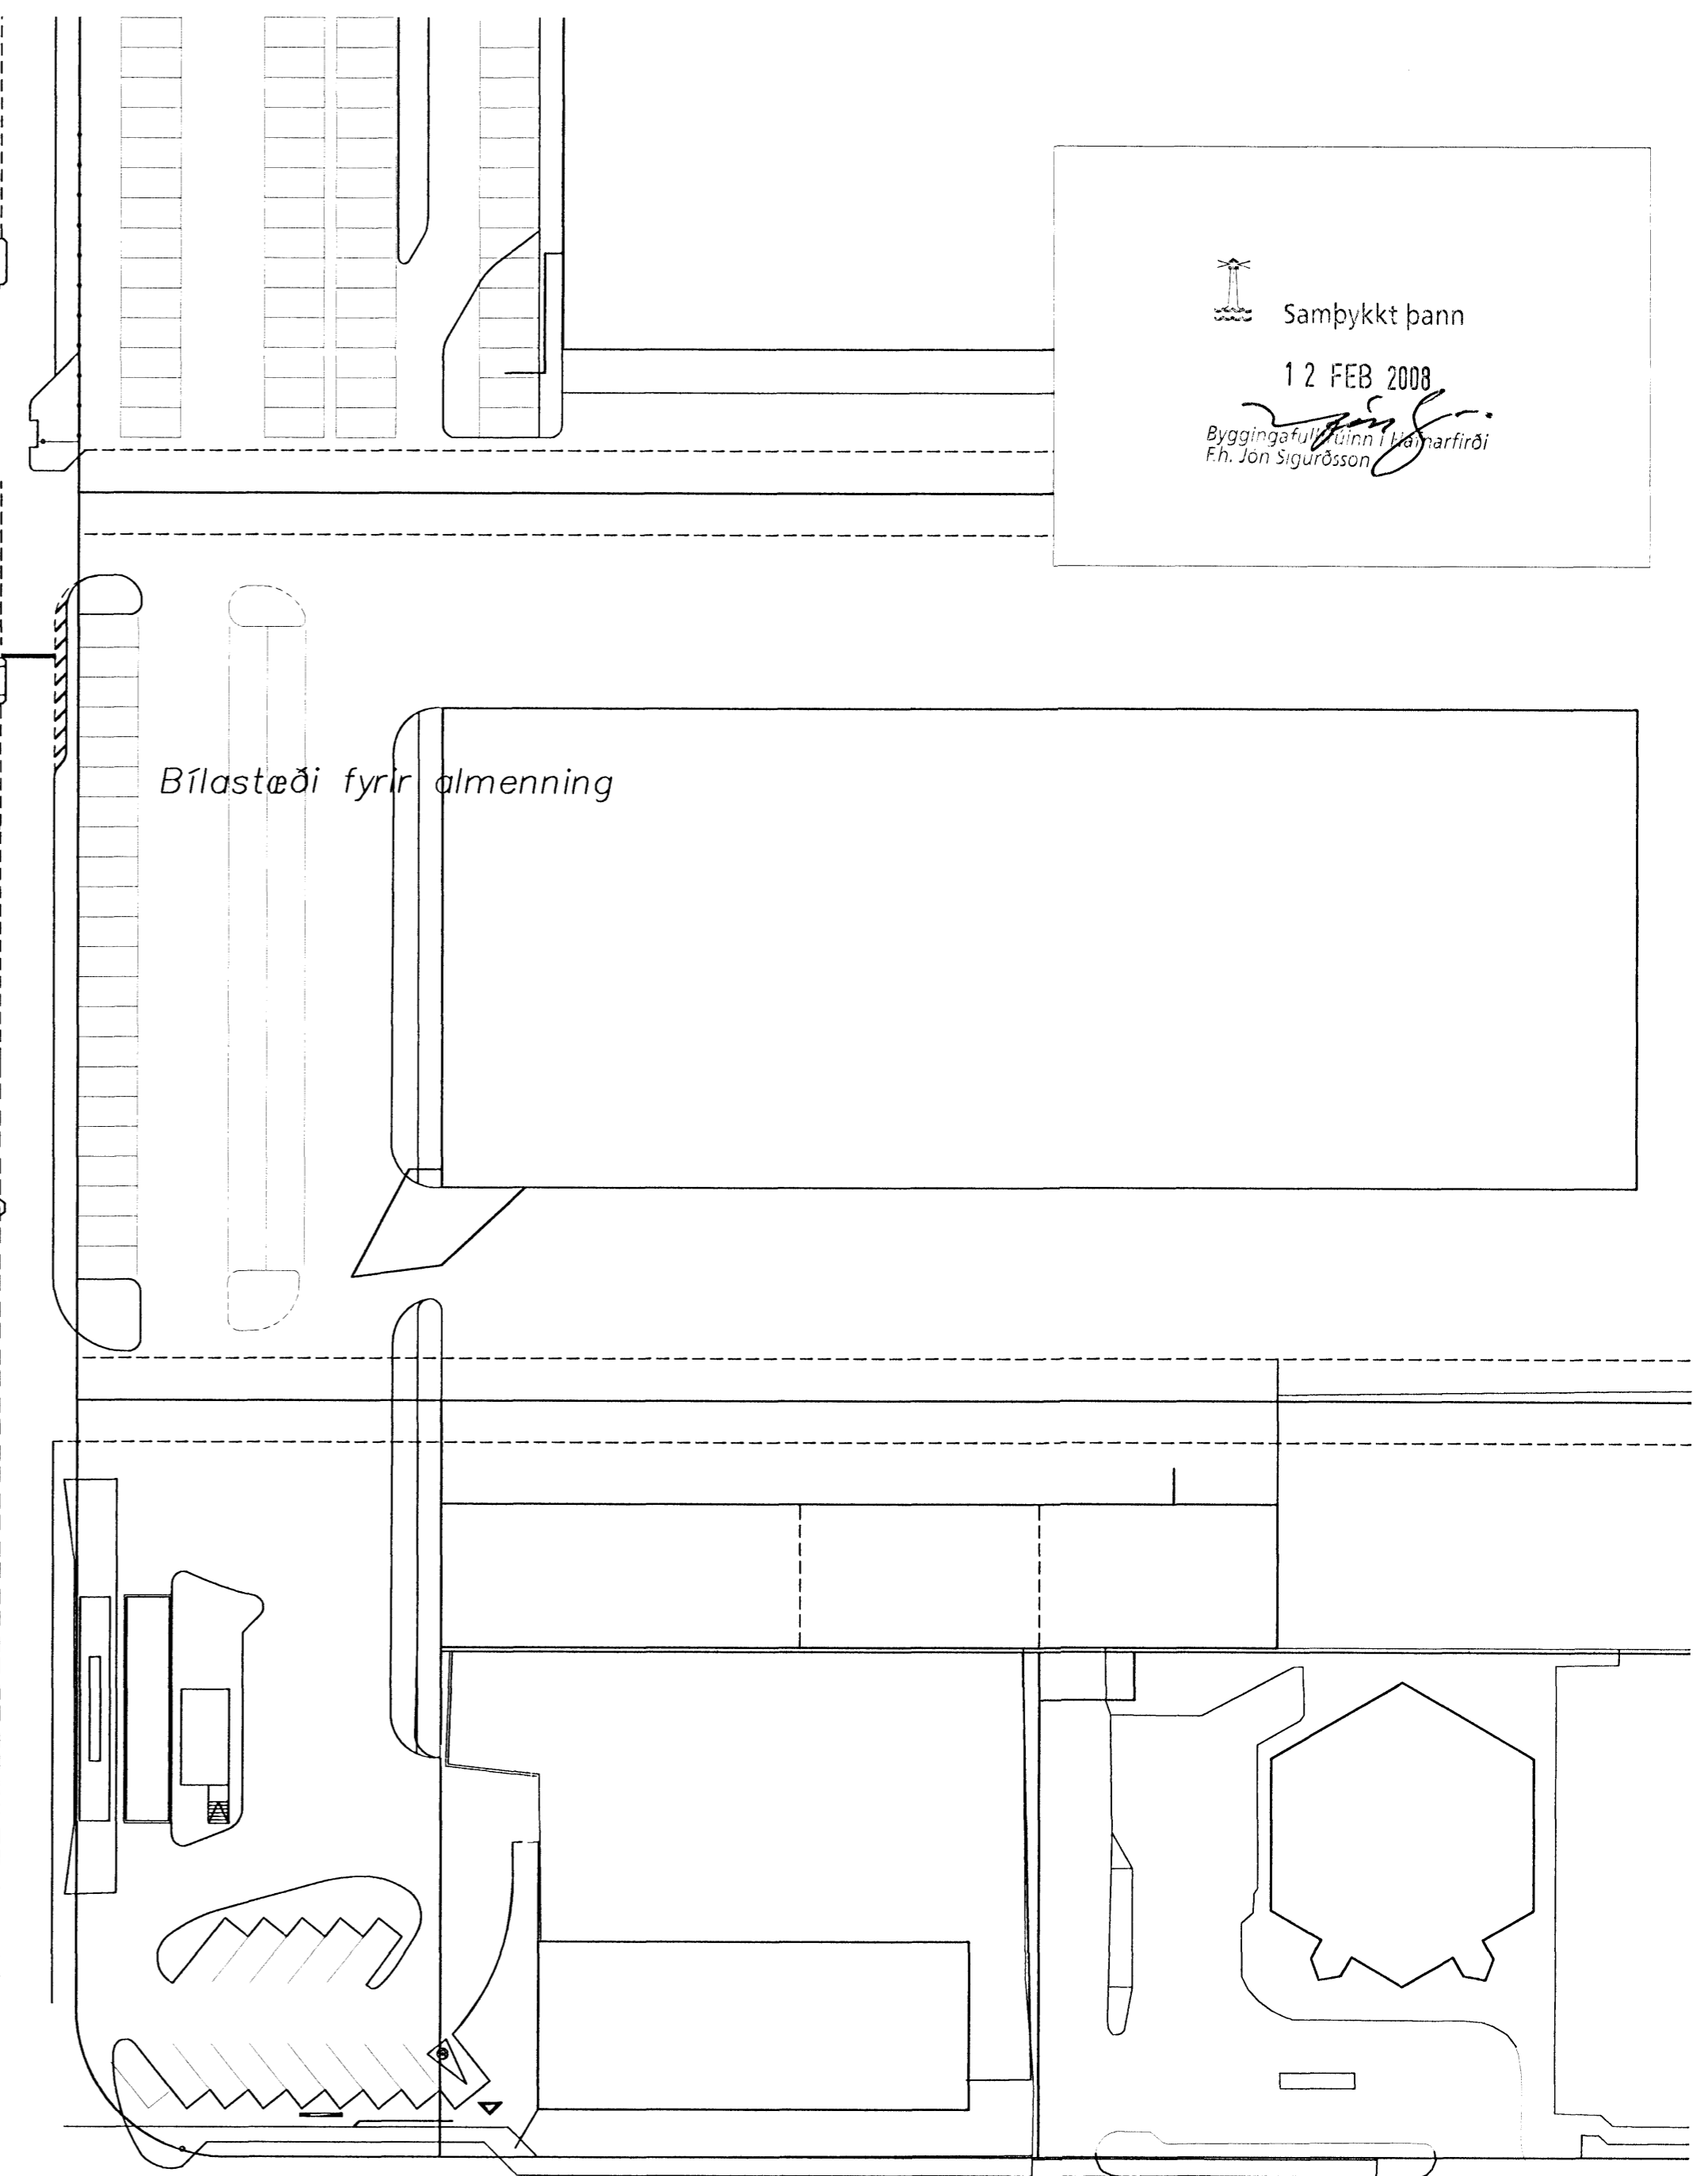


Samþykkt þann
12 FEB 2008
Byggingafulvinnur Hafnarfirði
Fh. Jon Sigurðsson

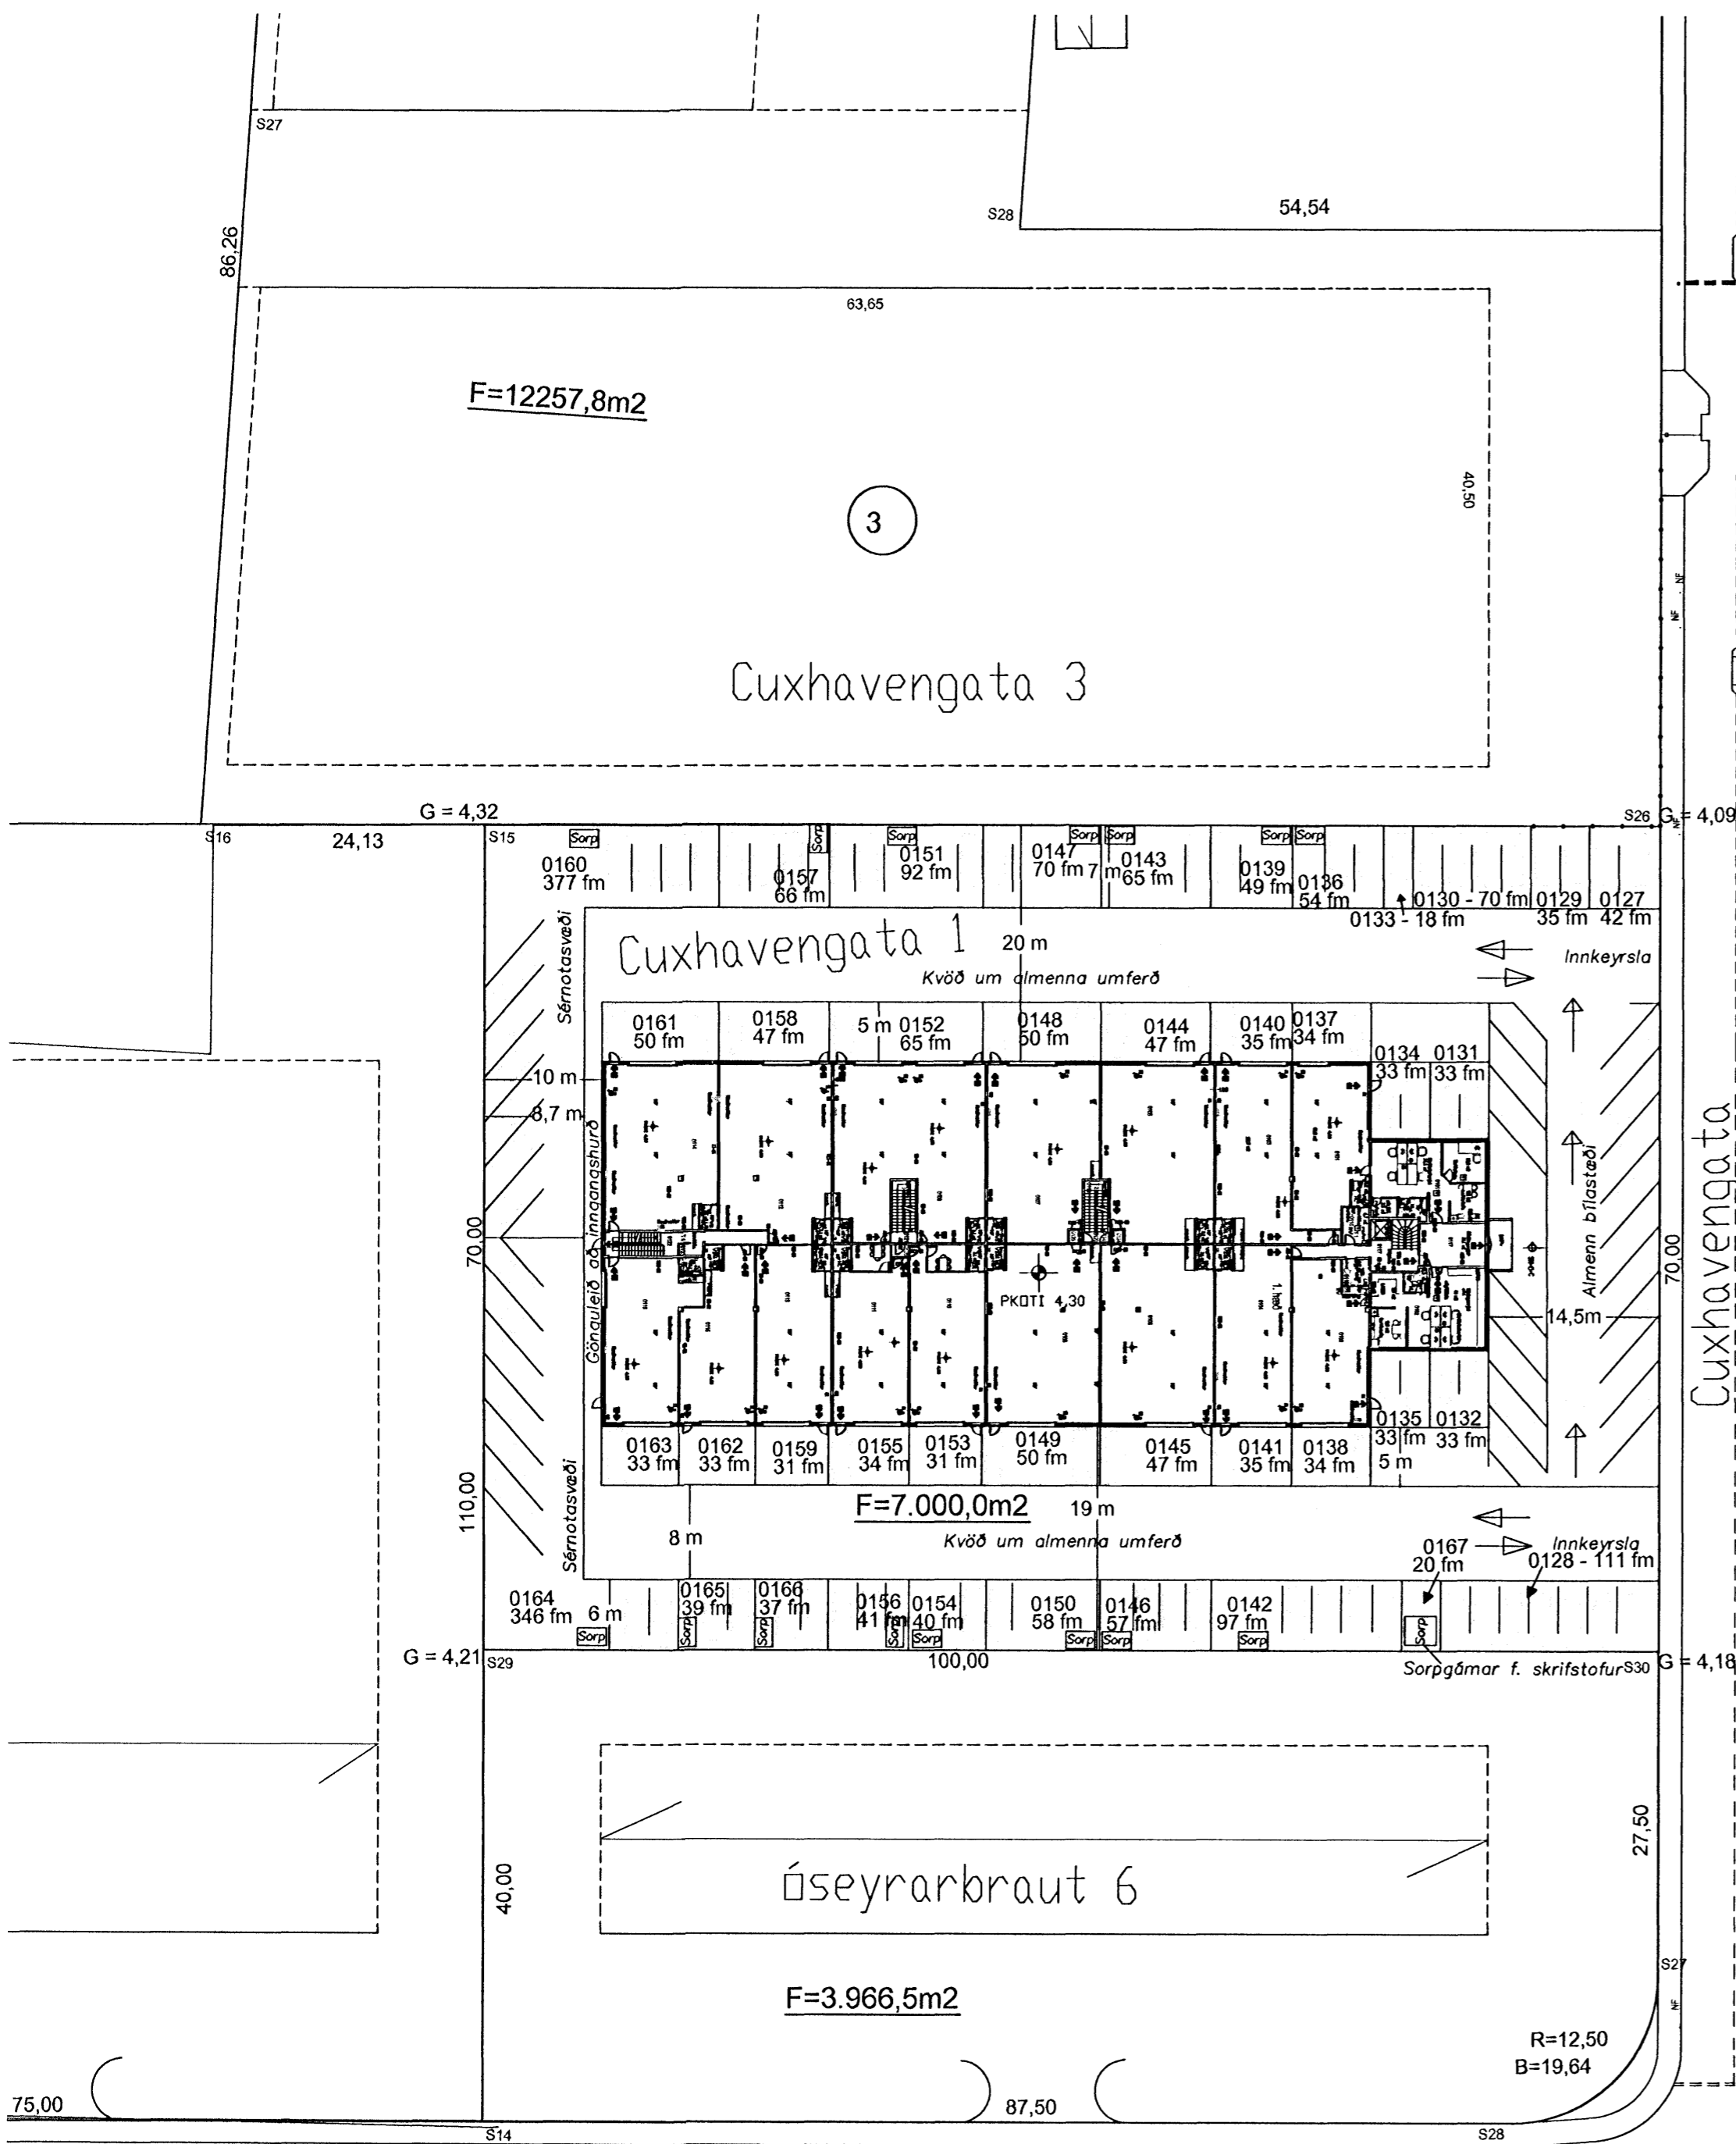

Óseyrarbraut

Byggingar	Verkmaður	Verkið
Sigurbjartur Halldórsson Laxakvæsi 35, 110 Reykjavík	Klettar ehf kt. 230656-3479 s: 8768022	Cuxhavengata 1, Hafnarfirði
Staður	Örugging	Skilning
Sigurbjartur Halldórsson	310108	Reyndarteikningar
Gísli Hermannsson	1:500	Afstöðumynd
Skjalnúmer	Skjalnúmer	Skjalnúmer
		B106
		05-1

St. Halld. 1/2 08