


C: 25.07.2005
 B: Sjó breytingaský 08.11.2004
 A: BREYTINGAR: 4.hæð breytt DAGS:

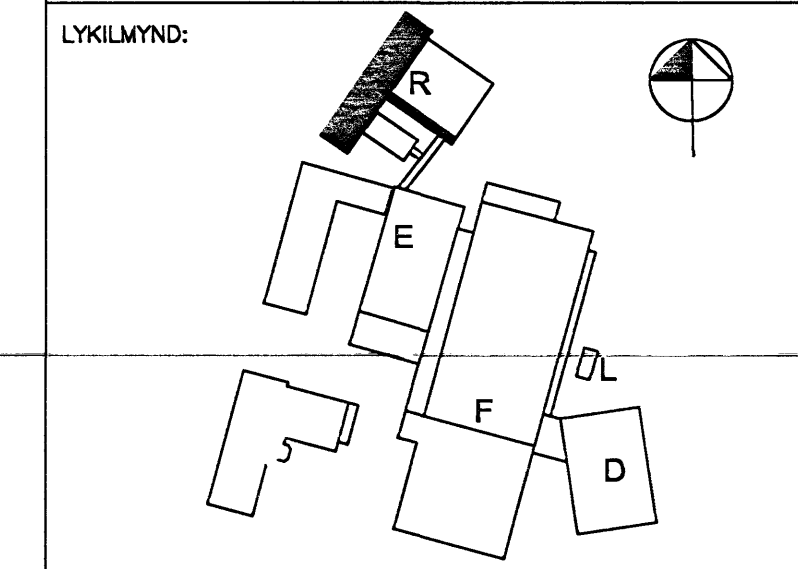

VERKKAUPLI:
actavis
 REYKJAVÍKURVEGUR 80.
 R-RANNSÓKNARHÍG

VERKTEIKNING
 4.HÆÐ
 VERK: 25.07.2005
 KVARDI: 1:50 TEIKNAD:
 SKRÁ: .DWG

ÚTI INNI
ARKITEKTAR
 ÞINGHOLTSTRÉTI 27 101 REYKJAVÍK
 Símar 5527660 & 5627660 Fax 5527661
 Netfang u@u.is
 Vefvang <http://www.u.is>
 Baldur G. Swannsson ARKITEKTAR FAI

26. JULÍ 2005

JÓN ÞÓR ÞORVALDSSON ARKITEKTAR FAI
 TEIKNINGARNR: **A-R-204** BREYTING: **A**