


12.11.2005

Slökkvilið höfuðborgarsvæðisins bs  
13.07.05 HC

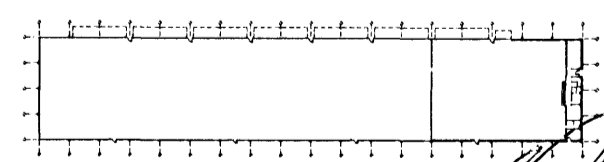

Skýringar:  
Explanations:

**ARK ÍS ehf**  
arkitektar ráðgjafar

Adalsteinn Snorrason arkitekt fali 161161-2769  
Egill Guðmundsson arkitekt fali 270152-6869  
Gísli Gíslason arkitekt fali 160657-4809  
Skólavörðustíg 11 101 Reykjavík  
sími 511 2060  
fax 511 2066  
netfang arkis@ark.is

Breyt. Rev.	Breyting Revision	Dagur Date	Samb. Approved	Notk. heiml. Released
A	Reyndartekning	08.06.05	hi	
2	Hæð húss lækkuð um 200mm /kóta breitt	09.12.03	hk	
1	Uppfarð útlit v/ breytinga	20.06.03	as	

Tilv. teikningar nr. ISAL Ref. drawing no. of ISAL

Samsetn. teikningar nr. ISAL Assembly drawing no. of ISAL

This drawing is the property of the Alcan Iceland Ltd. and handed out for personal use only. It may neither be copied nor made available to others without permission of the Alcan Iceland Ltd. The receiver is liable for any misuse.

Fjöldi stykja Number of pieces	Hlutur Object	Atriði Item	Efni Material	ea: stik Weight	total: í heild Þyngd	Athugasemdir Remarks
IV III II I	Mhl.01 Víkurgata 7 / ál-og tækjageymsla	Útlit	Ásýndir			
			ARKIS ehf			
			ALCAN PRIMARY METAL EUROPE			
			ISAL			
			IS-222 Hafnarfordur			

Stærð Formset 7510 12094  
Msk. Scale 1: 200  
Kostnaður - bsn. nr. / CChn. - Eq. no. 7510 12094  
AKS no. US33  
Töknur. nr. / Drawn of supply Breyt./Rev. (99)1.06 A  
Samb. / Approved  
Drönn. / Drawn ISAL / Tekn. nr. ISAL Breyt./Rev. 168521 A  
Notkun heiml. / Checked and filed Released