Format A1 (841x594 mm) is 20 mm outside of this frame

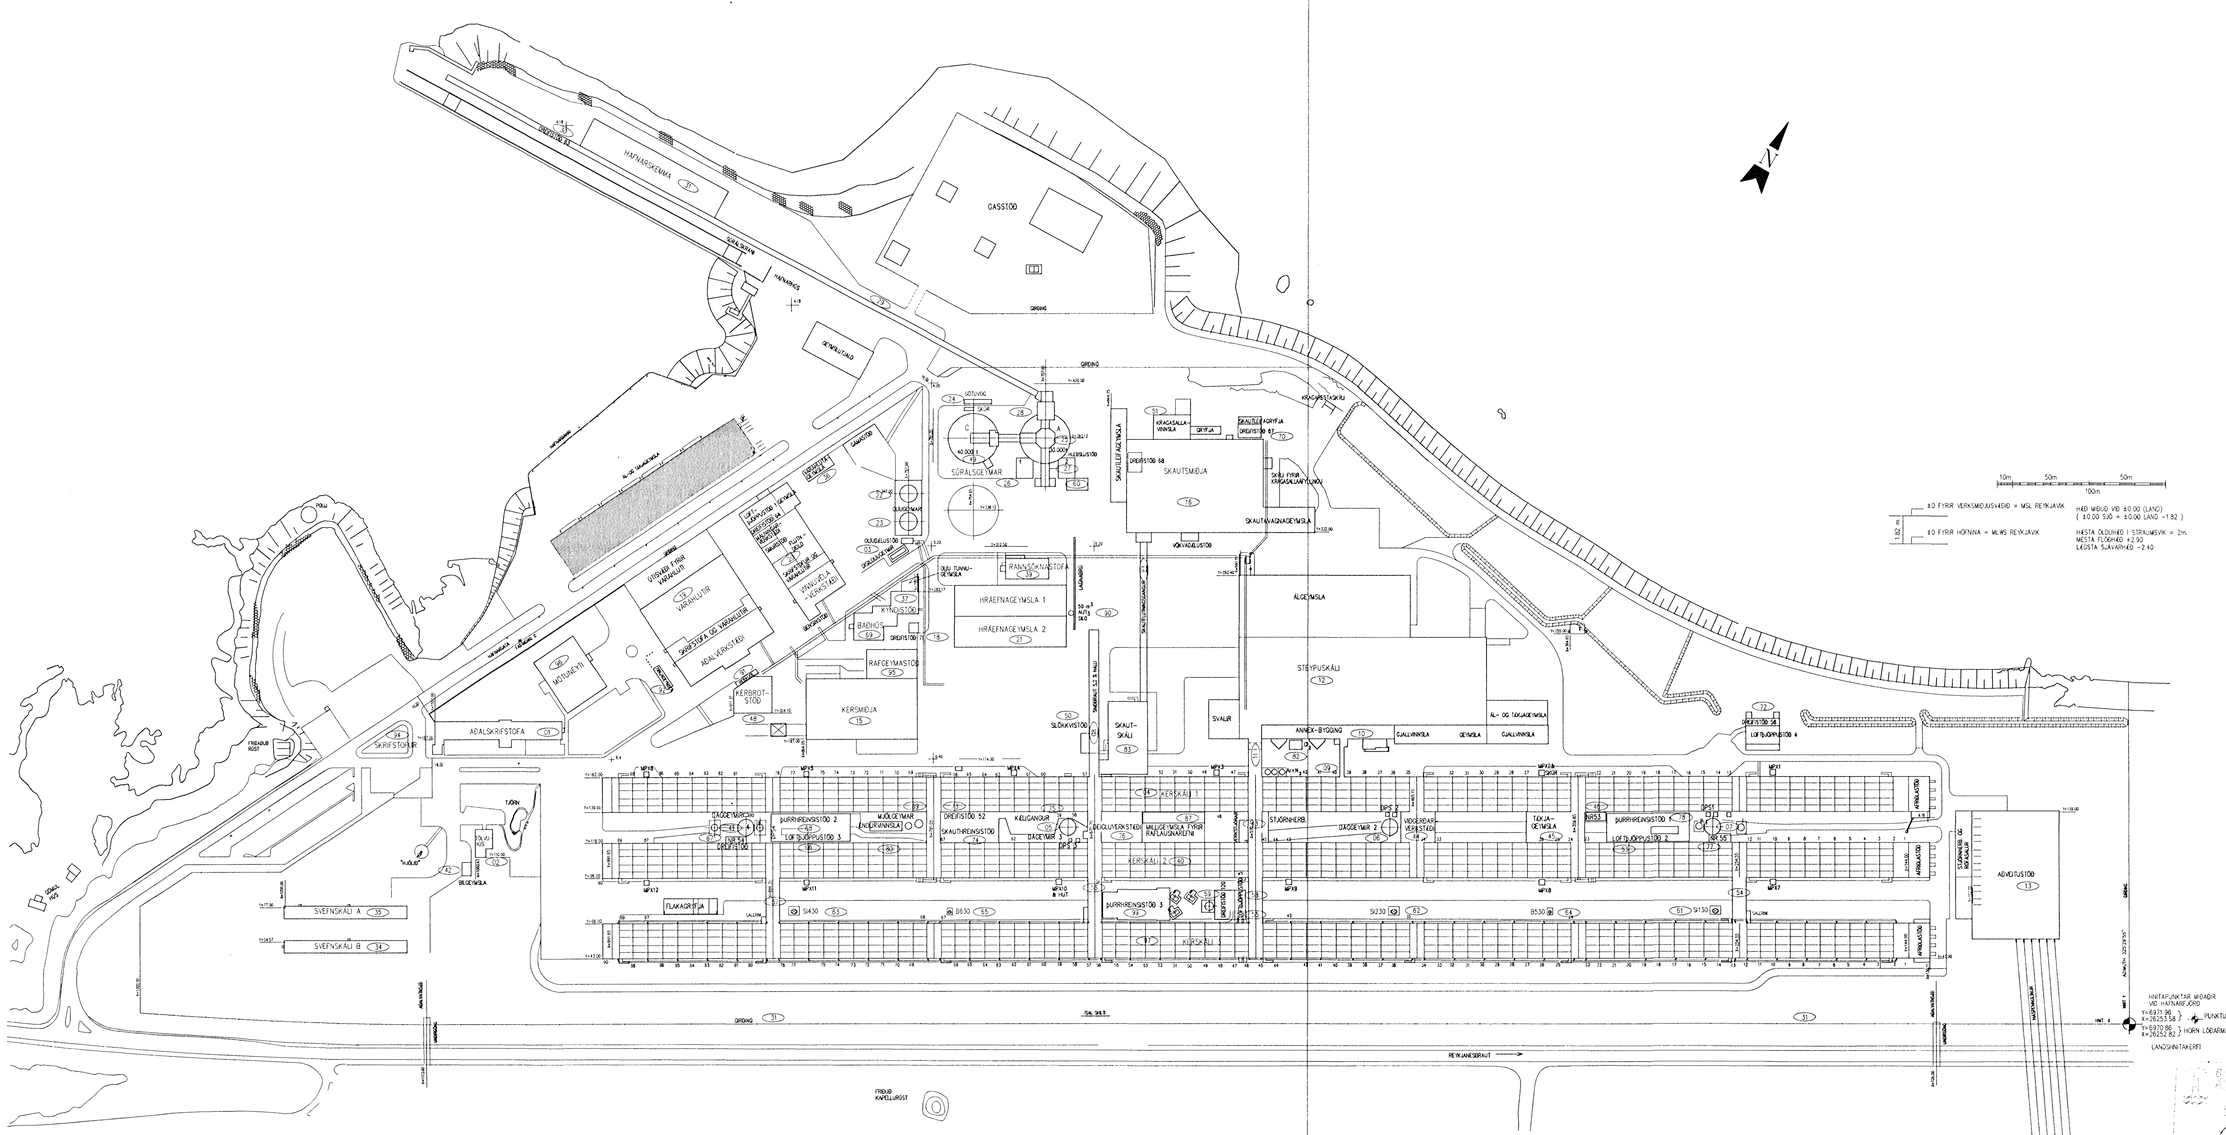

Skýringar:
Explanations:

ARK ÍS ehf

arkitektar	ráðgjafar
Aðalsteinn Snorrason	arkitekt faí 161161-2769
Egill Guðmundsson	arkitekt faí 270152-6869
Gísli Gíslason	arkitekt faí 160657-4809
Skólavörðustíg 11	101 reykjavík
sími	511 2060
fax	511 2066
netfang	arkis@ark.is

Breyt. Rev.	Breyting Revision	Dags. Date	Samþ. Approved	Notk. heimil. Released
A	Reyndarteikning	08.06.05	hi	
2	Hæð húss lækkuð um 200mm	09.12.03	hk	
1	Innsetning bílastæða.	20.06.03	as	

Tilv.teikningar nr. ISAL
Ref.drawing no. of ISAL

Samsetn.teikningar nr. ISAL
Assembly drawing no. of ISAL

This drawing is the property of the Alcan Iceland Ltd. and handed out for personal use only. It may neither be copied nor made available to others without permission of the Alcan Iceland Ltd. The receiver is liable for any misuse.

Fjöldi stykkja / Number of pieces: IV III II I

Hlutur / Object | Atriði / Item | Efni / Material | ea.; stk / Weight | total: í heild / (kg) Þyngd | Athugasemdir / Remarks

Mhl.01 Víkurgata 7 / ál-og tækjageymsla

Heildarafstöðumynd

Stærð / Format: A1 | Mkv. / Scale: 1: 2000

Kostn.nr.-búrn.nr. / CCno.-Eq.no.: 7510 12094

AKS no.: US33

Verktaki / Supplier: ARKÍS ehf

Teikn.nr. verkaka / Drw.no. of suppl.: (99)1.07 | Breyt./Rev.: A

Teiknað / Drawn: gg jg ms ee 25.03.03 | Yfirfarið / Checked: | Samþykkt / Approved: as

ALCAN PRIMARY METAL EUROPE
ISAL
Alcan Iceland Ltd
Straumsvík
IS-222 Hafnarfjörður

Drw.no. of ISAL / Teikn.nr. ISAL: 168522 | Breyt./Rev.: A

Teiknað / Drawn: | Yfirfarið og skráð / Checked and filed: | Notkun heimiluð / Released: