


Grunnmynd 2.hæð  
mkv. 1: 100

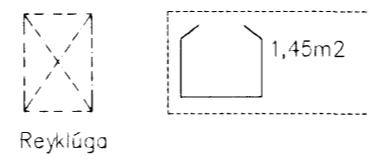

Skýringar:  
Explanations:

**ARK ÍS ehf**  
arkitektar ráðgjafar

Adalsteinn Snorason arkitekt fal 161161-2769  
Egill Guðmundsson arkitekt fal 270152-6869  
Gláfr Gíslason arkitekt fal 160657-4809  
Stólanavörðustíg 11 101 Reykjavík  
sími 511 2060  
fax 511 2066  
netfang arkis@arkis.is

Tilvit. Rev.	Revisión	Dagur Date	Stundir Sumb.	Staðir Approved	Notk. heimil Released
A	Reyndartekning	08.06.05	hi		
4	Glugga bæt inn í rými við skrifstofu	26.05.04	hk		
3	Reykilugar færðar til	27.02.04	hk		
2	Gluggar austurhlíð, málsetningar.	28.01.04	hk		
1	Hæð húss lækkuð um 200mm / kótum breytt	09.12.03	hk		

Tilvit. Ref. nr. ISAL / Ref-drawing no. of ISAL

Samsetn. teikningar nr. ISAL / Assembly drawing no. of ISAL

This drawing is the property of the Alcan Iceland Ltd. and handed out for personal use only. It may neither be copied nor made available to others without permission of the Alcan Iceland Ltd. The receiver is liable for any misuse.

Fjöldi stúkkja Number of pieces	Hlutur Object	Atriði Item	Efni Material	eo. stk Weight (kg)	Í heild Total	Alhugsemdir Remarks
IV III II I	Mhl.01 Víkurgata 7 / ál-og tækjageymsla					
	Grunnmynd 2. hæðar					
						Scale 1: 100
						AKS no. 7510 12094
						AKS no. US33
						Teknir. mál. / Drawn by: (99)3.03
						Samþykkt / Approved: OS
						Dr. no. of ISAL / Teknir. ISAL: 168529
						Notk. heimil / Released: A

2.11.2005