Format A1 (841x594 mm) is 20 mm outside of this frame

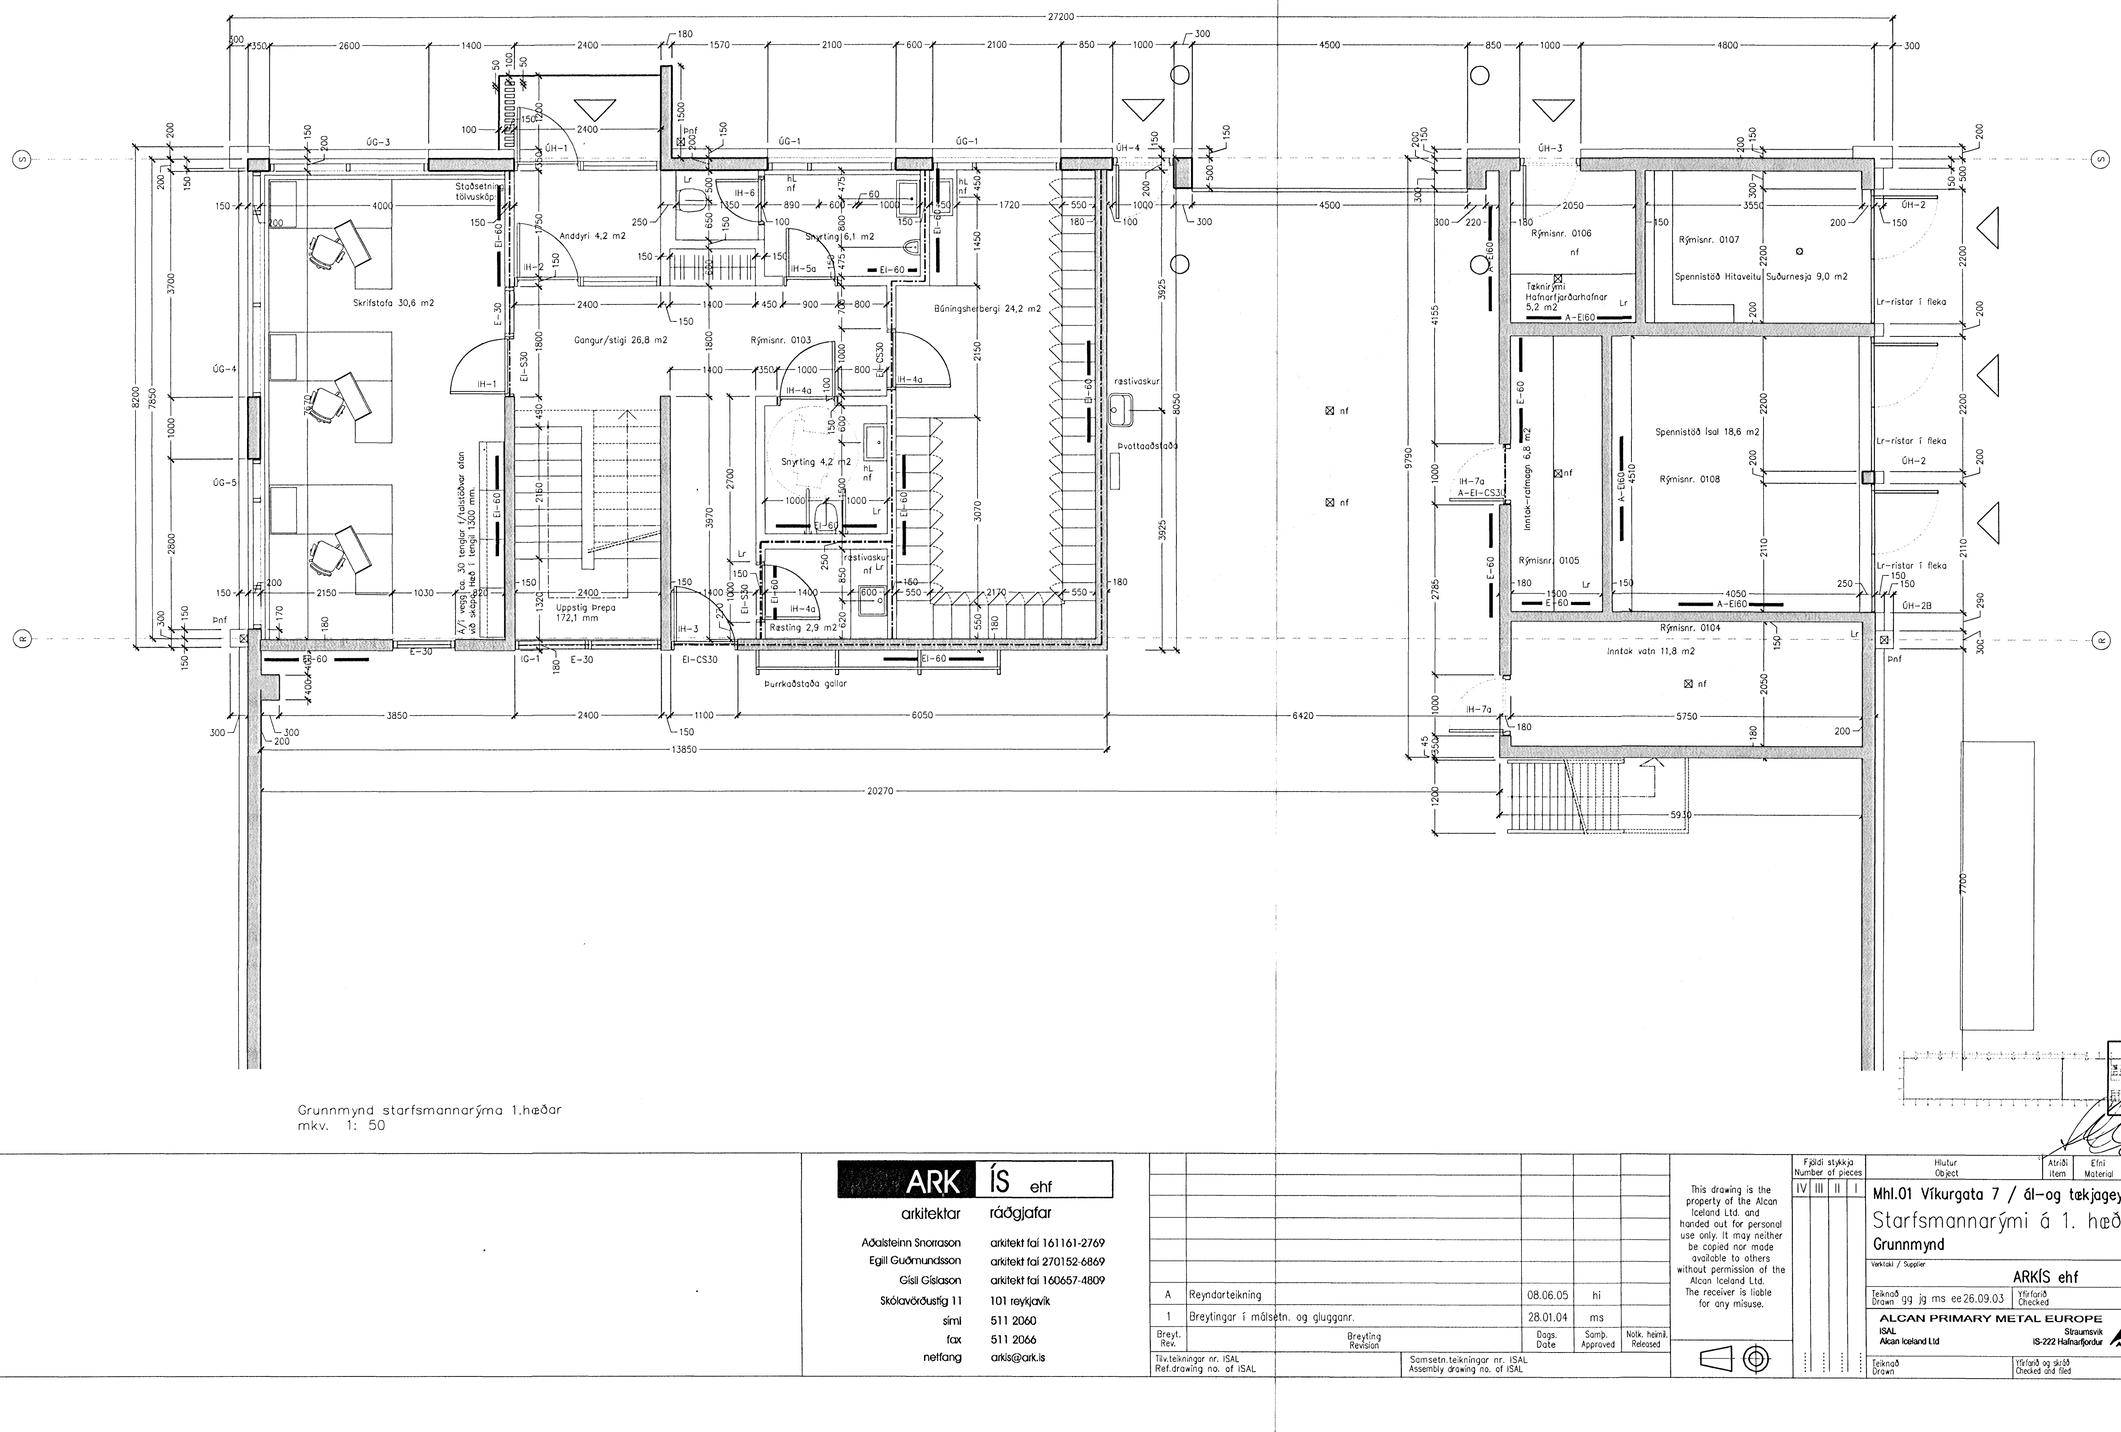

Grunnmynd starfsmannarýma 1.hæðar
mkv. 1: 50

Skýringar:
Explanations:

ARKÍS ehf

arkitektar	ráðgjafar
Aðalsteinn Snorrason	arkitekt fai 161161-2769
Egill Guðmundsson	arkitekt fai 270152-6869
Gísli Gíslason	arkitekt fai 160657-4809
Skólavörðustíg 11	101 reykjavík
sími	511 2060
fax	511 2066
netfang	arkis@ark.is

Rev.	Breyting Revision	Dags. Date	Samp. Approved	Nokk. heimil. Released
A	Reyndarteikning	08.06.05	hi	
1	Breytingar í málsetn. og gluggan.	28.01.04	ms	

Tilv.teikningar nr. ISAL / Ref.drawing no. of ISAL

Samsetn.teikningar nr. ISAL / Assembly drawing no. of ISAL

This drawing is the property of the Alcan Iceland Ltd. and handed out for personal use only. It may neither be copied nor made available to others without permission of the Alcan Iceland Ltd. The receiver is liable for any misuse.

Fjöldi stykkja / Number of pieces: IV III II I

Hlutur / Object | Atriði / Item | Efni / Material | ea.:stk / Weight | total: í heild (kg) / Pyngd | Athugasemdir / Remarks

Mhl.01 Víkurgata 7 / ál-og tækjageymsla

Starfsmannarými á 1. hæð.

Grunnmynd

Verktaki / Supplier: ARKÍS ehf

Teiknað / Drawn: gg jg ms ee 26.09.03 | Yfirfarið / Checked: as | Samþykkt / Approved: gs

ALCAN PRIMARY METAL EUROPE
ÍSAL / Alcan Iceland Ltd
Straumsvík IS-222 Hafnarfjörður

Teiknað / Drawn | Yfirfarið og skráð / Checked and filed | Nokkun heimiluð / Released

Stærð / Format: A1 | Mkv. / Scale: 1: 50

Kostn.nr.-Sún.nr. / CCNo.-Eq.no.: 7510 12094

AKS no.: US33

Teikn.nr. verktaka / Drw.no. of suppl.: (99)3.12 | Breyt./Rev.: A

Drw.no. of ÍSAL / Teikn.nr. ÍSAL: 168538 | Breyt./Rev.: A